

ADDENDUM #1 ADAMS COUNTY ADMINISTRATION BUILDING SITE AND BUILDING IMPROVEMENTS PROJECT 21993005 October 17, 2025

Page 1 of 3

NOTICE

This Addendum is issued to modify, explain or correct the original drawings, specifications and/or previous addendums and is hereby made a part of the Contract Documents. Please attach this Addendum to the specifications in your possession and note receipt of this Addendum on page 00 41 00-1 of the bid. The bid date remains unchanged.

PROJECT MANUAL

DIVISION 00 - PROCUREMENT AND CONTRACTING REQUIREMENTS

Section 00 73 00 - Supplementary General Conditions

OMIT items 11.1.5 and 11.1.6 in there entirety.

Note: The Owner will carry the Builders Risk Policy.

DIVISION 08 - OPENINGS

Section 08 34 55 Bullet Resistant Flush Wood Doors and Frames

2.01 MANUFACTURERS

ADD item D. as follows:

D. Chicago Bullet Proof Systems

2.02 MATERIALS, Item D.

REVISE Wood cut to be "Plain Sliced" vs. "Book Matched"

Section 08 71 00 - Door Hardware

3.05 SCHEDULE (H.S. = Hardware Set)

ADD hardware sets 6, 7 and 8 as follows:

<u>HS 6</u> (New replacement exterior door and frame with existing Access Control) 002A Existing to be reused:

3 butts

1 Lock

1 Closer

1 Electric Strike

Access control system NOTE: Maintain, reuse, relocate (if needed) and integrate existing access control devices and recommission.

ADMINISTRATION BUILDING SITE AND BUILDING IMPROVEMENTS ADAMS COUNTY

ADDENDUM #1 October 17, 2025 Page 2 of 3

New (match existing type)

1 Kick Plate

1 Threshold

Weatherstripping (seals & sweep)

<u>HS 7</u> – (Existing interior door/frame, access control, most hardware to remain with new delayed egress system) Delayed egress device/system All components, hardware, alterations and commissioning to function and integrate into the existing access control system and alarm system.

HS8 (Non-Bullet Resistant Doors with New Access Control)

3 butts BB1191 (Hager)

1 Lock L/LV9070 (Schlage)- Verify function with CA system

Closer 4040XP Spring Cush (LCN)

1 Kick Plate 190S, 12 inch

1 Electric Strike 6400 Series or equal (Von Duprin)

NOTE: New access control devices wired and provided and commissioned by the Owner Access Control Contractor. Electrician shall rough-in conduit and junction boxes for all access control devices.

OPERATIONAL DESCRIPTION: DOOR NORMALLY CLOSED AND LOCKED. FREE EGRESS ALLOWED AT ALL TIMES. OUTSIDE ACCESS BY CARD READER, WHICH WILL SHUNT THE ALARM AND UNLOCK ELECTRIC STRIKE

DIVISION 13 - SPECIAL CONSTRUCTION

SECTION 13 40 00 - BULLET-RESISTANT PROTECTION

2.01 MANUFACTURERS

ADD item C as follows:

"C. Chicago Bullet Proof Systems"

2.02 BULLET-RESISTANT FIBERGLASS WALL PANELS:

OMIT Items B.6, C., D., and E.

ADD item C. as follows:

- "C. BULLET-RESISTANT TRANSACTION WINDOW:
- 1. Shall be 3-sided extruded aluminum, clear or dark bronze anodized finish, prime painted 16 gauge steel, with UL-4 rating, non-ricochet natural voice frame with U.L. rated fiberglass frame liner.
- 2. Glazing shall be 1.31 inch thick, UL-4 rated, glass/polycarbonate composite, Armotex Product Code GCP 400.
- 3. 12 inch wide 16 gauge stainless steel dip tray, SS #3 finish, Armotex Model #RMDT-1012."

DIVISION 22 - PLUMBING PERFORMANCE SPECIFICATIONS

REVISE Tank type toilet fixtures to floor mounted flush valve type (similar type to the existing but ADA height).

ADMINISTRATION BUILDING SITE AND BUILDING IMPROVEMENTS ADAMS COUNTY

ADDENDUM #1 October 17, 2025 Page 3 of 3

DIVISION 23, 24, 25 - HEATING, VENTILATING, AND AIR CONDITIONING (HVAC) PERFORMANCE SPECIFICATIONS

REVISE to convey that at existing ceiling replacement area the existing HVAC ceiling grilles and diffusers may be cleaned and reused.

DIVISION 32 - EXTERIOR IMPROVEMENTS

Section 32 17 23 PAVEMENT MARKING

REPLACE Paragraph 2.01, A. with the following:

"2.01 WATERBORNE PAINT

A. Furnish paint from the State of Wisconsin, Department of Transportation's approved product list http://wisconsindot.gov/pages/doing-bus/eng-consultants/cnslt-rsrces/tools/appr-prod/default.aspx."

DRAWINGS

REPLACE: SHEETS C106, C107 AND C108 in their entirety with attached marked "Addendum #1".

General Topic: Revision of the pavement markings to waterborne.


REPLACE: SHEETS T101, A0D101, A0D102, A101, A102, A103, A104, A108, A201, A601 and A602 in their


entirety with attached marked "Addendum #1".


General Topics (see drawing for added items):

- Courthouse
 - o Exit Sign Clarifications/Revisions.
 - o Replacement of egress Door 002A with wider door and associates wall remodel.
 - o Wall opening at south exit door will no longer be infilled with CMU. Door C103 will remain with hardware revision with an added delayed egress system.
 - o Added Corridor Door C102 and associate added wall.
- Administration Area
 - Clarified retrofit wall for BR panel keeps the existing wall construction facing the staff side.
 - Toilet Room A041, the proposed toilet orientation changed to match the existing orientation to simplify the required work.
 - o Tunnel Security Alteration: Revised to just remove door and infill masonry opening vs. installing a new wall.
 - Conf Rm A160 the new south is omitted, and the existing south wall will be remodeled.
 - o IT Room A142, relocate Mini-Split unit to the new south exterior wall.

FND OF ADDENDUM

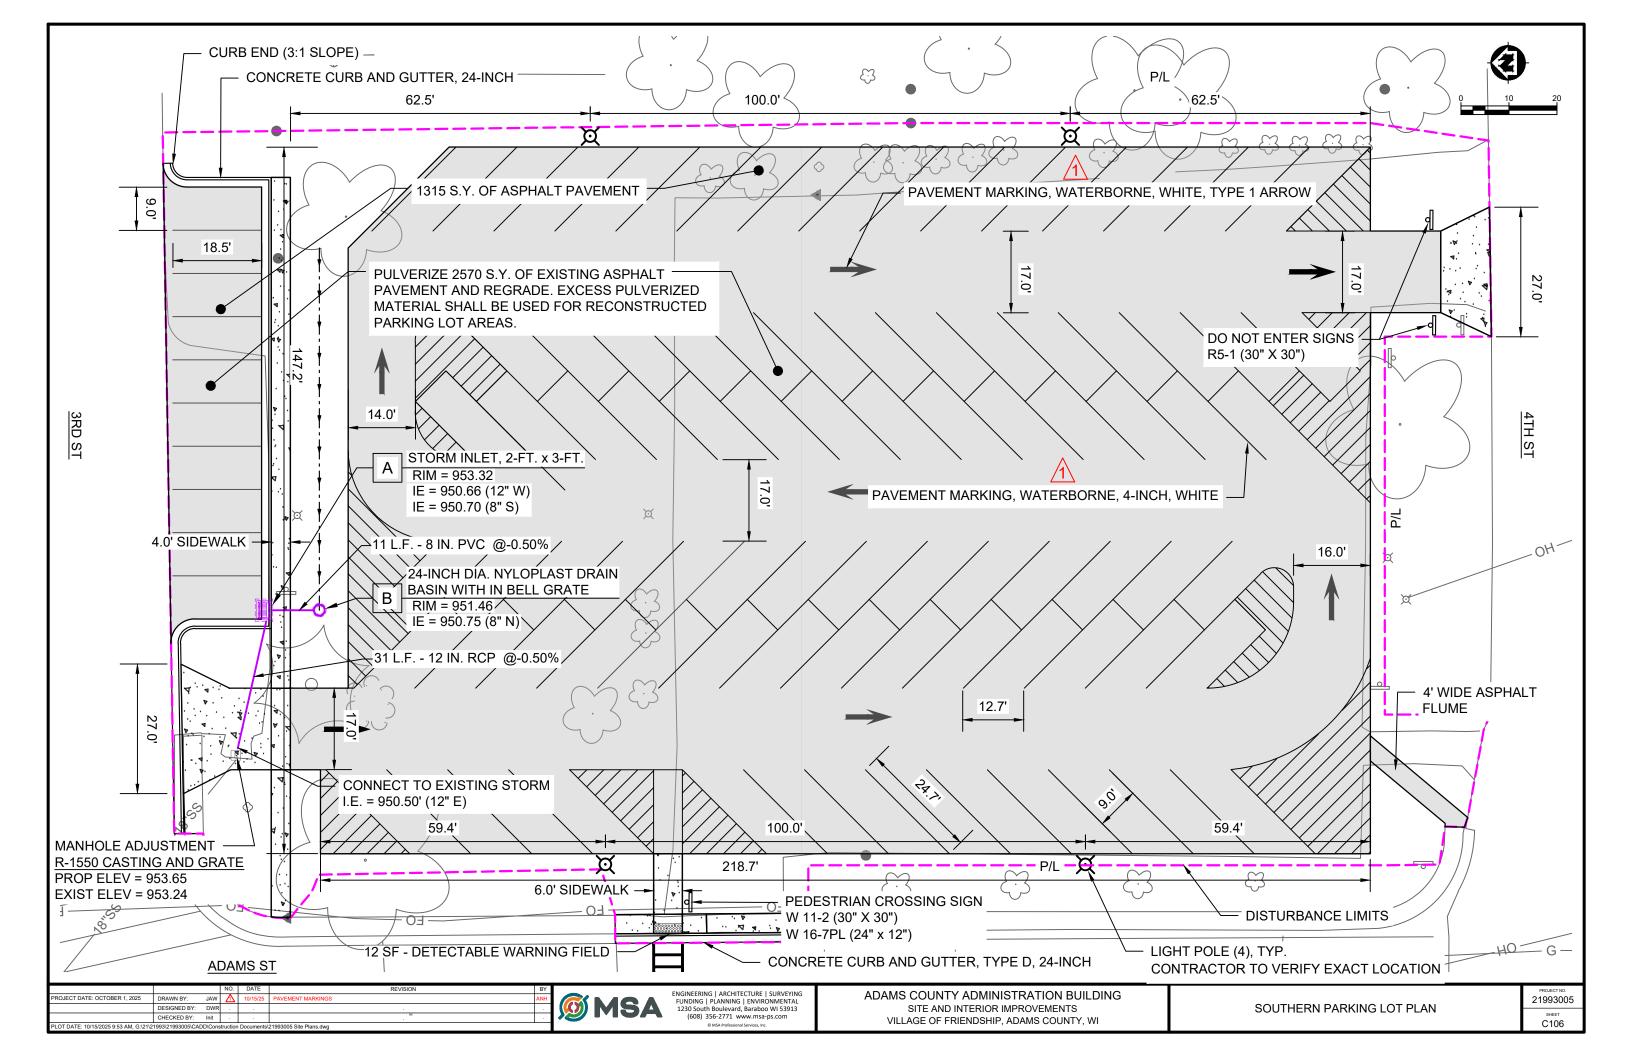

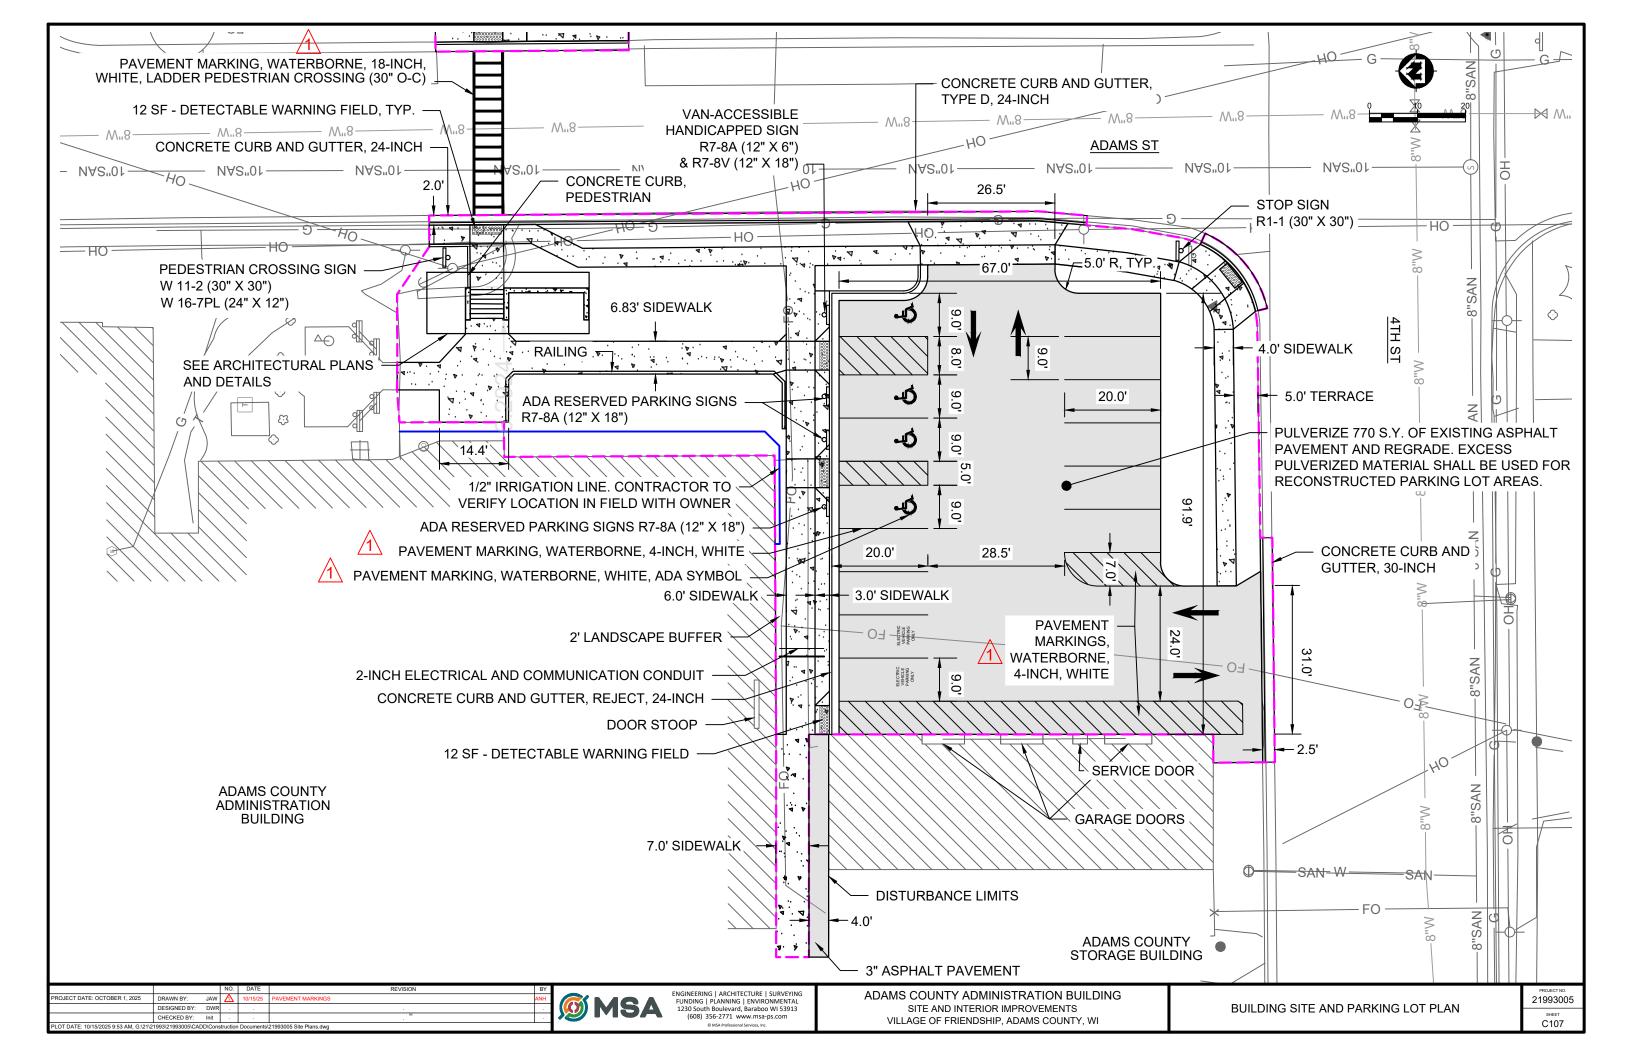

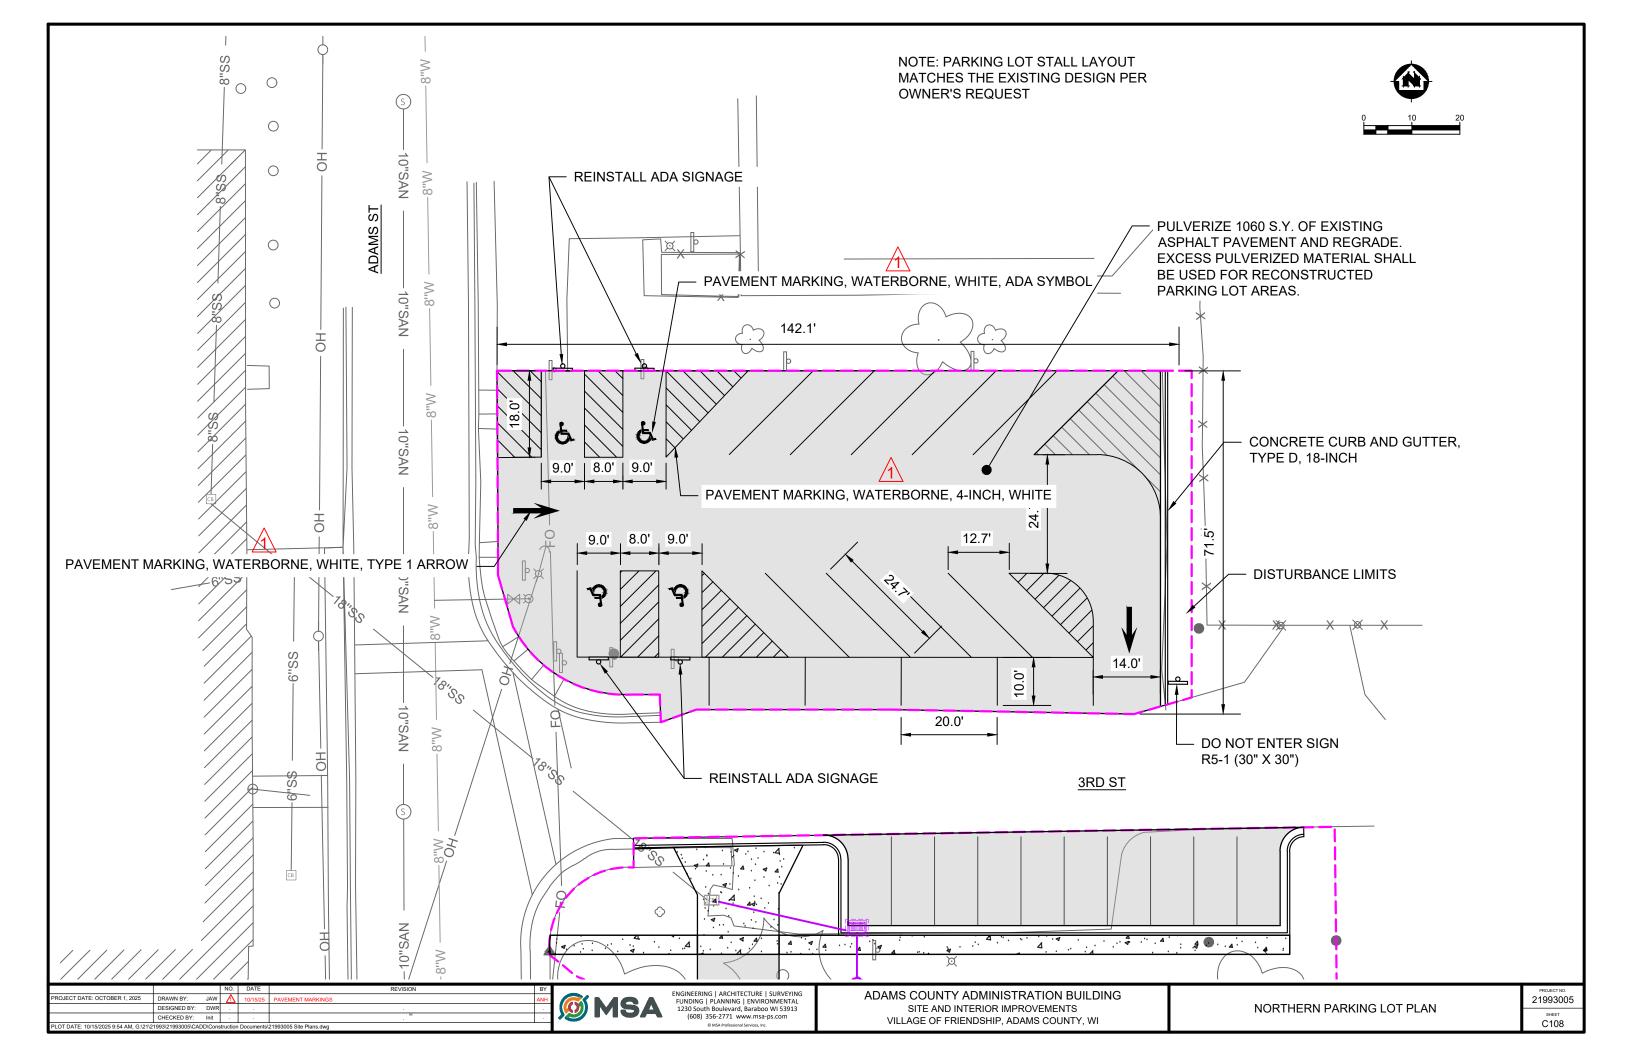

ADAMS COUNTY ADMINISTRATION BUILDING SITE AND INTERIOR IMPROVEMENTS


OWNER:

ADAMS COUNTY 401 Adams Street. Friendship, WI 53934

ARCHITECT/ CIVIL/ STRUCTURAL ENGINEER:

MSA PROFESSIONAL SERVICES, INC. 1230 SOUTH BLVD BARABOO, WI 53913 PH: 608-356-2771 FAX: 608-356-2770

PROJECT LOCATION:

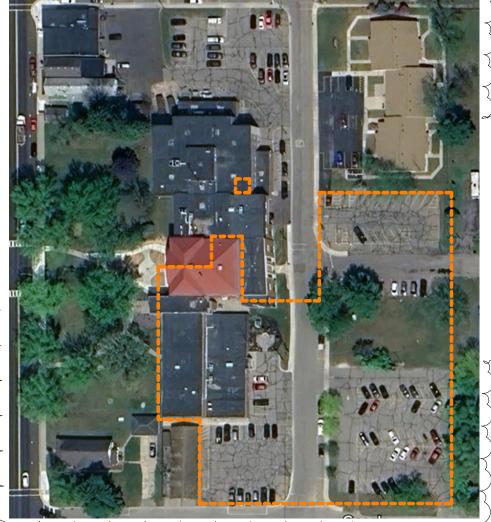

INDEX:

GENERAL

T101	TITLE SHEET	A0D101	DEMOLITION - FLOOR PLAN - GROUND LEVEL
T102	SYMBOLS AND ACCESSIBILITY STANDARDS	A0D102	DEMOLITION- FLOOR PLAN -MAIN LEVEL
CIVIL		A0D103	DEMOLITION - ARCHITECTURE DETAILS
	_	A0D104	DEMOLITION - ARCHITECTURE DETAILS
		A0D105	DEMOLITION - ARCHITECTURE DETAILS
		A101	FLOOR PLAN - GROUND LEVEL OVERALL
		A102	FLOOR PLAN - GROUND LEVEL
		A103	FLOOR PLAN - MAIN LEVEL OVERALL
		A104	FLOOR PLAN - MAIN LEVEL
		A105	REFLECTED CEILING PLAN - GROUND LEVEL
	BUILDING AND SITE PARKING LOT PLAN	A106	REFLECTED CEILING PLAN - MAIN LEVEL
	IORTHERN PARKING LOT PLAN	A107	FLOOR FINISH PLAN - GROUND LEVEL
	OVERALL GRADING PLAN	A108	FLOOR FINISH PLAN - MAIN LEVEL
	ASTERN PARKING LOT GRADING PLAN	A109	ENTRANCE SITE PLAN
	BUILDING GRADING PLAN	A110	ENTRANCE LANDSCAPE PLAN
	CROSSWALK LAYOUT PLAN	A201	INTERIOR ELEVATIONS
	VESTERN PARKING LOT GRADING PLAN	A202	INTERIOR ELEVATIONS
	IORTHERN PARKING LOT GRADING PLAN	A301	WALL TYPES
	ROSION CONTROL DETAILS	A501	ARCHITECTURAL DESK DETAILS
	TANDARD DETAILS	A502	ARCHITECTURAL DETAILS
		A503	ARCHITECTURAL ENTRANCE DETAILS
		A504	ARCHITECTURAL DETAILS
		A601	DOOR AND WINDOW SCHEDULE
		A602	FINISH SCHEDULE
	STANDARD DETAILS		
C508 S	STANDARD DETAILS		

ARCHITECTURAL

BUILDING INFORMATION:

EXISTING BUILDING AREA

ELVEL E NEMODELINO NO MONTO NEL CO.										
	GROUND FLOOR			FIR	FIRST FLOOR SECO					TOTAL BLDG.
	WORK AREA	TOTAL FLOOR AREA	%	WORK AREA	TOTAL FLOOR AREA	%	WORK AREA	TOTAL FLOOR AREA	%	% WORK AREA
SOUTH ADMIN. BUILDING	1,502 SF	6,350 SF	24	8,870 SF	12,426 SF	71	0 SF	6,060 SF	0	42
COURTHOUSE	671 SF	7,165 SF	9	25 SF	7,309 SF	1	0 SF	7,309 SF	0	3
LAW ENFORCEMENT	10 SF	16,468 SF	0	0 SF	14,592 SF	0	0 SF	11,563 SF	0	0

BUILDING VOLUME:

SOUTH ADMIN. BLDG.

C509 STANDARD DETAILS

COURTHOUSE
LAW ENFORCEMENT CENTER SOUTH ADMIN. BLDG.

COURTHOUSE LAW ENFORCEMENT CENTER OCCUPANCIES (MAIN INDICATED): SOUTH ADMIN. BLDG COURTHOUSE

EXISTING FIRE ALARM & SMOKE DETECTION SYSTEM

OVER 50,000 CF

B-BUSSINESS, S-1 STORAGE (ACCESSORY) B-BUSSINESS, S-1 STORAGE (ACCESSORY), A-3-ASSEMBLY (2ND FLOOR)

STRUCTURAL ARCHITECTURE CIVIL/SITE DANIEL W. RAMMER

ABBREVIATIONS.

RR	REVIATIONS	:
	ANCHOR BOLT	LVL
DL	AIR CONDITIONER	LAV
JL J	ADDITIONAL ADJACENT	MAT'I
-	ABOVE FINISHED FLOOR	MBS
GR	AGGREGATE	MECH
-	ALTERNATE	MFR
JM	ALUMINUM	MIN
PROX	APPROXIMATE(LY)	MISC
CH	ARCHITECTURÈ (ÁL)	MPH
	BOTTOM OF	MTL
	BOARD	MO
	BITUMINOUS	NIC NOM
OG (G	BUILDING	NTS
NG.	BLOCKING BEAM	OC
Т	BOTTOM	OD
Ċ	BRACE / BRACING	l l of
G	BEARING	ОН
	CONTROL / CONTRACTION JOINT	OPNO
	CENTERLINE	OPP I
3	CEILING	PAF
₹	CLEAR	PC
U	CONCRETE MASONRY UNIT	PCF
L NC	COLUMN	PL P/L
NC NT	CONCRETE	
NTR	CONTINUOUS CONTRACTOR	PLBG
RR	CORRUGATED	PLW
rr T	CARPET	PLAM
•	CERANIC TILE	PSF
J	CONSTRUCTION JOINT	PSI
	DOUBLE	PSL
MO	DEMOLISH / DEMOLITION	PT
	DIAMETER	QT
1	DIMENSION	RAD
	DIVISION	RCP
	DRINKING FOUNTAIN	RD
	DOWNSPOUT	REF
	DRAIN TILE	REIN
-	DETAIL DRAWING	REQU
G	EACH FACE	ROW
	ELEVATION	RO
С	ELECTRIC(AL)	RTU
R	ENGINEER OF RECORD	SCH
	EQUAL	SECT
UIV	EQUIVALENT	SF
	EACH WAY	SHT
С	ELECTRIC WATER COOLER	SIM
o	EXPANSION	SOG
ST / (E)	EXISTING	SPEC
	EXTERIOR	SQ
V	FLOOR DRAIN	55 S&V
N .	FOUNDATION FIRE EXTINGUISHER	STD
	FINISHED FLOOR	STL
	FINISHED GRADE	STRU
	FINISH(ED)	T/
3	FLOOR	T&B
>	FIBERGLASS REINFORCED POLYMER	T&G
	FOOT / FEET	THK
3	FOOTING	THRU
	GAUGE	TYP
LV	HOT-DIPPED GALVANIZE(D)	UNEX
	GENERAL CONTRACTOR	UNO
_	GRADE	VERT
-	GYPSUM HOSE BIBB	VIF
R	HOLLOW CORE HEADER	vwc
r RIZ	HORIZONTAL	WD WD
N/L	HEIGHT	WH
3	HEATING	W/IN
-	HOLLOW METAL	W/O
AC	HEATING, VENTILATING, AIR	l wp
-	HEATING, VENTILATING, AIR CONDITIONING	ws
	INSIDE DIAMETER	l l wt
	INSIDE FACE	www
L	INCLUDE(D) (ING)	WWR
UL	INSULATION	
	INTERIOR	

10	•	
	LVL	LAMINATED VENEER LUMBER
	LAV	LAVATORY
	MAT'L MAX	MATERIAL MAXIMUM
	MBS	METAL BUILDING SYSTEM
	MECH	MECHANICAL
	MFR / MANUF	MANUFACTURE(D) (R)
	MIN MISC	MINIMUM MISCELLANEOUS
	MPH	MILES PER HOUR
	MTL	METAL
	MO	MASONRY OPENING
	NIC NOM	NOT IN CONTRACT NOMINAL
	NTS	NOT TO SCALE
	oc	ON CENTER
	OD OF	OUTSIDE DIAMETER OUTSIDE FACE
	OH	OVERHEAD
Т	OPNG	OPENING
	OPP HD	OPPOSITE HAND
	PAF PC	POWER ACTUATED FASTENER PRECAST CONCRETE
	PCF	POUNDS PER CUBIC FOOT
	PL	PLATE
	P/L	PROPERTY LINE
	PLBG PLF	PLUMBING POUNDS PER LINEAL FOOT
	PLWD / PLYWD	PLYWOOD
	PLAM	PLASTIC LAMINATE
	PSF	POUNDS PER SQUARE FOOT
	PSI PSI	POUNDS PER SQUARE INCH PARALLEL STRAND LUMBER
	PT	PRESERVATIVE / PRESSUR TREATI
	QT	QUARRY TILE
	RAD	RADIUS
	RCP RD	REFLECTED CEILING PLAN ROOF DRAIN / ROOF DECK
	REF	REFERENCE
	REINF	REINFORCE(D) (ING)
	REQD REV	REQUIRED PEVISION(S)
	ROW	REVISED, REVISION(S) RIGHT OF WAY
	RO	ROUGH OPENING
	RTU	ROOFTOP UNIT
	SCH SECT	SCHEDULE SECTION
	SF	SQUARE FOOT
	SHT	SHEET
	SIM	SIMILAR
	SOG SPECS	SLAB-ON-GRADE SPECIFICATIONS
	SQ	SQUARE
	SS	STAINLESS STEEL
	S&V STD	STAIN AND VARNISH STANDARD
	STL	STEEL
	STRUCT / STR	STRUCTURE (AL)
	T/	TOP OF
YMER	T&B T&G	TOP AND BOTTOM TONGUE AND GROOVE
TIVIER	THK	THICK(NESS)
	THRU	THROUGH
	TYP	TYPICAL
	UNEX	UNEXCAVATED UNLESS NOTED OTHERWISE
	VERT	VERTICAL
	VIF	VERIFY IN FIELD
	VCT	VINYL COMPOSITION TILE VINYL WALL COVERING
	W/	WITH
	WD	WOOD
	WH	WATER HEATER
	W/IN W/O	WITHIN WITHOUT
	WP	WORKING POINT
	WS	WATERSTOP
	WT	WEIGHT
	WWM WWR	WELDED WIRE MESH WELDED WIRE REINFORCEMENT
	*****	WILLDED WINE NEINFORGEMENT

ALL OF THE CONTRACTORS AND SUPPLIERS ARE RESPONSIBLE TO INCLUDE ALL LABOR AND MATERIAL REQUIRED TO PROVIDE 100%

JOINT LIVE LOAD




1230 South Boulevard, Baraboo WI 53913 (608) 356-2771 www.msa-ps.com


ADAMS COUNTY ADMINISTRATION BUILDING SITE AND INTERIOR IMPROVEMENTS


FRIENDSHIP, WI


TITLE SHEET

21993005 SHEET

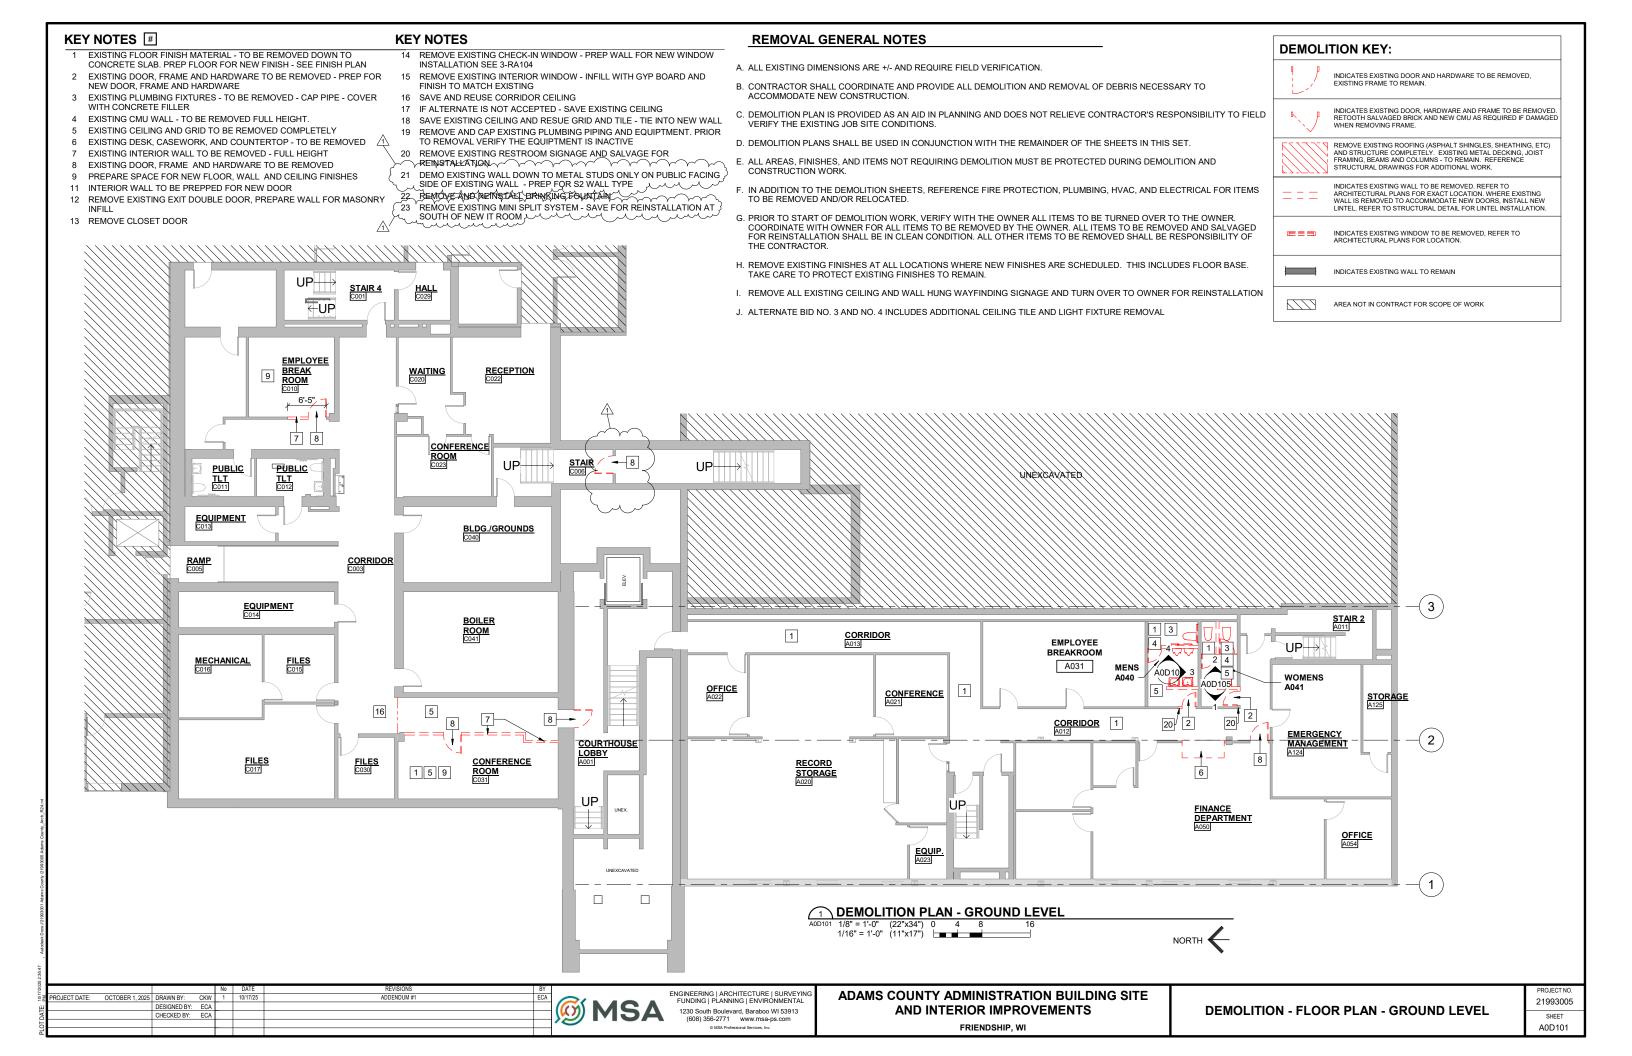

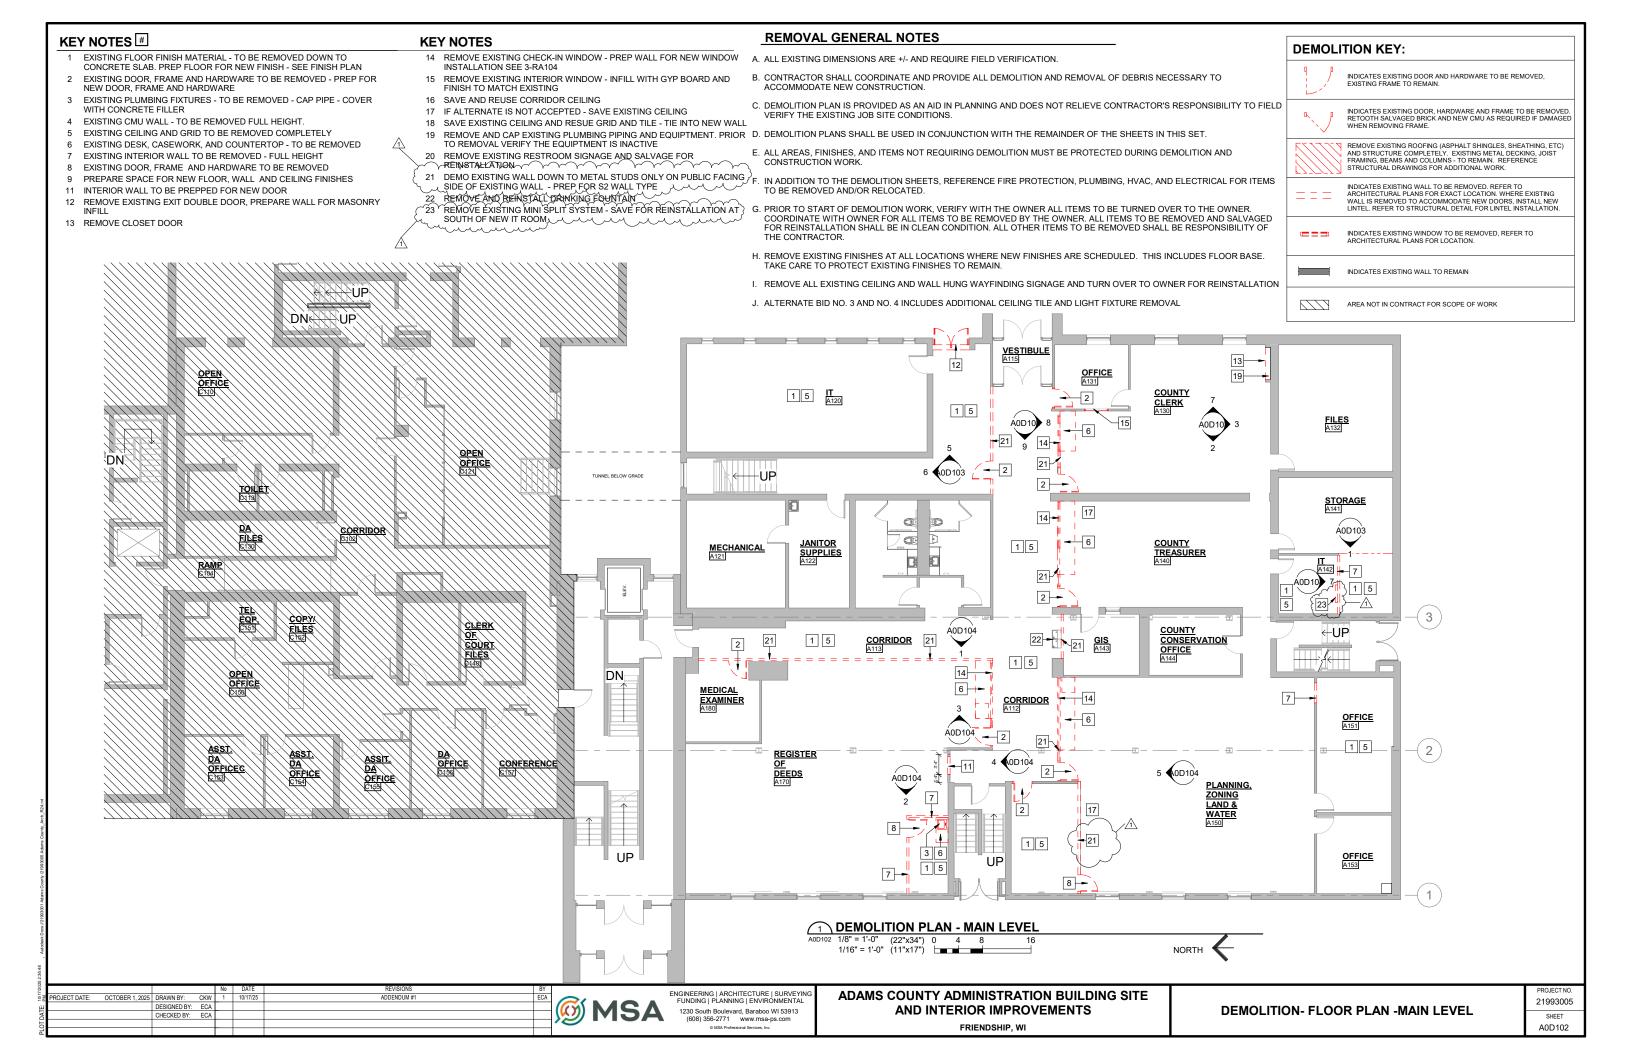

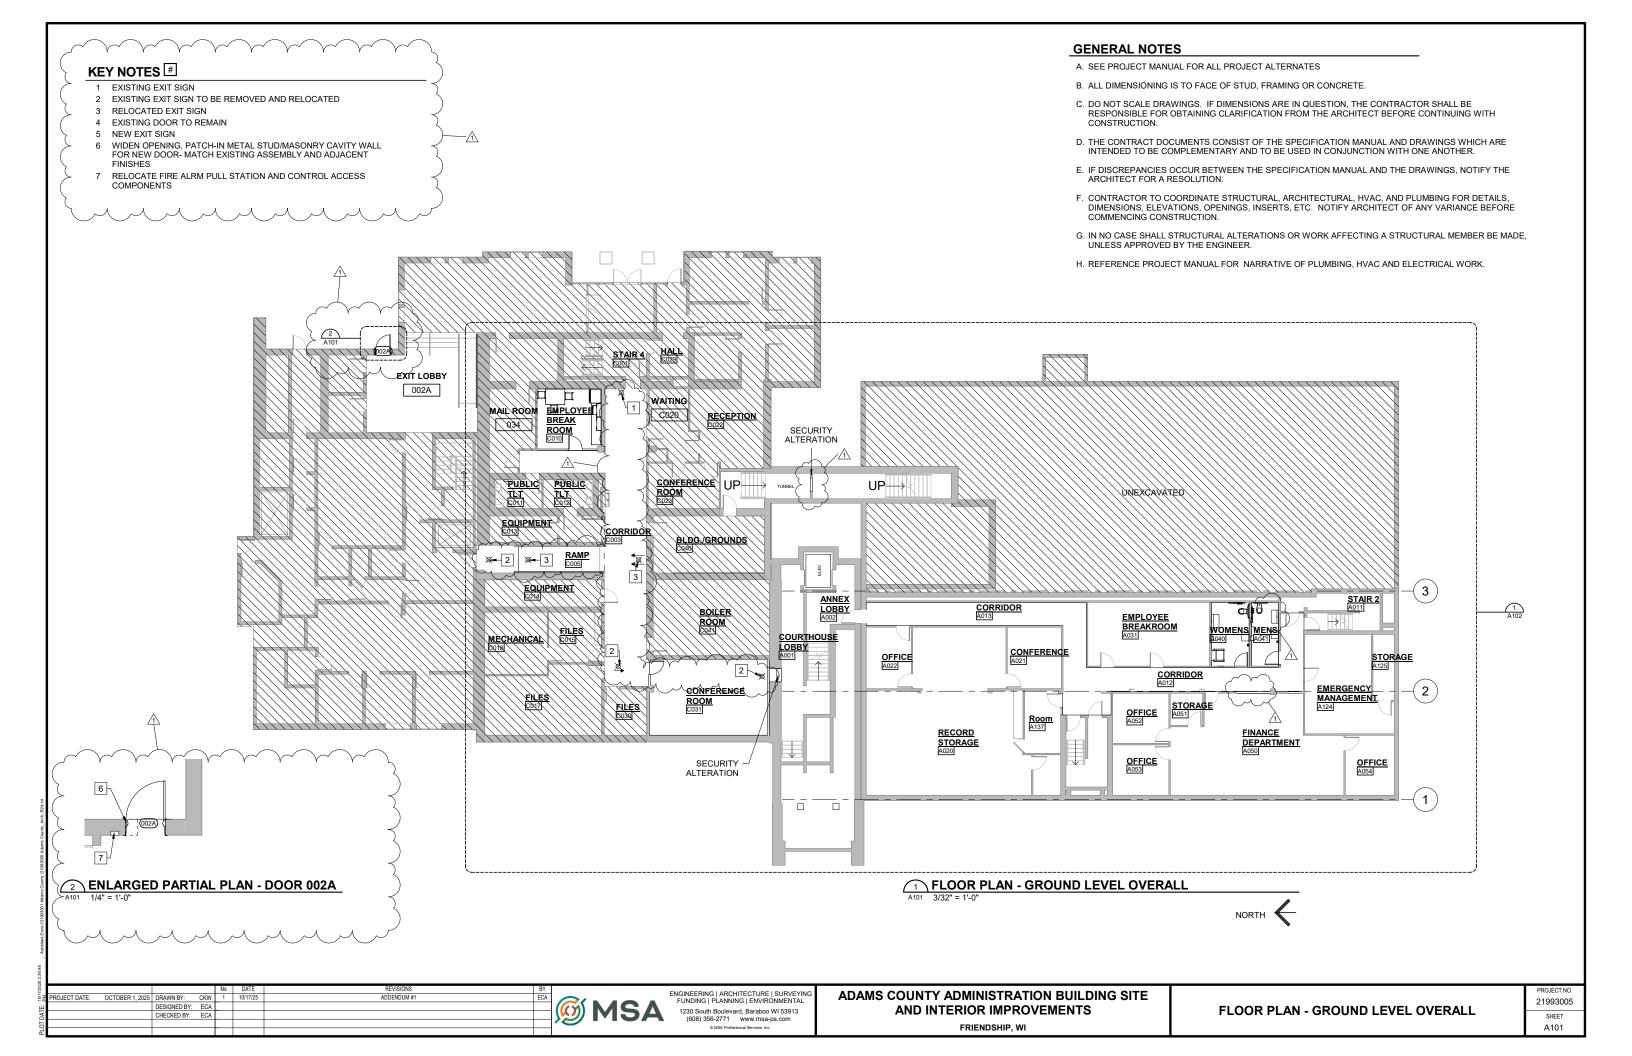

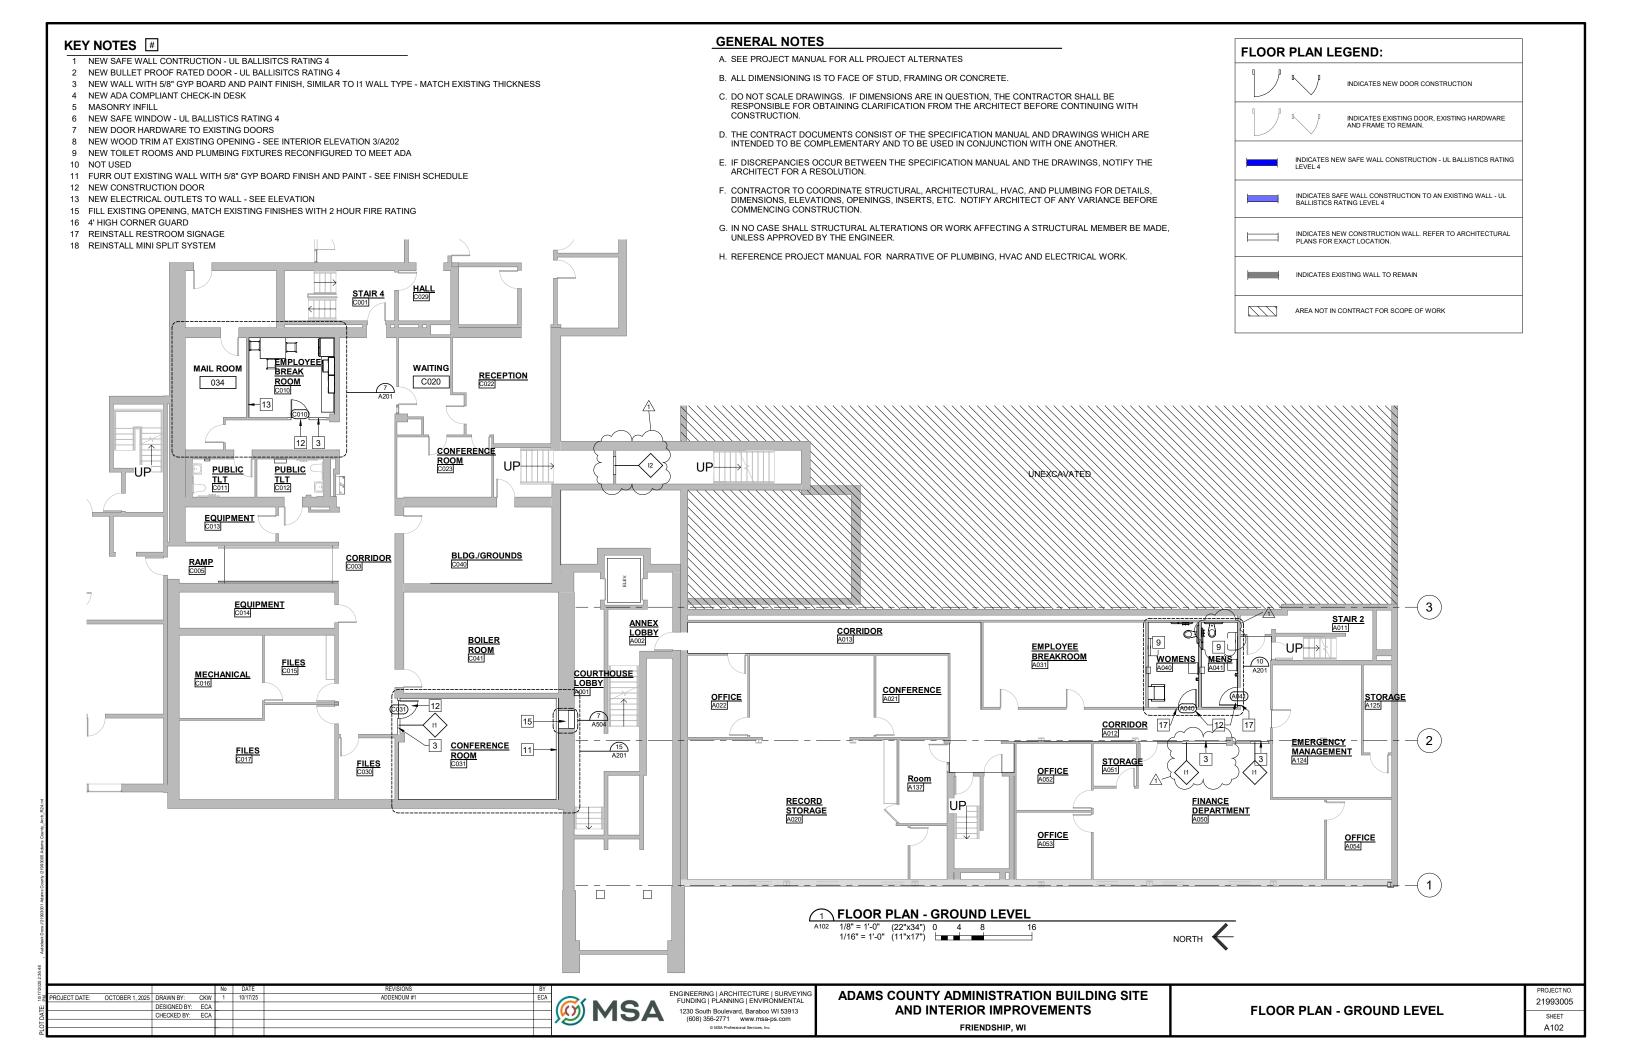


KEY NOTES

- 1 EXISTING EXIT SIGN
- EXISTING EXIT SIGN TO BE REMOVED AND RELOCATED
- 3 RELOCATED EXIT SIGN
- EXISTING DOOR TO REMAIN
- 5 NEW EXIT SIGN
- WIDEN OPENING, PATCH-IN METAL STUD/MASONRY CAVITY WALL FOR NEW DOOR- MATCH EXISTING ASSEMBLY AND ADJACENT FINISHES
- 7 RELOCATE FIRE ALRM PULL STATION AND CONTROL ACCESS COMPONENTS

GENERAL NOTES

- A. SEE PROJECT MANUAL FOR ALL PROJECT ALTERNATES
- B. ALL DIMENSIONING IS TO FACE OF STUD, FRAMING OR CONCRETE.
- C. DO NOT SCALE DRAWINGS. IF DIMENSIONS ARE IN QUESTION, THE CONTRACTOR SHALL BE RESPONSIBLE FOR OBTAINING CLARIFICATION FROM THE ARCHITECT BEFORE CONTINUING WITH CONSTRUCTION.
- D. THE CONTRACT DOCUMENTS CONSIST OF THE SPECIFICATION MANUAL AND DRAWINGS WHICH ARE INTENDED TO BE COMPLEMENTARY AND TO BE USED IN CONJUNCTION WITH ONE ANOTHER.
- E. IF DISCREPANCIES OCCUR BETWEEN THE SPECIFICATION MANUAL AND THE DRAWINGS, NOTIFY THE ARCHITECT FOR A RESOLUTION.
- F. CONTRACTOR TO COORDINATE STRUCTURAL, ARCHITECTURAL, HVAC, AND PLUMBING FOR DETAILS, DIMENSIONS, ELEVATIONS, OPENINGS, INSERTS, ETC. NOTIFY ARCHITECT OF ANY VARIANCE BEFORE COMMENCING CONSTRUCTION
- G. IN NO CASE SHALL STRUCTURAL ALTERATIONS OR WORK AFFECTING A STRUCTURAL MEMBER BE MADE, UNLESS APPROVED BY THE ENGINEER.

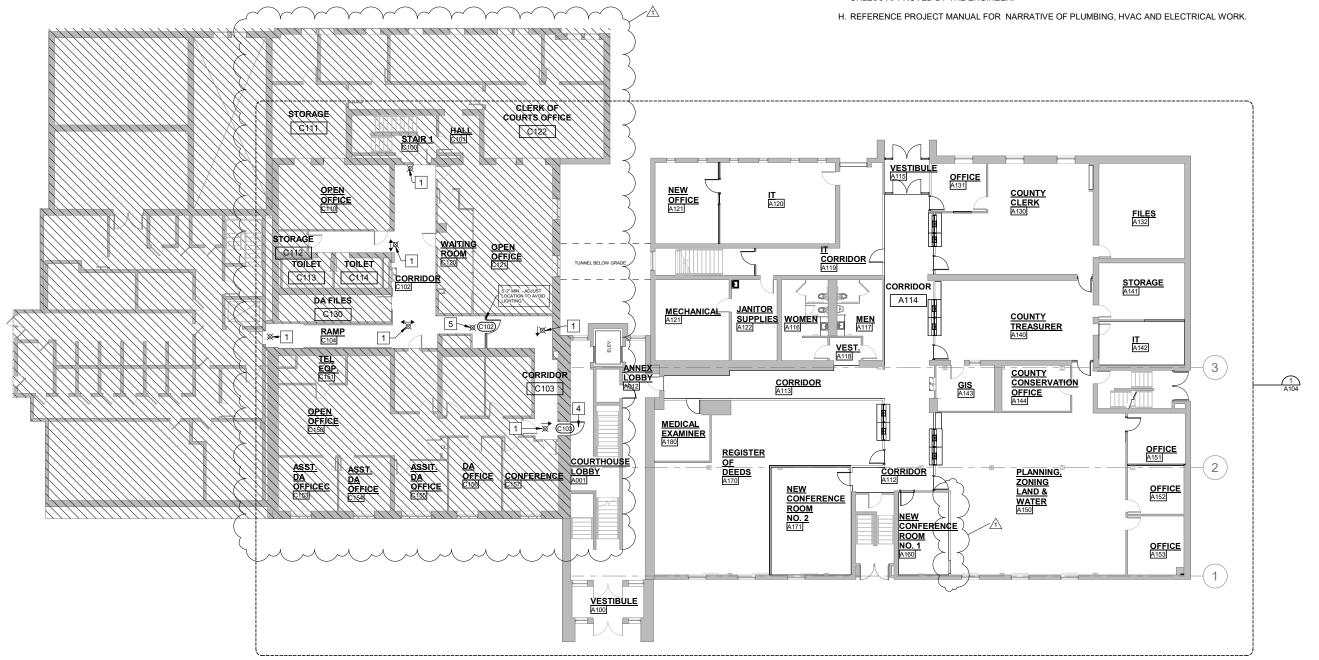

T FLOOR PLAN - MAIN LEVEL OVERALL
A103 3/32" = 1'-0"

RTH 🗲

ØMSA


ENGINEERING | ARCHITECTURE | SURVEYING FUNDING | PLANNING | ENVIRONMENTAL 1230 South Boulevard, Baraboo WI 53913 (608) 356-2771 www.msa-ps.com ADAMS COUNTY ADMINISTRATION BUILDING SITE AND INTERIOR IMPROVEMENTS


FRIENDSHIP, WI


FLOOR PLAN - MAIN LEVEL OVERALL


PROJECT NO. 21993005
SHEET


A103

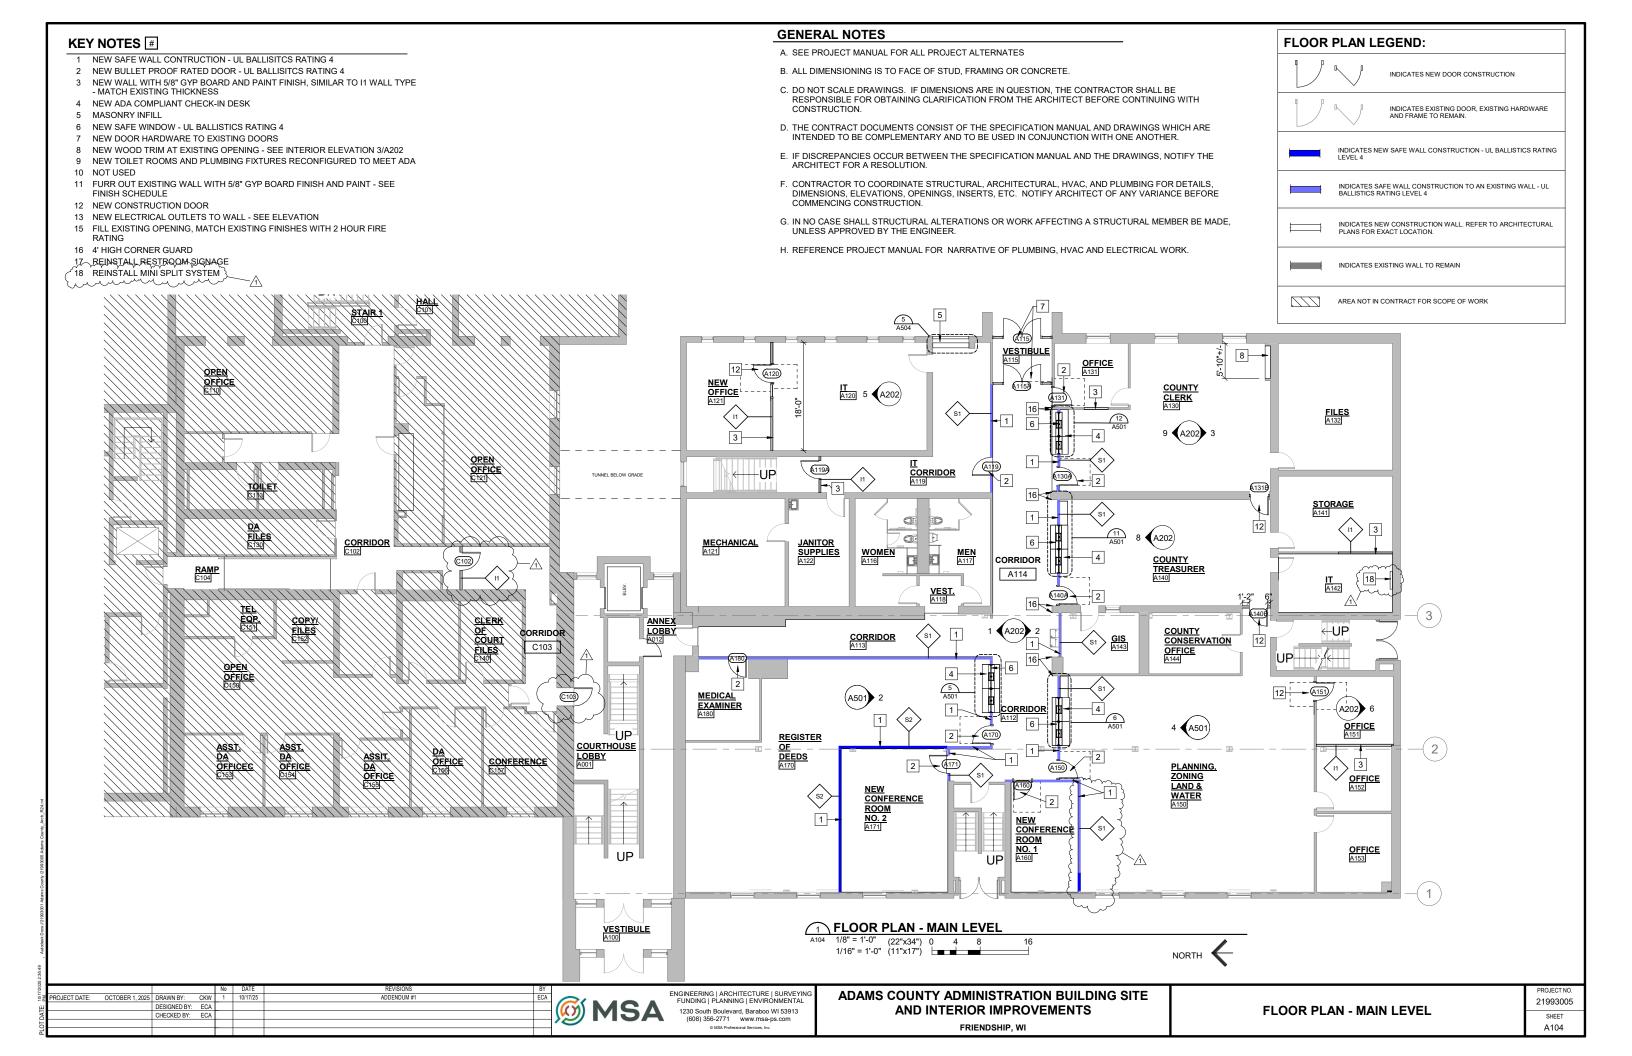


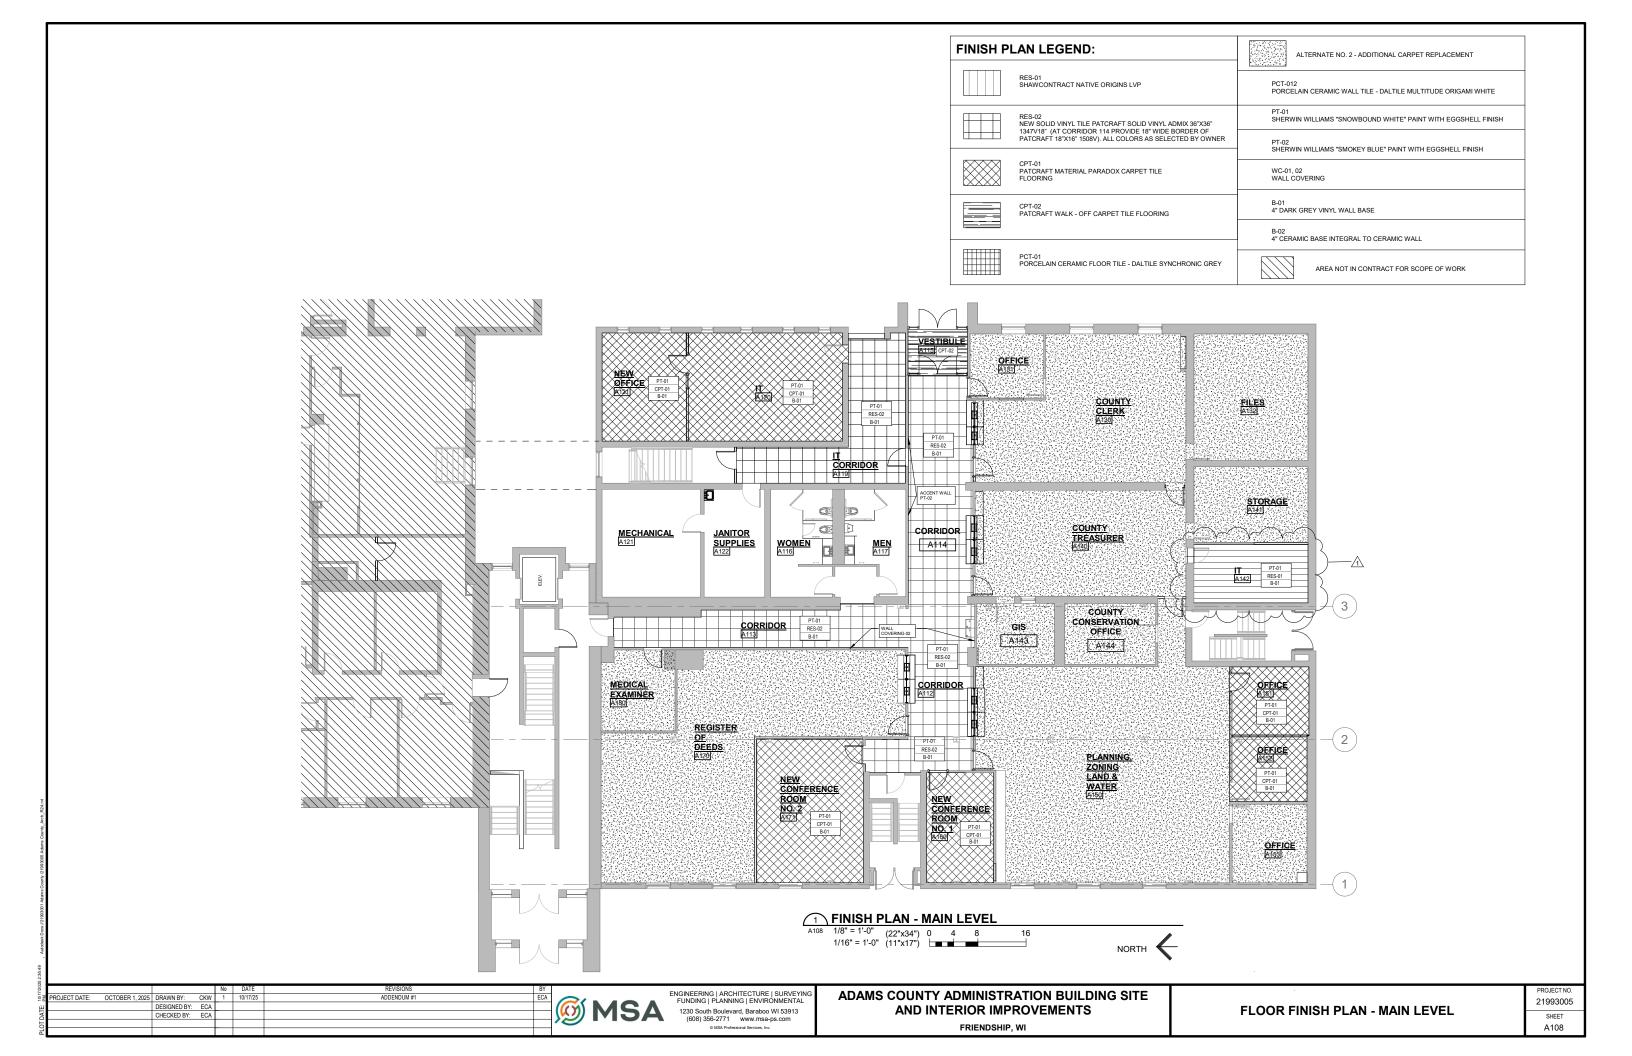

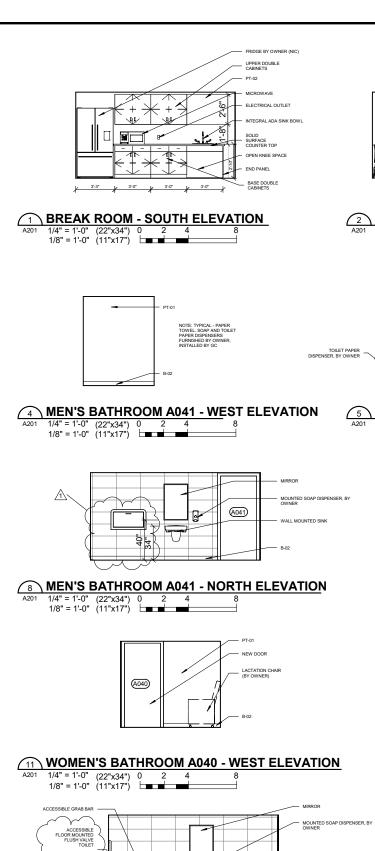

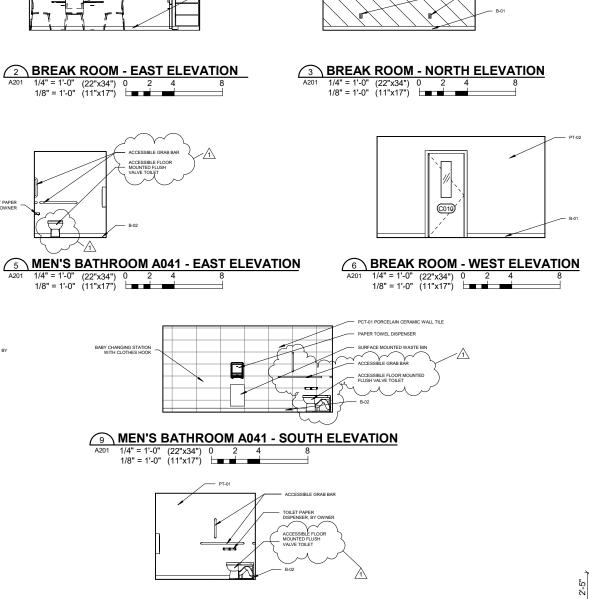

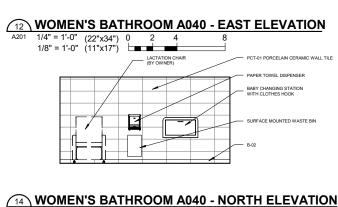

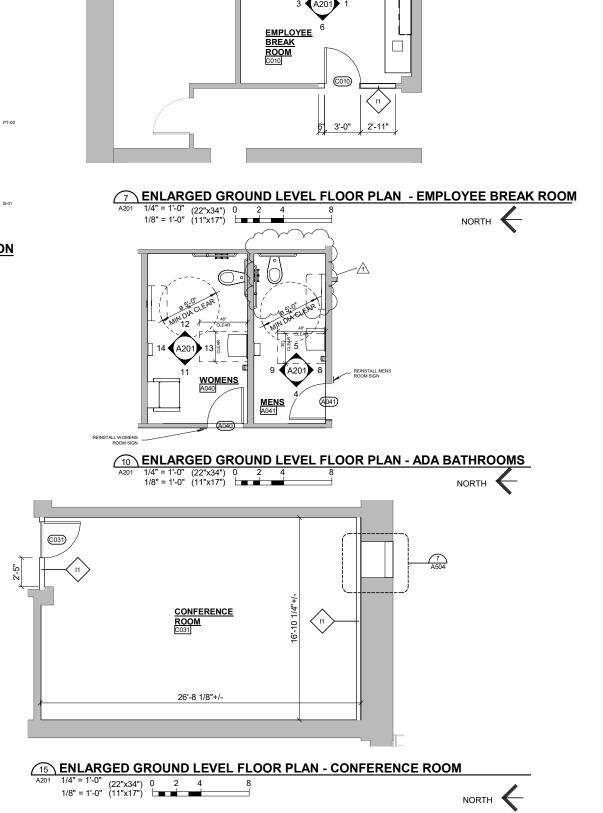

L ⊒

FURNITURE BY

OWNER

MOMEN'S BATHROOM A040 - SOUTH ELEVATION

1/4" = 1'-0" (22"x34") 0 2 4 1/8" = 1'-0" (11"x17")



1/4" = 1'-0" (22"x34") 0 2 4 1/8" = 1'-0" (11"x17")

ENGINEERING | ARCHITECTURE | SURVEYING FUNDING | PLANNING | ENVIRONMENTAL 1230 South Boulevard, Baraboo WI 53913 (608) 356-2771 www.msa-ps.com

ADAMS COUNTY ADMINISTRATION BUILDING SITE AND INTERIOR IMPROVEMENTS

FRIENDSHIP, WI

INTERIOR ELEVATIONS

PROJECT NO. 21993005 SHEET A201


DOOR SCHEDULE


GENERAL NOTES


A. NEW BULLET RESISTANT DOOR UL BALLISTICS RATING 4 WHERE INDICATED.


- 1. NEW BULLET RESISTANT DOOR UL BALLISTICS RATING 4
- 2. EXISTING DOORS REMAIN WITH NEW HARDWARE SET

	SCHEDULE															
	O DOOR						FRAME						Щ	Ď		
	<u>5</u>	9 NOMINAL SIZE						DETAILS					TYPE	RATING	δ	
	OPENING No	YPE	MAT'L	WIDTH	_HEIGHT~	ТҢІСКЦЕSS.	YPE	MAT'L	HEAD	~JAMB~	Y-SILLY-/	Hw set	GLASS	FIRE RA	REMARKS	<u></u>
(002A	A	HM	4' - 0"	7' - 0"	1 3/4"	.F4	HM		_		6				, ,
	~~~~~~~~~~~~~~~~~~~~~~~~~~~~~~~~~~~~~~	MA CO	WD	3'-0"	7-0	~~~~~~~~~~~~~~~~~~~~~~~~~~~~~~~~~~~~~~	\ <del>\</del>	₩.	57A502	<del>プルA502</del> ~		1-2	$\sim$			V
	A041	Α	WD	3' - 0"	7' - 0"	1 3/4"	F1	HM	5/A502	7/A502		2	_			
<u> </u>	A115	EXIST. REMAIN	_	6' - 2 3/8"	7' - 0"					_		3			2	
	A115A	EXIST. REMAIN	_	6' - 2 3/8"	7' - 0"					_		3			2	
	A119	В	WD	3' - 0"	7' - 0"	1 3/4"	F2	HM	6/A502	6/A502	ı	1			1	
	A119A	Α	WD	3' - 0"	7' - 0"	1 3/4"	F1	HM	5/A502	7/A502		5	_	_		
	A120	Α	WD	3' - 0"	7' - 0"	1 3/4"	F3	HM	5/A502	7/A502		5	Α	_		
	A130A	В	WD	3' - 0"	7' - 0"	1 3/4"	F2	HM	6/A502	6/A502		1	_	_	1	
	A131	В	WD	3' - 0"	7' - 0"	1 3/4"	F2	HM	6/A502	6/A502	-	1	_	_	1	
	A131B	Α	WD	3' - 0"	7' - 0"	1 3/4"	F1	HM	5/A502	7/A502		5				
	A140A	В	WD	3' - 0"	7' - 0"	1 3/4"	F2	HM	6/A502	6/A502		1			1	
	A140B	Α	WD	3' - 0"	7' - 0"	1 3/4"	F1	HM	5/A502	7/A502		5				
	A150	В	WD	3' - 0"	7' - 0"	1 3/4"	F2	HM	6/A502	6/A502		1			1	
	A151	Α	WD	3' - 0"	7' - 0"	1 3/4"	F1	HM	5/A502	7/A502		5				
	A160	В	WD	3' - 0"	7' - 0"	1 3/4"	F2	HM	6/A502	6/A502		1			1	
	A170	В	WD	3' - 0"	7' - 0"	1 3/4"	F2	HM	6/A502	6/A502		1			1	
	A171	В	WD	3' - 0"	7' - 0"	1 3/4"	F2	HM	6/A502	6/A502		4			1	
	A180	В	WD	3' - 0"	7' - 0"	1 3/4"	F2	HM	6/A502	6/A502		1			1	
	C010	С	WD	3' - 0"	7' - 0"	1 3/4"	F1	HM	5/A502	7/A502		5	Α			
/ے	~£Q31 _{~~}	man.	WD,	3'~0"~	~7' _{\7} 0"\	~13K4"~	∕E≯~	√HM,~	5/A502V	6/A502	$\sim$	√5∕	$\sim$	\		~
	C102	Α	WD	3' - 0"	7' - 0"	1 3/4"	F1	HM	5/A502	6/A502		8				
\ \ \	C103	FXIST REMAIN		3' - 0"	7' - 0"	1 3/4"						7			2	

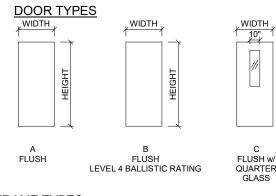


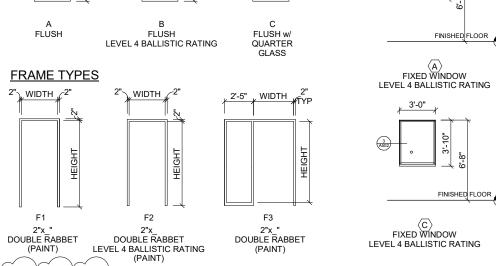

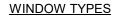

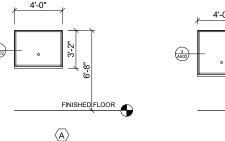



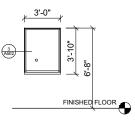

	2" WIDTH	2"	
\		Ħ	
\		HEIGHT	
\	F4		7/1
\	2"x_" Double Rae (Paint)	BET	$\langle$
5		~	رر

F1



### **ROOM FINISH SCHEDULE**

#### **GENERAL NOTES**

A. SEE REMOVAL DRAWINGS FOR EXISTING MATERIALS, SURFACES, FINISHES, ETC.

- B. SEE REMOVAL AND PROPOSED PLANS FOR ADDITIONAL WORK WHICH MAY NOT BE NOTED HERE.
- C. AT EXISTING SURFACES TO BE PAINTED. CLEAN AND PREP SURFACES AS NEED TO RECIEVE NEW PAINT FINISH
- D. CLEAN AND REUSE EXISTING GRILLS

1. CLEAN EXISTING SURFACES WHERE TO REMAIN (WALL, FLOOR, CEILING - AS APPLICABLE).

2. AT EXISTING PAINTED SURFACES, NOT SCHEDULED TO BE PAINTED, PAINT PROCESS PIPES REQUIRING COLOR CODING PER SECTION 09 96 00. AT EXISTING SURFACES, SCHEDULED TO BE PAINTED, PAINT ALL EXPOSED EXISTING AND NEW PIPES AND DUCTS (EXCEPT w/ FINISHED JACKETS) AND PAINT ALL EXPOSED EXISTING AND NEW CONDUIT, BRACKETS, SUPPORTS, ETC.

- 3. ALTERNATE BID No. 1 ADDITIONAL PAINTING. PAINT OTHER WALLS AND HOLLOW METAL FRAMES, 3 WALLS PT-01/ ACCENT WALL PT-02, AND PROVIDE ALL ASSOCIATED WORK
- 4. ALTERNATE BID No. 2 ADDITIONAL CARPET REPLACEMENT. REMOVE EXISTING FLOORING AND INSTALL NEW CPT-01/B-01 AND PROVIDE ALL ASSOCIATED WORK.
- 5. ALTERNATE BID No. 3 ADDITIONAL CEILING TILE REPLACEMENT. REMOVE CEILING TILE AND REPLACE. ACT (INSTALLED IN EXISTING SUSPENDED GRID), AND PROVIDE ALL ASSOCIATED WORK.
- 6. ALTERNATE BID No. 4 ADDITIONAL LIGHTING REPLACEMENT. REMOVE 2X4 LIGHTING, REPLACE WITH NEW FIXTURES (RAB SWISH 34 (2' x 4') AND PROVIDE ALL ASSOCIATED WORK.

#### LEGEND

FLOORING EXISTING LUXURY VINYL PLANK RES-02 SOLID VINYL TILE CPT-01 CARPET FLOOR TILE

WALLS: PT (01/02) PCT-02

**EXISTING** 

CERAMIC WALL TILE

CPT-02 PCT-01 WALK OFF CARPET TILE CERAMIC FLOOR TILE

BASE:

NONE

B-01 4" VINYL BASE B-02 4" CERAMIC TILE INTERGRAL TO CT WALL

CEILING: EX ACT EXISTING ACT TILE CEILING

$\sim$ L	וור		
$\cup$	<u> </u>	ᆫ	

ž				WALLS			(			
ROOM	Name	FLOOR	BASE	NORTH	EAST	SOUTH	WEST	MAT'L	HEIGHT	REMARKS
C031	CONFERENCE ROOM	CPT-01	B-01	PT-01	PT-01	PT-02	PT-01	ACT	MATCH EXIST.	
C010	EMPLOYEE BREAK ROOM	RES-01	B-01	WC-01	PT-02	PT-02	PT-02	ACT	MATCH EXIST.	
A180	MEDICAL EXAMINER	CPT-01	B-01	PT-01	PT-01	PT-01	PT-02	ACT	MATCH EXIST.	3.4.5.6.
A171	NEW CONFERENCE ROOM NO. 2	CPT-01	B-01	PT-02	PT-01	PT-01	PT-01	ACT	MATCH EXIST.	
A170	REGISTER OF DEEDS	CPT-01	B-01	PT-01	PT-01	PT-02	PT-01	ACT	MATCH EXIST.	3.4.5.6.
A160	NEW CONFERENCE ROOM NO. 1	CPT-01	B-01	PT-01	PT-01	PT-02	PT-01	ACT	MATCH EXIST.	
A152	OFFICE	CPT-01	B-01	PT-01	PT-01	PT-02	PT-01	ACT	MATCH EXIST.	
A151	OFFICE	CPT-01	B-01	PT-01	PT-01	PT-02	PT-01	ACT	MATCH EXIST.	
A150	PLANNING, ZONING LAND & WATER	CPT-01	B-01	PT-01	PT-01	PT-01	PT-02	ACT	MATCH EXIST.	3.4.5.6.
A144	COUNTY CONSERVATION OFFICE	CPT-01	B-01	PT-01	PT-01	PT-01	PT-02	ACT	MATCH EXIST.	3.4.5.6.
A143	GIS	CPT-01	B-01	PT-01	PT-01	PT-01	PT-02	ACT	MATCH EXIST.	3.4.5.6.
A142	IT	RES-01	B-01	PT-01	PT-01	PT-01	PT-01	ACT	MATCH EXIST.	
A141	STORAGE	CPT-01	B-01	PT-01	PT-01	PT-01	PT-01	ACT	MATCH EXIST.	3.4.5.6.
A140	COUNTY TREASURER	CPT-01	B-01	PT-01	PT-01	PT-01	PT-02	ACT	MATCH EXIST.	3.4.5.6.
A132	FILES	CPT-01	B-01	PT-01	PT-01	PT-01	PT-02	ACT	MATCH EXIST.	3.4.5.6.
A131	OFFICE	CPT-01	B-01	PT-01	PT-01	PT-01	PT-02	ACT	MATCH EXIST.	3.4.5.6.
A130	COUNTY CLERK	CPT-01	B-01	PT-01	PT-01	PT-01	PT-02	ACT	MATCH EXIST.	3.4.5.6.
A121	NEW OFFICE	CPT-01	B-01	PT-01	PT-01	PT-01	PT-02	ACT	MATCH EXIST.	
A120	IT	CPT-01	B-01	PT-01	PT-01	PT-01	PT-01	ACT	MATCH EXIST.	
A119	IT CORRIDOR	RES-02	B-01	PT-01	PT-01	PT-01	PT-01	ACT	MATCH EXIST.	
A115	VESTIBULE	CPT-02	B-01	PT-01	PT-01	PT-01	PT-01	ACT	MATCH EXIST.	
A114	CORRIDOR	RES-02	B-01	PT-01	PT-01	PT-01	PT-01	ACT	MATCH EXIST.	
A113	CORRIDOR	RES-02	B-01	PT-01	PT-01	PT-01	WC-02	ACT	MATCH EXIST.	
A112	CORRIDOR	RES-02	B-01	PT-01	PT-01	WC-02	PT-01	ACT	MATCH EXIST.	
A054	OFFICE	CPT-01	B-01	PT-01	PT-01	PT-02	PT-01	ACT	MATCH EXIST.	3.4.5.6.
A053	OFFICE	CPT-01	B-01	PT-01	PT-01	PT-02	PT-01	ACT	MATCH EXIST.	3.4.5.6.
A052	OFFICE	CPT-01	B-01	PT-01	PT-01	PT-02	PT-01	ACT	MATCH EXIST.	3.4.5.6.
A051	STORAGE	CPT-01	B-01	PT-01	PT-01	PT-01	PT-01	ACT	MATCH EXIST.	3.4.5.6.
A050	FINANCE DEPARTMENT	CPT-01	B-01	PT-01	PT-01	PT-01	PT-02	ACT	MATCH EXIST.	3.4.5.6.
A041	MENS	PCT-01	B-02	PCT-02	PT-02	PCT-02	PT-02	ACT	MATCH EXIST.	
A040	WOMENS	PCT-01	B-02	PCT-02	PT-02	PCT-02	PT-02	ACT	MATCH EXIST.	
A013	CORRIDOR	RES-02	B-01	EXIST. REMAIN	EXIST. REMAIN	EXIST. REMAIN	EXIST. REMAIN	ACT	MATCH EXIST.	5.6.
A012	CORRIDOR	RES-02	B-01	EXIST. REMAIN	EXIST. REMAIN	EXIST. REMAIN	EXIST. REMAIN	ACT	MATCH EXIST.	5.6

FINISH PLAN LEGEND:	ALTERNATE NO. 2 - ADDITIONAL CARPET REPLACEMENT					
RES-01 SHAWCONTRACT NATIVE ORIGINS LVP	PCT-012 PORCELAIN CERAMIC WALL TILE - DALTILE MULTITUDE ORIGAMI WHITE					
RES-02 NEW SOLID VINYL TILE PATCRAFT SOLID VINYL ADMIX 36"X36"	PT-01 SHERWIN WILLIAMS "SNOWBOUND WHITE" PAINT WITH EGGSHELL FINISH					
1347V18" (AT CORRIDOR 114 PROVIDE 18" WIDE BORDER OF PATCRAFT 18"X16" 1508V). ALL COLORS AS SELECTED BY OWNER	PT-02 SHERWIN WILLIAMS "SMOKEY BLUE" PAINT WITH EGGSHELL FINISH					
CPT-01 PATCRAFT MATERIAL PARADOX CARPET TILE FLOORING	WC-01, 02 WALL COVERING					
CPT-02 PATCRAFT WALK - OFF CARPET TILE FLOORING	B-01 4" DARK GREY VINYL WALL BASE					
	B-02 4" CERAMIC BASE INTEGRAL TO CERAMIC WALL					
PCT-01 PORCELAIN CERAMIC FLOOR TILE - DALTILE SYNCHRONIC GREY	AREA NOT IN CONTRACT FOR SCOPE OF WORK					

PROJECT DATE: OCTOBER 1, 2025 DRAWN BY: DRAWN BY: CKW 1
DESIGNED BY: ECA



1230 South Boulevard, Baraboo WI 53913 (608) 356-2771 www.msa-ps.com

ADAMS COUNTY ADMINISTRATION BUILDING SITE AND INTERIOR IMPROVEMENTS FRIENDSHIP, WI

21993005 SHEET A602