

ALLAMAKEE CSD MIDDLE SCHOOL HVAC UPGRADE
WAUKON, IOWA

ADDENDUM 01
March 2, 2026

GENERAL

APPROVED SUBSTITUTION REQUESTS:

Specification Section: 15830 Terminal Units

Item: VAV Boxes

Manufacturer: Anemostat

Specification Section: 15830 Terminal Units

Item: Hot Water Unit Heaters

Manufacturer: Vulcan Radiator

Specification Section: 15880 Fire Dampers

Item: Fire Dampers

Manufacturer: Anemostat Arrow by Mestek

Specification Section: 15910 Ductwork Accessories

Item: Dampers

Manufacturer: Anemostat Arrow by Mestek

SPECIFICATIONS:

- S-1 Section **00 010 – TABLE OF CONTENTS**
1. **REPLACE** original section in its entirety with the attached specification section.
- S-2 Section **01 100 – SUMMARY**
1. **REPLACE** original section in its entirety with the attached specification section.
- S-3 Section **15 482 – FACTORY FABRICATED PACKAGED HEATING MAKEUP AIR UNIT**
1. **ADD** attached specification section in its entirety.
- S-4 Section **15 865 – ENERGY RECOVERY VENTILATORS**
1. **REPLACE** original section in its entirety with the attached specification section.

DRAWINGS:

- D1-1 Drawing **D-101A – DEMO MECHANICAL & ELECTRICAL PLAN – AREA A**
1. Added general demo notes.
 2. Added electrical demo keynote D5 to all HVAC equipment to be demolished that weren't previously keynoted.

- D1-2 Drawing **D-101B – DEMO MECHANICAL & ELECTRICAL PLAN – AREA B**
1. Added general demo notes.
 2. Added the demolition of existing conduit and conductors to the existing campus sectionalizer.
 3. Added electrical demo keynote D5 to existing HW radiant heater.
- D1-3 Drawing **D-110 – DEMO LIGHTING PLAN – OVERALL**
1. Added the demolition of all existing light fixtures and controls in admin area and added a note describing this.
- D1-4 Drawing **D-110A – DEMO LIGHTING PLAN – AREA A**
1. Added the demolition of a light switch in the boy's locker room.
 2. Removed demolition of light switches on south wall of gymnasium.
 3. Added the demolition of cafeteria ceiling mounted round speakers.
 4. Removed the demolition of ceiling mounted occupancy sensors in the kitchen.
 5. Added the demolition of all existing light fixtures and controls in admin area.
- D1-5 Drawing **D-110B – DEMO LIGHTING PLAN – AREA B**
1. Removed the demolition of a light switch in the gymnasium.
- D1-6 Drawing **D-201 – DEMO MECHANICAL & ELECTRICAL ROOF PLAN - OVERALL**
1. Added electrical demo keynote D5 to existing walk-in cooler condensers above the kitchen.
- M1-1 Drawing **M-101A – MECHANICAL PLAN – AREA A**
1. Added remaining Admin spaces and offices to DOAS-6 system and added mini-split systems to provide heating and cooling to the associated spaces.
 2. Removed VAV-1 and VAV-2.
 3. Revised kitchen hood makeup and associated ductwork to be provided by individual makeup air units MAU-1, MAU-2, and MAU-3 (one per cooking exhaust hood).
 4. Revised UV-9 to be ceiling cassette style unit ventilator.
- M1-2 Drawing **M-101B – MECHANICAL PLAN – AREA B**
1. Relocated humidistat for DH-1 to DOAS-1 return ductwork.
 2. Show existing make-up air unit to remain.
- M1-3 Drawing **M-101C – MECHANICAL PLAN – AREA C**
1. Relocated humidistat for DH-3 to existing DOAS S return ductwork.
- M1-4 Drawing **M-101D – MECHANICAL PLAN – AREA D**
1. Relocated humidistat for DH-2 to existing DOAS N return ductwork.
- M1-5 Drawing **M-111A – MECHANICAL PIPING & CONTROLS PLAN – AREA A**
1. Added remaining Admin spaces and offices to DOAS-6 system and added mini-split systems to provide heating and cooling to the associated spaces. Added associated controls, refrigerant piping, and condensate piping.
 2. Revised UV-9 to be ceiling cassette style unit ventilator.

3. Revised gas piping to new HVAC equipment to be standalone branch ran from mechanical room.

- M1-6 Drawing **M-111B – MECHANICAL PIPING & CONTROLS PLAN – AREA B**
1. Revised gas piping to new HVAC equipment to be standalone branch ran from mechanical room.
- M1-7 Drawing **M-111C – MECHANICAL PIPING & CONTROLS PLAN – AREA C**
1. Show soft water piping connection to DH-3.
- M1-8 Drawing **M-111D – MECHANICAL PIPING & CONTROLS PLAN – AREA D**
1. Show soft water piping connection to DH-2.
- M1-9 Drawing **M-201 – MECHANICAL ROOF PLAN**
1. Revised kitchen hood makeup to be provided by individual makeup air units MAU-1, MAU-2, and MAU-3 (one per cooking exhaust hood).
 2. Revised gas piping to make-up air units accordingly.
- M1-10 Drawing **M-503 – MECHANICAL DETAILS**
1. Added Natural Gas Flow Diagram.
- M1-11 Drawing **M-601 – MECHANICAL SCHEDULES**
1. Removed VAV-1 & VAV-2.
 2. Revised UV-9 to be ceiling cassette style unit ventilator.
 3. Added UV-11, UV-12, UV-13, UV-14, UV-15, UV-16, and associated CU-4.
 4. Revised MAU-1 selection, refer to sheet M-604 for updated selection.
- M1-12 Drawing **M-602 – MECHANICAL SCHEDULES**
1. Added remaining Admin spaces and offices to airflow matrix.
- M1-13 Drawing **M-604 – MECHANICAL SCHEDULES**
1. Added Direct-Fired Make-Up Air Unit Schedule including MAU-1, MAU-2, and MAU-3 selections.
- M1-14 Drawing **M-802 – HVAC CONTROLS**
1. Added note regarding thermostat set point of Radiant Heating Panels Sequence of Operation.
- ME1-1 Drawing **ME101 – DEMO MECHANICAL & ELECTRICAL PLANS – HIGH SCHOOL**
1. Added electrical demo keynote D5 to existing DOAS unit and existing exhaust fan above the high school.
- ME1-2 Drawing **ME102 – MECHANICAL & ELECTRICAL PLANS – HIGH SCHOOL**
1. Added thermostat and smoke detector.
- ME1-3 Drawing **ME103 – MECHANICAL & ELECTRICAL PLANS – EAST ELEMENTARY**
1. Added clarification which specifies that disconnects for the proposed unit heaters shall be provided by the mechanical contractor.

2. Revised entering water temperature (EWT) of UH-1 and UH-2.

E1-1 Drawing **E-101 – ELECTRICAL PLAN – OVERALL**

1. Added circuit for one (1) new outdoor condensing unit.
2. Revise DH-3 (Alternate #2) circuit to panel HJ.
3. Revise EF-1 circuit to panel HJ.
4. Revised MAU-1 circuit and added (2) additional circuits to feed three (3) smaller MAU's: MAU-1, MAU-2 and MAU-3.
5. Revised DOAS-5 circuit to panel K-1.
6. Revised KEF-circuit to existing spare circuit K-1-22.

E1-2 Drawing **E-101A – ELECTRICAL PLAN – AREA A**

1. Added circuit for one (1) new outdoor condensing unit, six (6) new unit ventilators, and one (1) new branch box for the north admin area.
2. Added note to provide new conduit and conductors for CE-1 while re-using the existing breaker.
3. Added note to circuit new exhaust fan to the existing lighting circuit.
4. Revised electrical keynote E5.

E1-3 Drawing **E-101B – ELECTRICAL PLAN – AREA B**

1. Revised electrical keynote E2.
2. Revised Alternate #2 note.

E1-4 Drawing **E-102 – ELECTRICAL ROOF PLAN**

1. Revised circuit for roof-mounted MAU-1 to three (3) smaller roof-mounted MAU's.
2. Added convenience receptacle circuits and disconnects for new MAU's.
3. Created enlarged view of equipment on the kitchen's roof to clearly see each piece of equipment's circuiting.
4. EF-1 is now powered by panel HJ.
5. DOAS-5 is now powered by panel K-1.
6. KEF-1 is now on existing spare circuit K-1-22.

E1-5 Drawing **E-110 – LIGHTING PLAN - OVERALL**

1. Added lighting fixtures to north Admin area and the janitor's closet near the kitchen.

E1-6 Drawing **E-110A – LIGHTING PLAN – AREA A**

1. Added proposed lighting fixtures, smoke detectors, occupancy sensors, light switches, square ceiling mounted speakers, and room controllers in north Admin area and the janitor's closet near the kitchen.
2. Added proposed square ceiling-mounted speakers to south Admin area.
3. Added proposed lighting fixtures in janitor's closet near kitchen.
4. Revised light switch type and zoning control in the gymnasium.

E1-7 Drawing **E-110B – LIGHTING PLAN – AREA B**

1. Revised light switch type and zoning control in the gymnasium, stage, and auditorium.
2. Revised Alternate #3 note.
3. Revised Lighting Note #6.

- E1-8 Drawing **E-601 – ELECTRICAL EQUIPMENT SCHEDULE**
1. Revised electrical keynotes E2 and E5.
 2. Revised wire sizes in Motor and Equipment Schedule.
 3. Added circuit for CU-4, BB-2, and UV's.
 4. Revised amperage load for condensing unit and unit ventilator circuits.
 5. Revised MCA for all condensing unit and unit ventilator circuits.
 6. Revised MOCP for CU-2 & CU-3 circuits.
 7. Added note to all condensing unit and unit ventilator circuits to wire a condensate pump to each unit ventilator.
 8. Added note to DOAS-4 to clarify equipment is part of Alternate #3.
 9. Replaced MAU-1 with three units: MAU-1, MAU-2, and MAU-3.
- E1-9 Drawing **E-602 – LIGHTING SCHEDULES**
1. Revised descriptions Lighting Control Sequence of Operation #4 & #7
 2. Added note to Lighting Control Sequence of Operation for the electrical contractor to provide new control wiring.
- E1-10 Drawing **E-603 – ELECTRICAL PANEL SCHEDULES**
1. Revised SWBD bus rating and mains rating to 2000A.
 2. Revised DH-3 circuit to panel HJ with 70A/3P breaker.
 3. Revised EF-1 circuit to panel HJ with 15A/1P breaker.
 4. Added circuit for new condensing unit, branch box, and unit ventilators to panel HJ with 70A/2P breaker.
 5. Revised DH-3 circuit to panel HJ with 70A/3P breaker.
 6. Revised DOAS-5 circuit to panel K-1 with 70A/3P breaker.
 7. Revised KEF-3 circuit to use existing 20A/1P spare breaker in panel K-1.
 8. Revised DOAS and MAU receptacle circuits and DOAS light circuits to spare on panel K-1 with 20A/1P breaker.
 9. Revised MAU-1 circuit to panel K-1 with 20A/2P breaker.
 10. Added MAU-2 circuit to panel K-1 with 20A/2P breaker.
 11. Added MAU-3 circuit to panel K-1 with 20A/2P breaker.
- E1-11 Drawing **E-604 – ELECTRICAL PANEL SCHEDULES**
1. Removed DOAS-5 from panel DB.
 2. Revised mains type of Panel A to MLO.
- E1-12 Drawing **E-605 – ELECTRICAL PANEL SCHEDULES - PHOTOS**
1. Removed pictures of panels HI, HF, and K-1.
 2. Revised note for existing 20A/3P circuit breaker in 25, 27, 29 on panel L11 to be noted as spare.

Enclosure:
Architectural Addendum
Plans Holders List

END OF ADDENDUM 01

March 2, 2026

Design Dynamics, Inc.
3745 Center Point Road, NE
Cedar Rapids, IA 52402
319-298-0400
Robert Peck, AIA, LEED AP
robertp@designdynamics.biz

Allamakee Community School District Waukon Middle School HVAC Upgrade

Location: Waukon, Iowa

ADDENDUM NUMBER 1

TO ALL HOLDERS OF PLANS AND SPECIFICATIONS:

This addendum is issued to incorporate the following changes in the plans and specifications DATED: February 20, 2026. For bids to be considered, this addendum must be acknowledged by the bidders by so indicating on the Bid Proposal form.

The Contractor shall make the following corrections or additions to the bidding documents. These items shall supersede, modify, and/or change all statements or drawings to the contrary in the plans and specifications and shall take precedence over these documents. Bidders shall base their bid on the plans and specifications and as modified by the changes herein stated.

Contents:

DDI Addendum 1 (1 page)
DDI Sheets A.1, A.2, A.3, A.4 and A.5

ARCHITECTURAL SPECIFICATIONS:

1. Section 09511, Acoustical Panel Ceilings, 2.3, Acoustical Panels, 1.: Change to read as follows:
Armstrong, School Zone Fine Fissured #1713

ARCHITECTURAL DRAWINGS:

1. Replace Sheets A.1, A.2, A.3, A.4, and A.5 in their entirety.
2. Sheet A.10, Room Finish Schedule: Remove the VCT (vinyl composite tile) and VB (vinyl base) from room numbers 119 Boiler Room and 201 Library.

ADDENDUM 1

OWNER CONTRACTOR AGREEMENT
GENERAL CONDITIONS
INSTRUCTIONS TO BIDDERS
NOTICE TO BIDDERS
PROPOSAL FORM
SPECIAL CONDITIONS

DIVISION 1-GENERAL REQUIREMENTS

SECTION 01100 SUMMARY
SECTION 01250 CONTRACT MODIFICATION PROCEDURES
SECTION 01290 PAYMENT PROCEDURES
SECTION 01310 PROJECT MANAGEMENT AND COORDINATION
SECTION 01320 CONSTRUCTION PROGRESS DOCUMENTATION
SECTION 01330 SUBMITTAL PROCEDURES
SECTION 01400 QUALITY REQUIREMENTS
SECTION 01420 REFERENCES
SECTION 01500 TEMPORARY FACILITIES AND CONTROLS
SECTION 01600 PRODUCT REQUIREMENTS
SECTION 01670 SYSTEM DEMONSTRATION AND TRAINING
SECTION 01700 EXECUTION REQUIREMENTS
SECTION 01731 CUTTING AND PATCHING
SECTION 01732 SELECTIVE DEMOLITION
SECTION 01742 COORDINATION OF UTILITIES
SECTION 01770 CLOSEOUT PROCEDURES
SECTION 01781 PROJECT RECORD DOCUMENTS
SECTION 01782 OPERATION AND MAINTENANCE DATA

DIVISION 3 - CONCRETE WORK

SECTION 03732 CONCRETE REPAIR

DIVISION 4 - MASONRY

SECTION 04200 MASONRY

DIVISION 5 – METALS

SECTION 05500 METAL FABRICATIONS

DIVISION 6 - WOOD AND PLASTICS

SECTION 06100 ROUGH CARPENTRY
SECTION 06200 FINISH CARPENTRY

DIVISION 7-THERMAL AND MOISTURE PROTECTION

SECTION 07210 THERMAL INSULATION
SECTION 07270 FIRESTOPPING
SECTION 07841 THROUGH PENETRATION FIRESTOP SYSTEMS
SECTION 07920 JOINT SEALANT

DIVISION 8 – OPENINGS

SECTION 08305 ACCESS DOORS

SECTION 08411 ALUMINUM FRAMED ENTRANCES AND STOREFRONTS
SECTION 08810 GLAZING
SECTION 08910 MANUAL ROLLER WINDOW SHADES
SECTION 081416 FLUSH WOOD DOORS
SECTION 087100 DOOR HARDWARE

DIVISION 9-FINISHES

SECTION 09215 PLASTER REPAIR
SECTION 09250 GYPSUM BOARD
SECTION 09511 ACOUSTICAL PANEL CEILING
SECTION 09900 PAINTING
SECTION 096519 VINYL COMPOSITION TILE
SECTION 096513 RESILENT BASE AND ACCESSORIES
SECTION 096810 CARPET ING

DIVISION 11 – EQUIPMENT

SECTION 116143 STAGE CURTAINS
SECTION 116653 GYNASIUM DIVIDERS
SECTION 116670 WALKIN EQUIPMENT
SECTION 116700 REFIRGERATION EQUIPMENT

DIVISION 15 - MECHANICAL SYSTEMS

SECTION 15010 MECHANICAL GENERAL PROVISIONS
SECTION 15014 BACKFILLING
SECTION 15015 TRENCHING
SECTION 15050 MECHANICAL BASIC MATERIALS AND METHODS
SECTION 15060 PIPE & PIPE FITTINGS
SECTION 15100 VALVES
SECTION 15101 TESTS – PIPING SYSTEM
SECTION 15120 PIPING SPECIALTIES
SECTION 15140 PIPE HANGERS & SUPPORTS
SECTION 15141 NON PENETRATING PIPE HANGERS AND SUPPORTS
SECTION 15150 METERS
SECTION 15240 VIBRATION ISOLATION MECHANICAL EQUIPMENT / NOISE CONTROL
SECTION 15250 MECHANICAL INSULATION
SECTION 15330 FIRE PROTECTION
SECTION 15410 PLUMBING PIPING
SECTION 15412 SUMP PUMPS/CONDENSATE LIFT PUMPS/SEWAGE EJECTOR
SECTION 15430 PLUMBING SPECIALTIES
SECTION 15480 SPECIAL SYSTEMS
SECTION 15481 GREASE HOOD FIRE SUPPRESSION
SECTION 15482 FACTORY FABRICATED PACKAGED HEATING MAKE-UP AIR UNITS
SECTION 15510 HVAC PIPING
SECTION 15520 STEAM AND CONDENSATE PIPING - ALTERNATE
SECTION 15530 REFRIGERANT PIPING
SECTION 15540 PUMPS
SECTION 15545 CHEMICAL TREATMENT
SECTION 15575 GAS VENT /COMBUSTION AIR INTAKE
SECTION 15780 AIR CONDITIONING UNITS
SECTION 15786 DUCTLESS AIR CONDITIONING SYSTEMS

Allamakee Community School District
Middle School HVAC Upgrades

A&J #202503.00
Axiom #9166-10000

SECTION 15815 HUMIDITY CONTROL
SECTION 15830 TERMINAL UNITS
SECTION 15835 RADIANT HEATERS
SECTION 15850 AIR HANDLING EQUIPMENT
SECTION 15865 ENERGY RECOVERY VENTILATORS
SECTION 15880 FIRE DAMPERS
SECTION 15885 AIR CLEANING
SECTION 15886 UVGI AIR CLEANING
SECTION 15890 DUCTWORK
SECTION 15910 DUCTWORK ACCESSORIES
SECTION 15950 AUTOMATIC CONTROL – ALTERNATE
SECTION 15955 VARIABLE FREQUENCY DRIVES
SECTION 15990 TESTING, ADJUSTING, AND BALANCING

DIVISION 16 - ELECTRICAL SYSTEMS

SECTION 16010 ELECTRICAL GENERAL PROVISIONS
SECTION 16111 CONDUIT SYSTEMS
SECTION 16120 WIRE AND CABLE
SECTION 16140 WIRING DEVICES AND PLATES
SECTION 16160 CIRCUIT BREAKER PANELBOARDS
SECTION 16170 DISCONNECT SWITCHES
SECTION 16450 GROUNDING & BONDING
SECTION 16471 BRANCH CIRCUIT WIRING
SECTION 16476 FUSES
SECTION 16510 LIGHTING FIXTURES
SECTION 16511 LIGHTING CONTROLS
SECTION 16660 WIRING FOR EQUIPMENT FURNISHED BY OTHER SECTIONS
SECTION 16721 ADDRESSABLE FIRE ALARM SYSTEM
SECTION 16722 STRUCTURED WIRING SYSTEM
SECTION 16750 MEDIUM VOLTAGE CABLES
SECTION 16751 MEDIUM VOLTAGE TRANSFORMERS
SECTION 16752 SWITHBOARDS

END OF DOCUMENT 00010

Allamakee Community School District
Middle School HVAC Upgrades

A&J #202503.00
Axiom #9166-10000

**SECTION 01100
SUMMARY
ADDENDUM ONE**

**PART 1.
GENERAL**

1.1. SUMMARY

- A. This Section includes the following:
 - 1. Work covered by the Contract Documents
 - 2. Work phases.
 - 3. Work under other contracts.
 - 4. Use of premises.
 - 5. Owner's occupancy requirements.
 - 6. Specification formats and conventions.

- B. The Design Professional estimates the construction cost of the base bid and alternate work as follows.
 - 1. To Provide Base Bid (excluding the base bid control alternate) plus Allowance at the Middle School HVAC Upgrades is estimated between \$1,526,000 and \$2,344,000.
 - 2. Alternate No.1 to provide control system alternate for base bid work, excluding controls for alternate work is estimated between \$170,000 and \$200,000.
 - 3. Alternate No. 2 to provide Humidification system s for base bid DOAS and air handling systems including controls are estimated between \$60,000 and \$80,000.
 - 4. Alternate No. 3 to provide Total Remodeling work specified for Middle School Stage and Auditorium is estimated between \$330,000 \$380,000.
 - 5. Alternate No. 4 to provide new hot water heaters, piping, controls, electrical service, at East Elementary School Stage is estimated between \$12,000 and \$25,000.
 - 6. Alternate No. 5 to provide new stage curtains at the East Elementary School and the Middle School Stage is estimated between \$5,000 and \$10,000.
 - 7. Alternate No. 6 to replace windows at East Elementary School as indicated is estimated between \$\$15,000 and \$20,000.
 - 8. Alternate No.7 to provide new floors to replace old asbestos tiles at East Elementary School as specified is estimated between \$46,800 and \$60,800
 - 9. Alternate No. 8 to provide new lights for Middle School Auditorium and Gymnasium is estimated between \$7,500 and \$10,500.

1.2. WORK COVERED BY CONTRACT DOCUMENTS

- A. Project Identification: Allamakee Community School District, Middle School HVAC Upgrade
 - 1. General Project Location: Middle School and High School, Waukon, Iowa for base bid and control system work for the base bid, some alternate work.
 - 2. Alternate Work Location: East Elementary School

- B. Owner: Allamakee Community School District
 - 1. Owner's Representative: Superintendent Jay Mathis, 563.568.3409
 - 2. Director of Facilities: Tyler Plein, 563.568.3409

Allamakee Community School District
Middle School HVAC Upgrades

A&J #202503.00
Axiom #9166-10000

3. Superintendent Mathis may designate another District employee as his representative to attend project meetings.

C. Design Professionals:

1. Mechanical and Electrical: Contact Joe Lomheim, Axiom Consultants, Iowa City at 712-490-5533.
2. Architectural and Structural: Contact Robert Peck, Design Dynamics, Cedar Rapids at 319-298-0400.
3. Overall Design Coordination: Contact Victor Amoroso, A&J Associates at 319-333-9955.

The Work consists of the following:

4. The Middle School work shall be completed in one overall phase that will allow the new HVAC system to provide heat over the 2026-2027 fall/winter heating season by October 16, 2026, and the cooling and ventilation components to provide cooling and ventilation by August 14, 2026.
5. Base bid and alternate work inside classrooms must be completed on or before August 7, 2026.
6. Security cameras, fire alarms, corridor floors, new domestic water piping, and waste and vent to and from existing plumbing fixtures, and new entryways must be completed on or before August 7, 2026. Contractor shall prepare work schedules, overtime, and off normal working hours to meet these deadlines.
7. The work shall include the heating upgrades and shall occur during the spring/summer/fall seasons, and shall not disrupt classes.
8. The base bid work shall include the following major items.
 - (1) Remove existing hot water classroom unit ventilators as specified. Provide new perimeter heating radiant panels or strips as specified. Provide new insulated metal covers over the outdoor intake opening on the interior walls under base bid and alternate bids to provide new windows and ACM panels at the window openings. Remove thermostats, controllers, control wiring connected to the removed class room unit ventilators.
 - (2) Coordinate the removal of the unit ventilators with asbestos floor tile and mastic removal within the rooms in the specified project area. Asbestos and lead paint remediation / removal shall be provided by the Owner under separate contracts.
 - (3) Coordinate the removal of items for offsite storage with hazardous material (asbestos and lead paint) abatement and removal contractor and Allamakee CSD.
 - (4) Provide new hot water heating piping, control valves, isolation and balance valves to new perimeter radiant heating panels and strips.
 - (5) Remove electrical and communication wiring and conduit/raceway serving components specified to be removed to the last active service. Do not abandon in place any disconnected wiring.
 - (6) Remove existing control system components including hot water control valves, control dampers, thermostats, air compressors and instruments for components specified to be removed on the drawings including the unit ventilators. Remove control wiring and pneumatic control tubing between controllers and controlled items specified to be removed
 - (7) Dispose of removed items in a lawful manner.
 - (8) Connect the new Middle School HVAC control systems to the existing High School, Middle School, and West Elementary School campus control system head end components located in the Middle School and the alternate control work at East Elementary School to the East Elementary School controls system.

Allamakee Community School District
Middle School HVAC Upgrades

A&J #202503.00
Axiom #9166-10000

- (9) Provide ductless mini split air conditioning air cooled heat pumps to provide cooling and heating to the Middle School classrooms and specified office areas indicated under both base and alternate bids.
- (10) Provide a new dedicated outside air systems (DOAS) to supply and exhaust ventilation air to the individual rooms, and to provide back-up heating for the ductless mini split heat pump systems.
- (11) Provide supply and return/exhaust system ductwork to distribute ventilation air from the roof top DOAS systems.
- (12) Provide miscellaneous heating and ventilation components such as fin tubes, radiant heating strips, radiant heating panels, fans and hot water unit heaters to provide supplemental heating and ventilation.
- (13) Provide new central station air conditioning units for the Middle School Kitchen, Dining, Woodworking classroom, and Art Room spaces.
- (14) Provide new refrigerant piping for the ductless mini split systems that will provide either cooling or heating depending on the season.
- (15) Provide new electric equipment and wiring and make electrical connections to new mechanical equipment and new lighting.
- (16) In new drop ceilings provide new communication and power wire for speakers in new drop ceilings, rerouting of communication wiring for new projector locations, new power outlets for new projector locations, and corridor security cameras that must be dropped in new ceilings.
- (17) Test and balance the revised existing hot water heating system before and after new hot water piping has been installed.
- (18) Test and balance the DOAS and central system air handling units' air side and the new ducted air distribution system under both Base Bid and Alternates.
- (19) Test for sound levels in rooms with new HVAC ductless mini split units under both base bid and Alternates.
- (20) Remove existing light fixtures in classroom indicated. Reuse some of the removed light fixtures in the attic spaces as indicated on the drawings. Turn over the removed fixtures not used in the attic spaces to the district. Provide new LED lights and associated lighting controls in the classrooms and corridors indicated in Middle School. Coordinate this light fixture exchange with the District.
- (21) Remove existing windows under both base bid and alternates as specified on the drawings.
- (22) Provide new windows as indicated. Include structural lintels for all new windows under base bid and alternate work.
- (23) Provide manual roller shades for the base bid class rooms, and for class rooms indicated on the drawings under the different alternates.
- (24) Remove failing masonry work around windows and ceramic tiles above and around the windows and refinish as specified on the drawings.
- (25) Provide new acoustical tile ceilings as indicated on the drawings. Refer to architectural drawings for all locations. New ceilings are required for both Base Bid work and Alternate work.
- (26) Relocate existing ceiling mounted devices such as speakers, carbon monoxide detectors, security cameras, fire/smoke detectors and miscellaneous items in the new ceilings. Extend communication and power wiring to new locations for these ceiling mounted items. **Security cameras shall be reinstalled and made functional before school starts after summer recess.**
- (27) Provide new walls and enclosures where indicated on the drawings.
- (28) Provide new room doors and reuse existing hardware or replace with new hardware as indicated on the drawings and in the specifications.

Allamakee Community School District
Middle School HVAC Upgrades

A&J #202503.00
Axiom #9166-10000

- (29) Seal duct, pipe and conduit penetrations made in corridor walls and floors. **Provide fire dampers at any and all duct penetrations of the corridor fire walls, and at cross corridor fire barriers indicated on the architectural drawings.**
 - (30) Under the base bid and alternate work touch up paint all walls in all rooms where any construction work is specified to occur, and in any other rooms so indicated on the drawings.
 - (31) Repair draft stops in the attic spaces as indicated on the drawings. Blow in fiberglass insulation into the attic to replace that was removed or disturbed during construction, and supplement existing compacted insulation to the depth specified on the drawings.
 - (32) Provide pitched roof structural reinforcement as indicated on the drawings.
 - (33) Provide incidental fire alarm system connection from new or relocated fire alarm to the existing fire alarm system throughout project area indicated
 - (34) Provide patch and repair of walls and floors around the locations where the existing floor mounted unit ventilators were removed and not returned to that space.
 - (35) Provide replacement flooring material for areas where hazardous materials (asbestos floor tiles) are specified to be removed under both base bid and alternate work.
 - (36) Provide city street/road, asphalt parking lot, sidewalk, landscape repair required because of damage caused by the project construction.
 - (37) Personnel removing and reinstalling the existing security cameras shall be technicians certified to work on security systems. The contractor shall submit the qualifications of the proposed individuals who will be working on the security camera system.
 - (38) The Owner currently has a carbon monoxide (CO) sensing system installed in the project areas. This existing CO system is not "tied" into the fire alarm system. Provide new CO monitors as required by IBC to monitor and control CO levels in class rooms served by the new gas fired DOAS units. Also, tie the new CO monitors into the existing CO alarm system.
 - (39) Provide new heating hot water boiler circulating pumps as indicated on the drawings. Provide incidental power, boiler interface controls, insulation and supports for the new pumps.
 - (40) Provide new refrigeration equipment for the kitchen walk in cooler and freezer. Remove existing equipment and dispose of lawfully. Provide new refrigerant piping, refrigerant, electrical connections, calking, roof repair, incidental architectural patching, and support structures for the outdoor condensing units.
 - (41) Provide new replacement transformer and transformer pad, new conduit and conductors for primary and secondary voltage sides. Transformer installation shall be in accordance with Alliant Energy standards and specifications.
 - (42) Provide new ventilation and air conditioning systems for the Middle School and High School locker rooms and associated coaches offices.
 - (43) Any alternate work shall include the necessary demolition work specified to precede the alternate work.
9. The Contractor shall coordinate all aspects of the work with the services schedule of Allamakee Community School District.
- D. Project will be constructed under a single prime contract.
- E. The Owner will provide the following under separate contracts.

1. Testing and remediation or removal of any asbestos containing material or lead paint in the project area will be provided by the Owner.
 2. Refer to the Special Conditions Section of the Project Manual for more specifics on the hazardous material in the project area.
 3. There may be asbestos in the existing pipe fittings and in the pipe tunnels
 4. Asbestos has been found in the existing floor tiles.
 5. Asbestos has been found in the old built up roofing material that is covered with blown in insulation.
 6. Flexible connectors in existing air handling units specified to be removed and replaced contain asbestos material.
 7. The presence of any lead paint will have to be determined by testing under a separate contract.
 8. The project work shall be coordinated and phased with the hazardous material removal and abatement work.
- F. **The roofs at the Middle School have existing warranties maintained by the following listed roofing contractor. The contractor shall contact this roofing contractor to do any needed roofing repair on the project. Modifications to the roof to place equipment and to make the necessary penetrations shall be in accordance with requirements of the existing roof warranties, and per recommendations of the roofing contractor.**
1. **Moss Roofing, 310 Highway 150 South, West Union, Iowa 52175.**
 2. **Telephone contact is 563-422-3331.**
 3. **Contact is Chris Moss.**

1.3. USE OF PREMISES

- A. General: Contractor will have full use of the existing Middle School and East Elementary School boiler rooms, and electric equipment rooms, for construction operations, including use of Project site, during the construction period regardless of whether students are in session or not. The only limitation to the full access is that Contractor shall not crane in equipment and materials to the roof and attic areas whenever the students are occupying the building.
- B. The Contractor will have use and access to the entire Middle School and East Elementary School when the students are away for the summer break.
- C. Storage of construction related materials and access to the School shall be coordinated with the Superintendent Mathis or his designate.
- D. Use of Site: Limit use of premises to work in areas indicated. Do not disturb portions of Project site beyond areas in which the Work is indicated.
1. Owner Occupancy: Allow for continuous Owner and separate contractor occupancy of Project site and use by the public.
 2. Driveways and Entrances: Keep driveways, loading areas, alley ways and entrances serving premises clear and available to Owner, Owner's employees, and emergency vehicles at all times. Do not use these areas for parking or storage of materials.
 - a. Schedule deliveries to minimize use of driveways and entrances.
 - b. Schedule deliveries to minimize space and time requirements for storage of materials and equipment on-site.
 3. The playground areas located as indicated on the drawings shall not be used for contractor material and equipment storage. The contractor shall not stage or place equipment on the playground surfaces unless there is no other way to complete the construction. An example of this might be installation of new windows on the north, south and east sides of the school buildings. Any such ex-

traordinary use of the playground areas shall be cleared with the Superintendent and Director of Facilities.

- E. Use of Existing Building: Maintain existing building in a weather-tight condition throughout construction period. Repair damage caused by construction operations. Protect building and its occupants during construction period.
 - 1. Place protective surfaces on existing gym floors when performing work in the gym areas.
 - 2. Contractor shall provide temporary weather proofing material while removing old windows and replacing with new windows.

1.4. OWNER'S OCCUPANCY REQUIREMENTS

- A. Full Owner Occupancy: Owner will occupy the School premises adjacent to the equipment rooms and the existing boiler rooms and other rooms during part of the construction period, with the exception of areas under construction. Cooperate with Owner during construction operations to minimize conflicts and facilitate Owner usage. Perform the Work so as not to interfere with Owner's operations. Maintain existing exits, unless otherwise indicated.
 - 1. Maintain access to existing walkways, corridors, and other adjacent occupied or used facilities. Do not close or obstruct walkways, corridors, or other occupied or used facilities without written permission from Owner and authorities having jurisdiction.
 - 2. **Construction activities shall not cause the displacement of students during the official school year. Contractors shall work off hour shifts and on weekends during the school year when students are scheduled to be in the classrooms as needed to complete the work.**
 - 3. **Contractors may work any time when students are in school in areas where the student will not be. This would include the existing boiler rooms, utility tunnels and outside of the buildings.**
- B. Owner Use of Completed Parts of Construction: Owner reserves the right to use equipment in completed areas of building, before Substantial Completion of the entire project, provided such use does not interfere with completion of the Work. Such use of equipment shall not constitute acceptance of the total Work.
 - 1. Contractor may prepare a Certificate of Substantial Completion for the entire project that recognizes early use of portions of the project.
 - 2. Design Professional and Owner will review the phased substantial completion request and reject or approve the phase substantial completion request. The Owner's and Design Professional's decision is final.
 - 3. **Note that Substantial Completion denotes the request for all payment except for the retainage held back. The Date of Substantial Completion does not start the warranty period.**

1.5. SPECIFICATION FORMATS AND CONVENTIONS

- A. Specification Format: The Specifications are organized into Divisions and Sections using the 16-division format and CSI/CSC's "Master Format" numbering system.
 - 1. Division 1: Sections in Division 1 govern the execution of the Work of all Sections in the Specifications.

- B. Specification Content: The Specifications use certain conventions for the style of language and the intended meaning of certain terms, words, and phrases when used in particular situations. These conventions are as follows:
1. Abbreviated Language: Language used in the Specifications and other Contract Documents is abbreviated. Words and meanings shall be interpreted as appropriate. Words implied, but not stated, shall be inferred as the sense requires. Singular words shall be interpreted as plural and plural words shall be interpreted as singular where applicable as the context of the Contract Documents indicates.
 2. Imperative mood and streamlined language are generally used in the Specifications. Requirements expressed in the imperative mood are to be performed by Contractor. Occasionally, the indicative or subjunctive mood may be used in the Section Text for clarity to describe responsibilities that must be fulfilled indirectly by Contractor or by others when so noted.
 - a. The words "shall," "shall be," or "shall comply with," depending on the context, are implied where a colon (:) is used within a sentence or phrase.

1.6. PROJECT REPORTING

- A. Refer to pay application requirements for reporting.

1.7. SALVAGE OF REMOVED ITEMS

- A. The Contractor shall remove and dispose of all items indicated on the drawings to be removed in a lawful manner.
- B. Under the base bid or alternates the Owner has no intention of claiming the hot water heaters, unit ventilators, control valves, steam traps, ceiling components, pumps for salvage, unless specifically indicated on the drawings.
- C. Turn over the removed light fixtures to the Owner. Coordinate the turn over with the Director of Facilities, Tyler Plein.
- D. The Owner will remove the existing window air conditioning units and retain those units for salvage.

1.8. ALTERNATES

1. Alternate No.1 Provide control system alternate ABB/Automatrix for base bid work, excluding controls for alternate work.
2. Alternate No. 2 Provide Humidification system for base bid DOAS and air handling systems including ABB/Automatrix controls.
3. Alternate No. 3 Provide total remodeling work specified for Middle School Stage and Auditorium.
4. Alternate No. 4 to provide new hot water heaters, piping, controls, electrical service, for the East Elementary School stage.
5. Alternate No. 5 to provide new stage curtains at the East Elementary School Stage and at the Middle School stage.
6. Alternate No. 6 to replace windows East Elementary School as indicated.
7. Alternate No.7 to provide new floors to replace old asbestos tiles as specified for East Elementary School.

8. Alternate No. 8 to provide new lights for Middle School Auditorium and Gymnasium.

1.9 ALLOWANCE

- A. Refer to Special Conditions for contract requirements for the allowances specified.

PART 2. PRODUCTS (Not Used)

PART 3. EXECUTION (Not Used)

Allamakee Community School District

Middle School HVAC Upgrades

A&J #202503.00

Axiom #9166-10000

SECTION 15482
FACTORY FABRICATED PACKAGED HEATING MAKE-UP AIR UNITS
Addendum One

PART 1 - GENERAL

1.1 SUMMARY

- A. This section includes modular packaged heating units capable of supplying up to 100 percent outdoor air.
- B. The units shall be provided by Captive Air or Design Professional approved equivalent.

1.2 QUALITY ASSURANCE

- A. ETL-Listed to the American National Standard/CSA Standard for Gas Unit Heaters and Gas-Fired Duct Furnaces ANSI Z83.4, CSA 3.7.
- B. ETL-Listed to the American National Standard/CSA Standard for Gas Unit Heaters and Gas-Fired Duct Furnaces ANSI Z83.4, CSA 3.7, and Z83.18. (Recirculating)
- C. The Safety Control Board is ETL-Listed to standards UL 60730-2-9, UL 60730-1; CSA E60730-1, and CSA E60730-2-9.

1.3 WARRANTY

- A. All units are provided with the following 2-year standard warranty.

PART 2 - PRODUCTS

2.1 GENERAL ASSEMBLY

- A. Unit(s) shall be factory assembled, tested and shipped as a complete packaged assembly, for indoor or outdoor mounting, consisting of the following specifications, deliver all capacities scheduled, and conform to design indicated herein. Alternate layouts or dimensional changes will not be accepted.

2.2 CABINET

- A. Unit(s) shall be constructed of minimum 20-gauge G-90 galvanized steel riveted together via structural pop-rivets. All metal shall be CNC bent for precise assembly.
 - 1. Base Construction: The base shall be constructed of galvanized steel for improved rigidity. Base shall be structurally reinforced to accommodate the blower assembly and burner.
 - 2. Rigging Provisions: The unit shall have a structural base constructed of minimum 14-gauge G-90 galvanized steel, and include lifting points on all four sides.
 - 3. Roof Construction: Roof shall be pitched to allow for proper drainage.
 - 4. Exterior Wall Construction: All exterior walls shall consist of insulated galvanized steel construction.
 - 5. Service Access Doors: All door jambs shall be gasketed around their perimeter. Doors may be mounted via spring actuated, stainless steel hinges with stainless steel rivets, and self-compressing stainless steel pad lockable latches or through removable sliding panels.

6. Each compartment shall have removable access panels to allow for ease of service and maintainability. Electrical cabinet doors shall be outfitted with manual pouches mounted on the door, along with wiring diagram attached to the indoor from the factory.
- B. Entire interior and exterior casing shall be constructed of minimum 20-gauge G-90 galvanized steel with no painting, and shall have undergone a salt spray corrosion test as per ASTM B 117.
- C. An observation port shall be located on the exterior of the unit for observation of the main flame and pilot flame. All controls, gas valves, modulating controls and electrical components shall be mounted within the burner vestibule. The burner vestibule shall be an integral part of the unit and not extend outside the exterior casing of the unit and not exposed to the main air stream.

2.3 AIRFLOW CONFIGURATIONS

- A. Refer to drawings and equipment schedules for intake and discharge configuration.
- B. 100 percent outdoor air unit - The intake airflow configuration shall be through use of a fresh/outdoor Damper.
 1. Damper: Manufacturer shall provide and install on unit, when possible, a two-position, motor-operated damper with internal end switch to energize the blower-starter circuit, when damper is 80% open. Blades shall be a maximum of 6" wide 16-gauge G-90 galvanized steel and shall be made to guarantee the absence of noticeable vibration at design air velocities. Damper blades are to be mounted on friction-free synthetic bearings. Damper edges shall have PVC coated polyester fabric mechanically locked into blade edge. Jamb seals used are flexible metal, compression type. Dampers shall exceed AMCA Class 1A standard for low leakage.
 2. Insulated Damper: Shall be thermally broken with an insulation R-value = 5.
 3. Discharge Diffuser: Shall be constructed of G-90 galvanized steel with horizontal and vertical blades capable of four-way diffusion.
 4. Actuator: A single direct drive damper actuator shall be used with spring return to ensure that the outdoor air section opens when not powered.

2.4 SUPPLY AIR BLOWER AND MOTOR

- A. All supply fans shall be:
 1. Direct Drive: Blower assembly shall consist of a centrifugal backward inclined, non-overloading wheel secured directly to a heavy-duty, ball bearing type motor via two set screws. The motor and wheel assembly shall be mounted to a heavy gauge galvanized steel frame. The motor shall be controlled by a variable frequency drive, allowing for variable airflow without the need of belts and pulleys.
 2. Direct drive variable frequency drive control shall be used for balancing air flow. It shall not be used to vary flow during operation.
- B. Blower Motor: Motor shall be a premium efficiency motor available as:
 1. Totally Enclosed Fan Cooled (TEFC) motor driven by a Variable Frequency Drive.

2. Electronically Commutated Motor (ECM).
- C. Fans to be selected at or near efficiency peak. Check fan curves provided with job.
- D. Blower and motor assembly shall be dynamically balanced. The entire blower and motor assembly shall be mounted on rubber vibration isolators. Wheels balanced as per AMCA 204-96; Balance Quality and Vibration Levels for fans.

2.5 VARIABLE AIR VOLUME FOR AIR FLOW BALANCING

- A. VFD Manual - Blower will communicate with VFD. VFD will run at user defined static speed set through HMI.
- B. ECM Manual - PWM output signal for ECM. ECM speed set by user through HMI.

2.6 SHAFTS AND BEARINGS

- A. Shafts shall be precision ground and polished. Heavy duty, pre-lubricated bearings designed for, and individually tested, specifically for use in air handling applications.

2.7 HEATING SYSTEM

- A. The gas burner shall be natural gas at an inlet-supply pressure to the unit of 7" W.C. minimum natural gas.
- B. Burner design shall be capable of using natural gas. Burner ignition shall be of the direct-spark design with remote flame sensing at the pilot assembly to detect the presence of flame in the burner.
- C. Direct-sparking sequence shall last through the complete duration of the trial for ignition period for guaranteed light-off. Each burner ignition module shall have LED indicators for troubleshooting and a set of exposed prongs for testing flame indication signal.
- D. Unit should include self-adjusting burner profile plates, which ensure proper air velocity and pressure drop across the burner for clean combustion. Spring-loaded profile plates should react to the momentum of the fresh air stream. No motors or actuators are needed to drive them, nor should they need to be manually set to a specific position. Units should be capable of variable air volume applications.
- E. Each heating section shall have:
 1. The burner shall have non-clogging, stainless steel combustion baffles attached to a ductile aluminum gas-supply section with no moving parts to wear out or fail. The burner shall be capable of 92% combustion efficiency with a maximum turndown ratio of up to 30 to 1.
 2. Stainless steel Quick Seal Connection for gas connection.
 3. Manifold and Input gas pressure gauges.
 4. Inlet pressure gauge installed on the gas manifold (0-15#).
 5. Inlet pressure gauge installed on the gas manifold (0-35" WC).
 6. Inlet pressure gauge installed on the gas manifold (0-5#).
 7. Inlet pressure gauge installed on the gas manifold (-5 to 15" WC).
 8. High gas-pressure switches to disable heating if gas pressure is too high.

9. Provide the pressure gauges for the inlet gas pressure specified on the drawings.
10. Low gas pressure switch to disable heating if the gas pressure is too low.
11. Proof-of-closure switch to energize the main-burner circuit only if the motorized gas valve is in a closed position.

2.8 FILTERS

- A. Provide filters as part of unit. All filters shall be furnished and installed to meet the performance requirements set forth in the schedule and as specified under another section of this work.
- B. The filters shall be 2" thick, aluminum mesh coated with super-filter adhesive, aluminum mesh with polyester foam or pleated throw away. Aluminum-mesh filters shall have aluminum frames with media to be layers of slit and expanded aluminum, varying in pattern to obtain maximum depth loading. Washable 2" filters shall be enclosed in two-piece, die-cut frame with diagonal supports. Frame shall be constructed of heavy-duty beverage board. Filter media is supported on the air leaving side by a metal grid.
- C. All filters shall be installed on tracks for easy removal from the unit.
- D. Shall be either insulated or non-insulated constructed of G-90 galvanized steel with filters supported by internal slides and with removable access panels.
- E. Unit shall have an optional adjustable pressure differential sensor for the filter bank to alert in the event of a clogged filter.

2.9 ELECTRICAL

- A. All controls shall be pre-wired and housed in an insulated electrical cabinet within the unit to protect against risk of condensation.
- B. All direct fired units shall be provided with single point electrical connection.
- C. Unit shall be provided with a door safety switch that de-energizes the supply fan when the door is opened.
- D. Units shall be provided with a factory mounted averaging intake air temperature sensor to allow for accurate intake temperature reading regardless of how the OA/RA dampers are positioned.
- E. The electrical cabinet shall be outfitted with the following:
 1. LED electrical cabinet service light with automatic activation upon door switch.
 2. Color wiring schematics, laminated to the interior wall of the cabinet doors.
 3. Factory mounted disconnect with unit bottom knockouts.
 4. A LED backlit, LCD Human-Machine Interface (HMI) shall be mounted within the unit's control cabinet to allow for all set points configuration and refrigeration system monitoring at the unit.
 5. Up to 4 additional space HMIs/wall mounted sensors are available. Verify wiring and/or CAT5/6 cables will be factory or field supplied.

- Optional space HMIs shall allow for full programming capabilities and are outfitted with integral temperature and humidity sensors. Additional HMIs shall be capable of being individually averaged for space temperature/humidity readings. All HMIs shall be wired using standard CAT5/6 cables.

2.10 CONTROLS

- A. Unit shall be outfitted with a control board to allow for full control of the entire unit.
- B. Provide onboard air flow switch located on MUA control board to sense air flow.
- C. All unit controls shall be compatible with BACnet and LonWorks based building management systems.
- D. All units shall be outfitted with CASLink cloud based monitoring, which monitors every point of operation. Provides configurable automated fault alert e-mails, and remote control capabilities.
- E. Integrated cellular module to provide remote connection to monitoring services to view both real time and historical unit operation. Data shall be stored a minimum of 3 years on the cloud. Data sample rate shall be a maximum of 60 seconds.
- F. Temperature Control System:
 - 1. **Discharge Temp Control (Heating)** - Unit modulates the burner flame to accurately maintain the desired discharge temperature set point and compensate for fluctuations in entering air temperature, air volume and % of OA using heating PID controls.
 - 2. **Intake Temp Control (Ventilation Only)** - Unit controls the cooling stage(s) based on intake temperature set point(s) and compensates for fluctuations in entering air temperature, air volume and % of OA.
- G. Activation Controls:
 - 1. **Activate Based on Intake (Heating)** - Unit will activate heating when the intake temperature drops below the desired set point.
 - 2. **Activate Based on Intake (Ventilation Only)** - Unit will activate ventilation when the intake temperature rises above the desired set point.
 - 3. **Activate Based on Either (Heating)** - Unit will activate heating when intake temperature drops below the desired set point.
 - 4. **Activate** fan when hood exhaust fan is activated at the related hood.

2.11 CURBS

- A. Curb shall be factory assembled and constructed of 20-gauge minimum, galvanized or aluminized steel.
- B. Insulation options are 1" and 2" (R13).
- C. Rivet together or fully welded, depending on curb size and length.
- D. Plenum curb. Refer to drawings for non-penetrating roof support.
- E. Factory take-offs are available with plenum curb options.

2.12 VARIABLE FREQUENCY DRIVES

- A. Provide Variable Frequency Drive for speed control on all non-ECM direct drive supply fans.
- B. All VFDs shall provide the following inherent protections:
 - 1. Phase protection
 - 2. Brownout protection
 - 3. Overload/Overheat protection
 - 4. Soft starts to protect bearings/hardware
 - 5. Low & High voltage & over-torque protections

PART 3 - EXECUTION

3.1 EXAMINATION

- A. Examine all areas and conditions under which packaged units are to be installed. Do not proceed with work until unsatisfactory conditions have been corrected in a manner acceptable to Installer.

3.2 INSTALLATION

- A. Install units in accordance with manufacturer's instructions, drawings, written specifications, manufacturer's installation manual and all applicable building codes.

3.3 CONNECTIONS

- A. Piping installation requirements are specified in other Division 15 Sections. Drawings indicate the general arrangement of piping, fittings, and specialties. Install piping to allow service and maintenance.
- B. Duct installation requirements are specified in other Division 15 Sections. Drawings indicate the general arrangement of ducts.
- C. Electrical connections conform to applicable requirements in Division 16 Sections.

3.4 SYSTEM START-UP

- A. System start-up is performed by a factory-trained Service Technician.

**Allamakee Community School District
Middle School HVAC Upgrades**

A&J #202503.00
Axiom #9166-10000

**SECTION 15865
ENERGY RECOVERY VENTILATORS
Addendum One**

PART 1. GENERAL

1.1. SECTION INCLUDES

- A. Provide the energy recovery section (fan, filter and heat recovery section only) for use with the DOAS units specified.
- B. Provide the energy recovery ventilator sections for the DOAS units.

1.2. SUBMITTALS

- A. Submit manufacturer's catalog cuts showing complete descriptive data.
- B. Submit operating and maintenance manuals for the units.

1.3. WARRANTY

- A. Provide a manufacturer's standard warranty for a period of two (2) years from the date of final acceptance of the project by the Owner.

PART 2. PRODUCTS

2.1. MANUFACTURERS

- A. Acceptable Stand Alone Energy Recovery Ventilator Manufacturers:
 - 1. Trane
 - 2. Renew Air
 - 3. York
 - 4. Greenheck
 - 5. Design Professional Approved Equivalent

2.2. MATERIALS

- A. Energy Recovery Ventilation – Energy Heat Exchanger/ Supply / Exhaust Fans
 - 1. Energy exchange. Recovery cell shall be the energy recovery cell providing the desiccant media energy exchange. Recovery cell shall provide total energy recovery with a rotating wheel and drive motor.
 - 2. Energy transfer shall be both sensible and latent heat
 - 3. Unit shall be capable of operating without condensation.
 - 4. The energy recovery system shall include powered exhaust to match the powered supply of the DOAS unit.
 - 5. Provide fans, fan motors, filters and dampers specified.
 - 6. Freeze protection of the unit shall be provided by Section 15950 by repositioning dampers and placing unit in the recirculation mode or by de-energizing fans as specified in the control sequence, or by slowing rotation of the wheel energy recovery.
 - 7. Provide unit mounted disconnect switches for fan and energy recovery wheel motors.
 - 8. Provide controllers and control to interface with the HVAC control system.

**Allamakee Community School District
Middle School HVAC Upgrades**

A&J #202503.00
Axiom #9166-10000

9. Capacities and efficiencies of the units shall be as specified on the drawings.
 10. Provide filter racks within the ventilator to accept MERV 8 on the exhaust stream and MERV 8 on the supply air. Supply and exhaust air stream filter shall be protecting the rotating wheel media.
 11. Freeze protection shall be provided by defrost control, slowing wheel rotation and by closing the outside air intake damper at outside air temperatures below set point.
 12. Provide low voltage and high voltage protection for wheel motor and energy recovery low voltage controls.
 13. The energy recovery ventilators shall not "backwards upon start-up of the DOAS / ERV combination.
- B. Access doors shall be provided on all air entering and air leaving sides of heat exchange coils to allow for maintenance, cleaning and removal. Access doors shall be constructed per Section 15850 for air handling units.

PART 3. EXECUTION

3.1. INSTALLATION


- A. Install the energy recovery ventilators under base bid and alternates in accordance with the manufacturer's instructions.

3.2. BALANCING AND SET UP

- A. Set up the separate supply and exhaust flow rates to operate in accordance with the control sequence specified.
- B. Remove the supply air intake (outside cold air stream) filters during cold weather to prevent filter freeze up. Replace filter in air intake with onset of warm weather.

END OF SECTION 15865

MATCH LINE

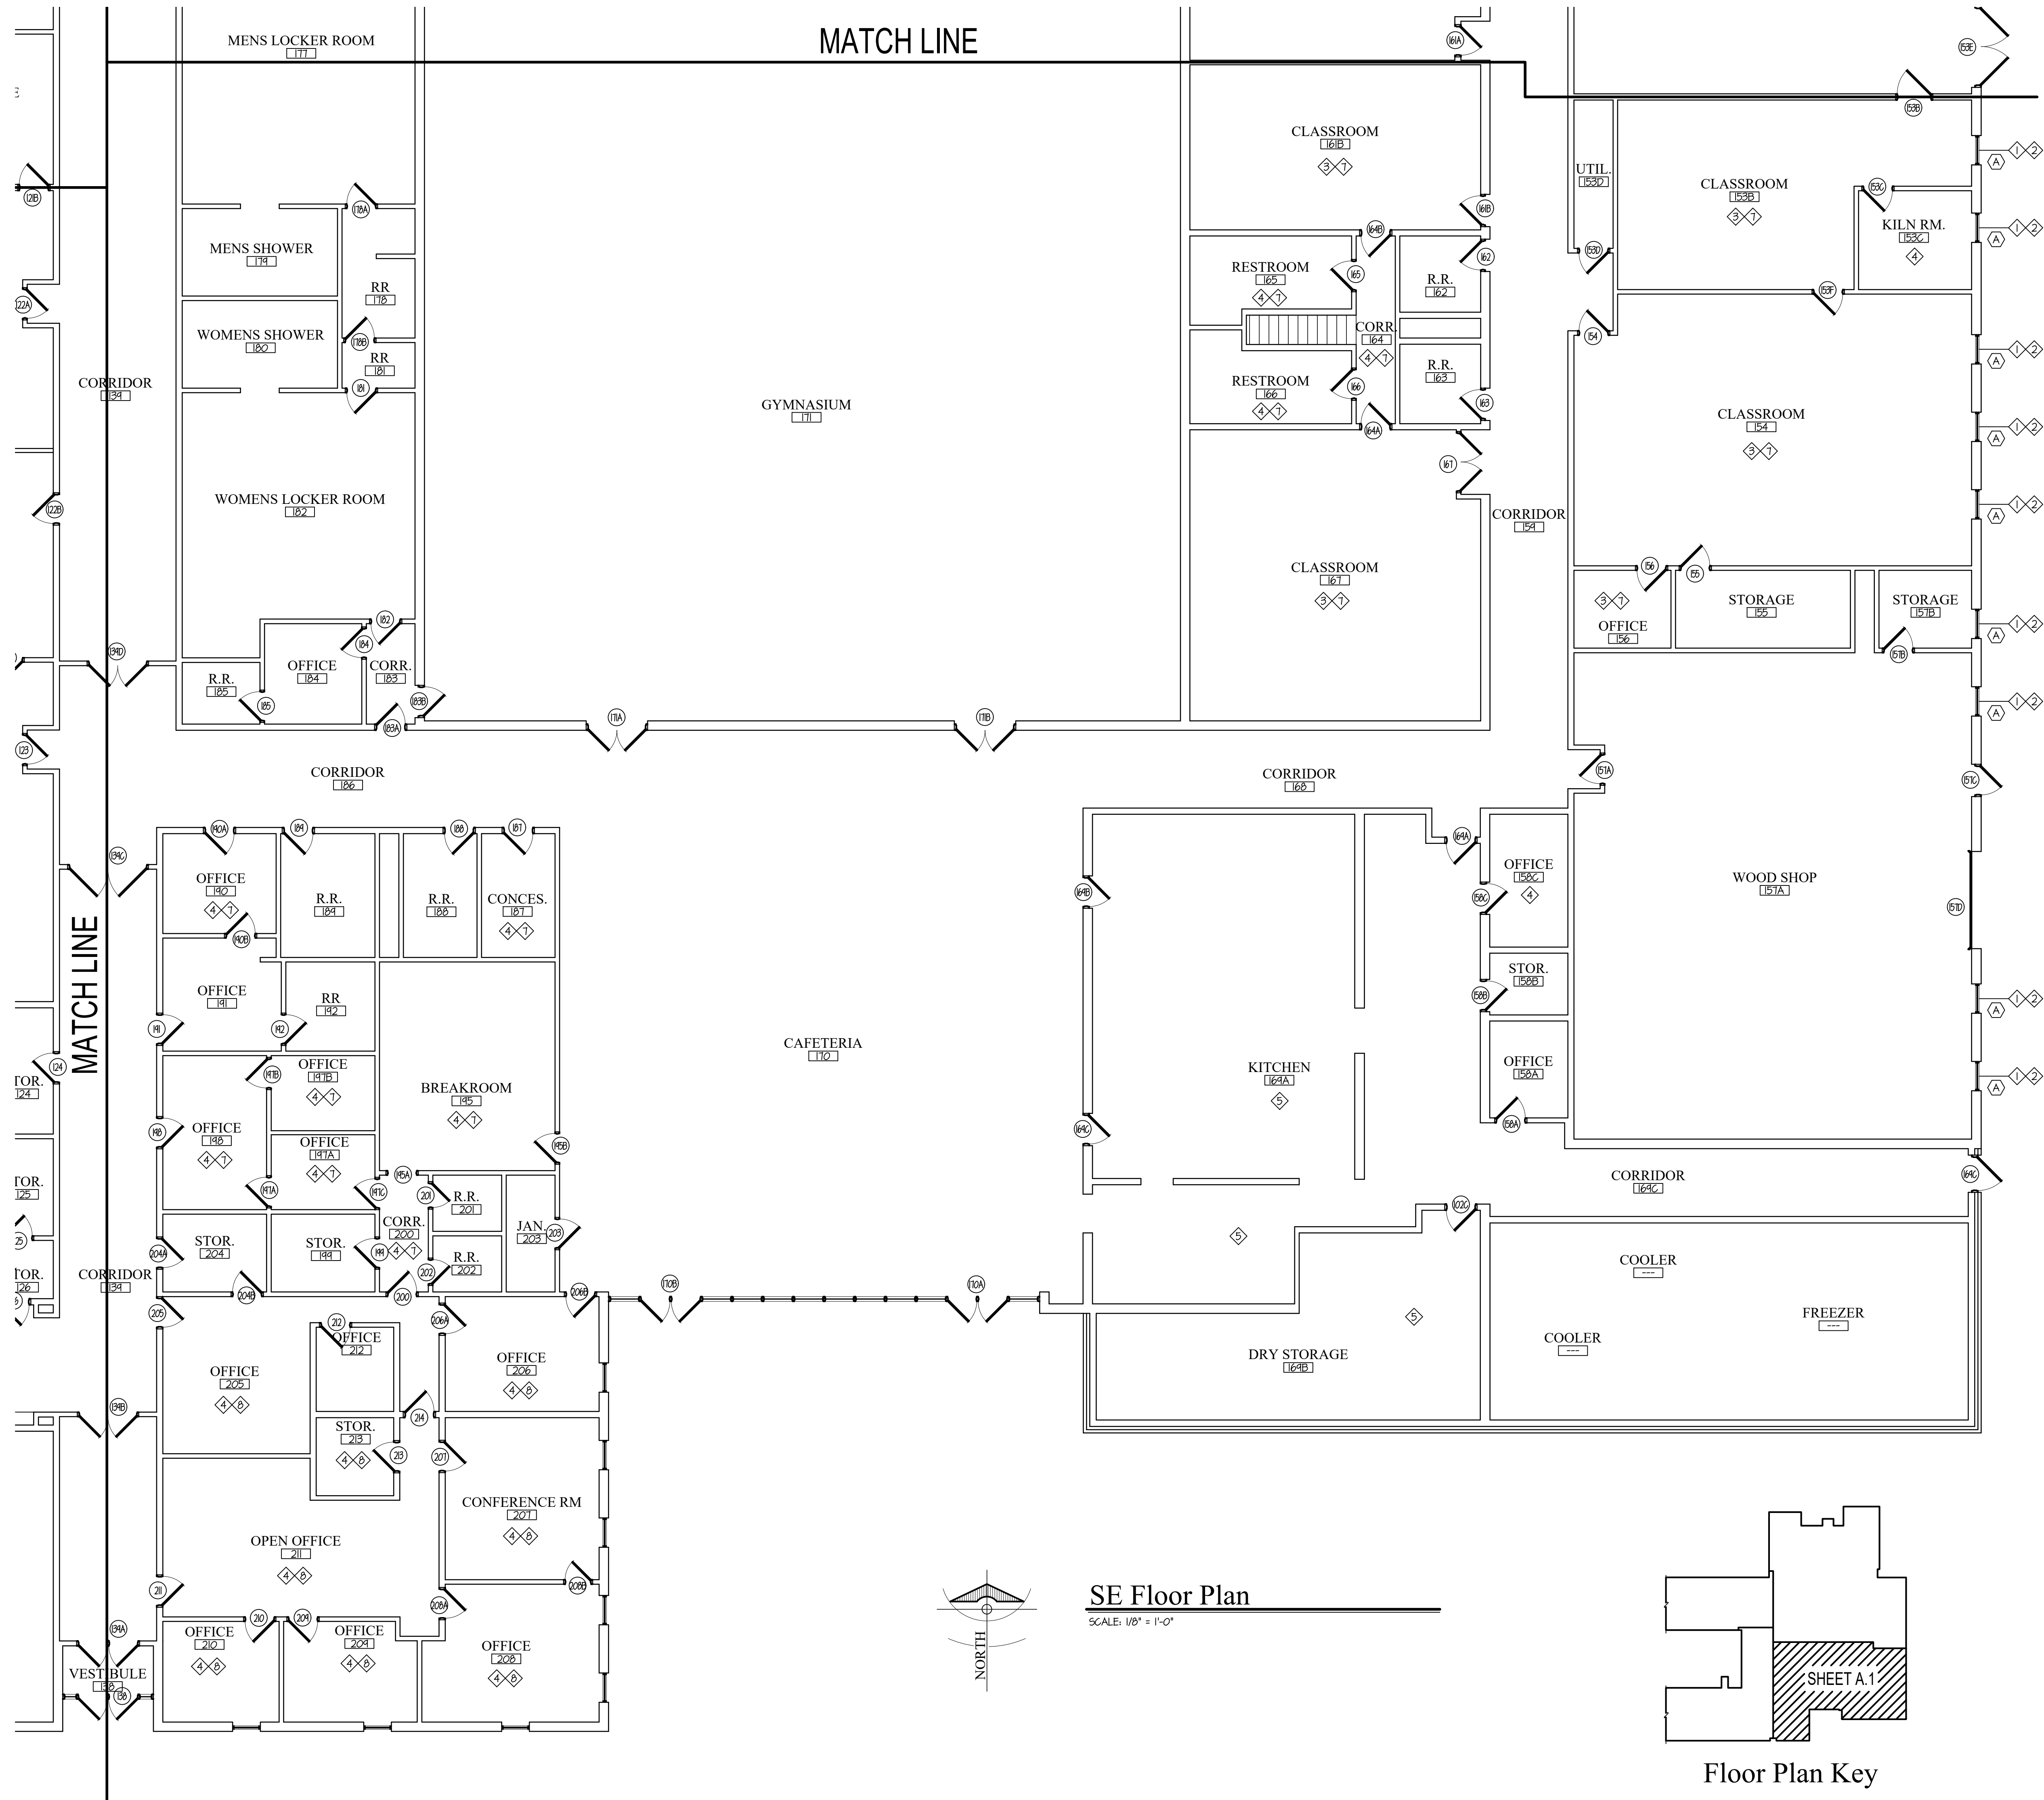

GENERAL NOTES

- ALL WORK ON THIS PROJECT TO BE BUILT IN COMPLIANCE WITH ALL FEDERAL, STATE AND LOCAL BUILDING CODES. CONTRACTOR SHALL BRING TO ARCHITECT'S ATTENTION ALL ITEMS REQUIRING INTERPRETATION.
- ALL CONTRACTORS ON THIS PROJECT MUST BE REGISTERED WITH THE STATE OF IOWA. GENERAL CONTRACTOR SHALL OBTAIN A COPY OF STATE REGISTRATION AND INSURANCE CERTIFICATES FROM EACH CONTRACTOR AND TRANSMIT TO ARCHITECT PRIOR TO START OF CONSTRUCTION.

SYMBOLS LEGEND:

ROOM NAME ROOM NUMBER	DOOR NUMBER	WINDOW TYPE	WALL TYPE	EQUIPMENT TYPE	KEY NOTES	REVISION	COLUMN GRID	ELEVATION MARK	SMOKE DETECTOR	FLOOR DRAIN
SECTION NUMBER BUILDING SECTION SHEET NUMBER	SECTION NUMBER WALL SECTION SHEET NUMBER	DETAIL NUMBER SHEET NUMBER	SHEET NUMBER INTERSECTIONS ELEVATION NUMBER							



ABBREVIATIONS:

A/C AIR CONDITIONING	ALUM ALUMINUM	BD BOARD	BSMT BASEMENT	BRG BEARING	BM BEAM	BLK BLOCK	BLKG BLOCKING	CLG CEILING	CLR CLEAR	COL COLUMN	CONC CONCRETE	CONST CONSTRUCTION	CONT CONTINUOUS	DIA DIAMETER	DN DOWN	DS DOWNSPOUT	DF DRINKING FOUNTAIN	EA EACH	ELEV ELEVATION	EXP EXPANSION	EXT EXTERIOR	FIN FINISH	FLR FLOOR	FTG FOOTING	FNDR FOUNDATION	GALV GALVANIZED	GYP GYPSUM	HC HOLLOW CORE	HM HOLLOW METAL	HORZ HORIZONTAL	HB HOSE BIBB	INSUL INSULATION	MFG MANUFACTURER	MAX MAXIMUM	MIN MINIMUM	MTL METAL	NTS NOT TO SCALE	O.C. ON CENTER	OPG OPENING	O/ OVER	PT PAINT	PL PLATE	PLY PLYWOOD	REC RECESSED	REINF REINFORCED	RA RETURN AIR	REQ REQUIRED	RO ROUGH OPENING	SHT SHEET	SC SOLID CORE	SPEC SPECIFICATIONS	SUSP SUSPENDED	TEMP TEMPERED	T&G TONGUE AND GROOVE	TYP TYPICAL	VCT VINYL COMPOSITE TILE	VERT VERTICAL	WDW WINDOW	WWF WELDED WIRE FABRIC	W/ WITH	WD WOOD	A.D.A. MUST BE COMPLIANT WITH AMERICANS WITH DISABILITIES ACT
----------------------	---------------	----------	---------------	-------------	---------	-----------	---------------	-------------	-----------	------------	---------------	--------------------	-----------------	--------------	---------	--------------	----------------------	---------	----------------	---------------	--------------	------------	-----------	-------------	-----------------	-----------------	------------	----------------	-----------------	-----------------	--------------	------------------	------------------	-------------	-------------	-----------	------------------	----------------	-------------	---------	----------	----------	-------------	--------------	------------------	---------------	--------------	------------------	-----------	---------------	---------------------	----------------	---------------	-----------------------	-------------	--------------------------	---------------	------------	------------------------	---------	---------	---

- FLOOR PLAN KEY NOTES:**
- REMOVE EXISTING WINDOW, SEALANTS AND FLASHINGS AS REQUIRED FOR NEW WORK INSTALLATION.
 - INSTALL NEW THERMALLY BROKEN ALUMINUM WINDOW WITH 1" INSULATED, LOW E GLASS. INSTALL FULL HEIGHT ROLLER BLIND WITH VALANCE ON THE INTERIOR.
 - PAINT ROOM, ONE WALL SHALL BE PAINTED AN ACCENT COLOR. COLORS AS SELECTED BY ARCHITECT.
 - PAINT ROOM ALL ONE COLOR. COLOR AS SELECTED BY OWNER.
 - CLEAN EXISTING CEILING AND ROOF STRUCTURE, PAINT CEILING AND ROOF STRUCTURE ELEMENTS USING EPOXY PAINT. COLOR AS SELECTED BY ARCHITECT.
 - PAINT ALL WALLS COLOR #1 FROM SOUTH END FLOOR TO A LINE AT 7' A.F.F. AND COLOR #2 FROM SAME LINE AT 7' A.F.F. TO ACoustICAL CEILING CLOUDS. PAINT ALL WALLS, CEILINGS AND STRUCTURE ABOVE ACoustICAL CEILING CLOUDS BLACK. WALL COLORS AS SELECTED BY ARCHITECT.
 - REPLACE EXISTING FLOORING WITH 12x12 VINYL COMPOSITE TILE. COLOR AS SELECTED BY ARCHITECT.
 - REPLACE EXISTING FLOORING WITH CARPET TILE. COLOR AS SELECTED BY ARCHITECT.

SE Floor Plan

SCALE: 1/8" = 1'-0"

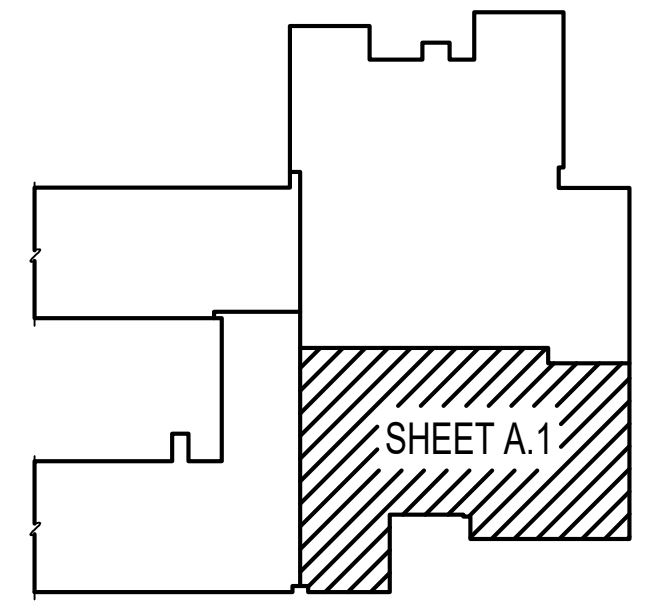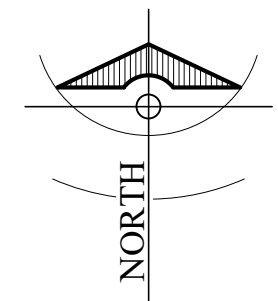


Floor Plan Key

REVISION DATES	
1	Address
2	1.3.2020
3	4
4	5
5	6
6	DATE OF ISSUE
2.20.2026	

Allamakee CSD Middle School HVAC Upgrade
 1001 7rd Avenue, NW, Waukon, Iowa 52172

Design Dynamics, Inc.
 2715 Center Point Road, NE
 Cedar Rapids, Iowa 52402
 Tel: 319-298-0400
 E-mail: DDI@DesignDynamics.biz

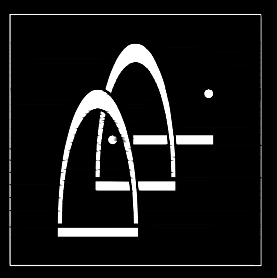

© 2026 Design Dynamics, Inc.



SHEET TITLE

SE FLOOR PLAN

A.1

PROJECT NUMBER

042-25

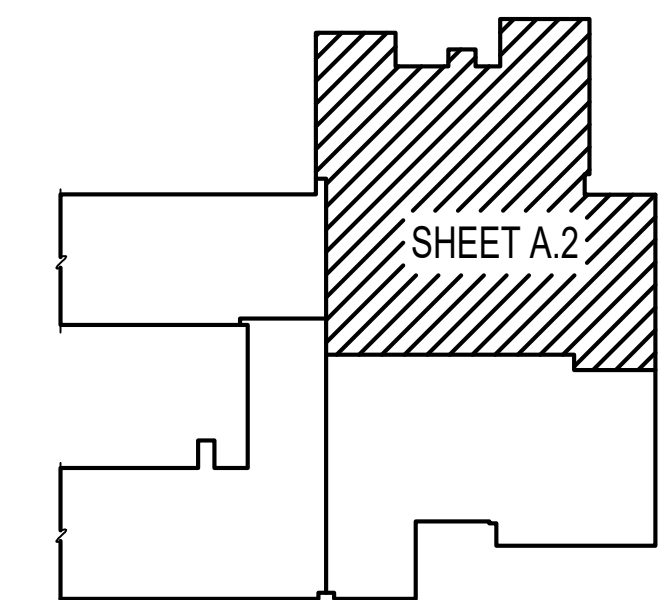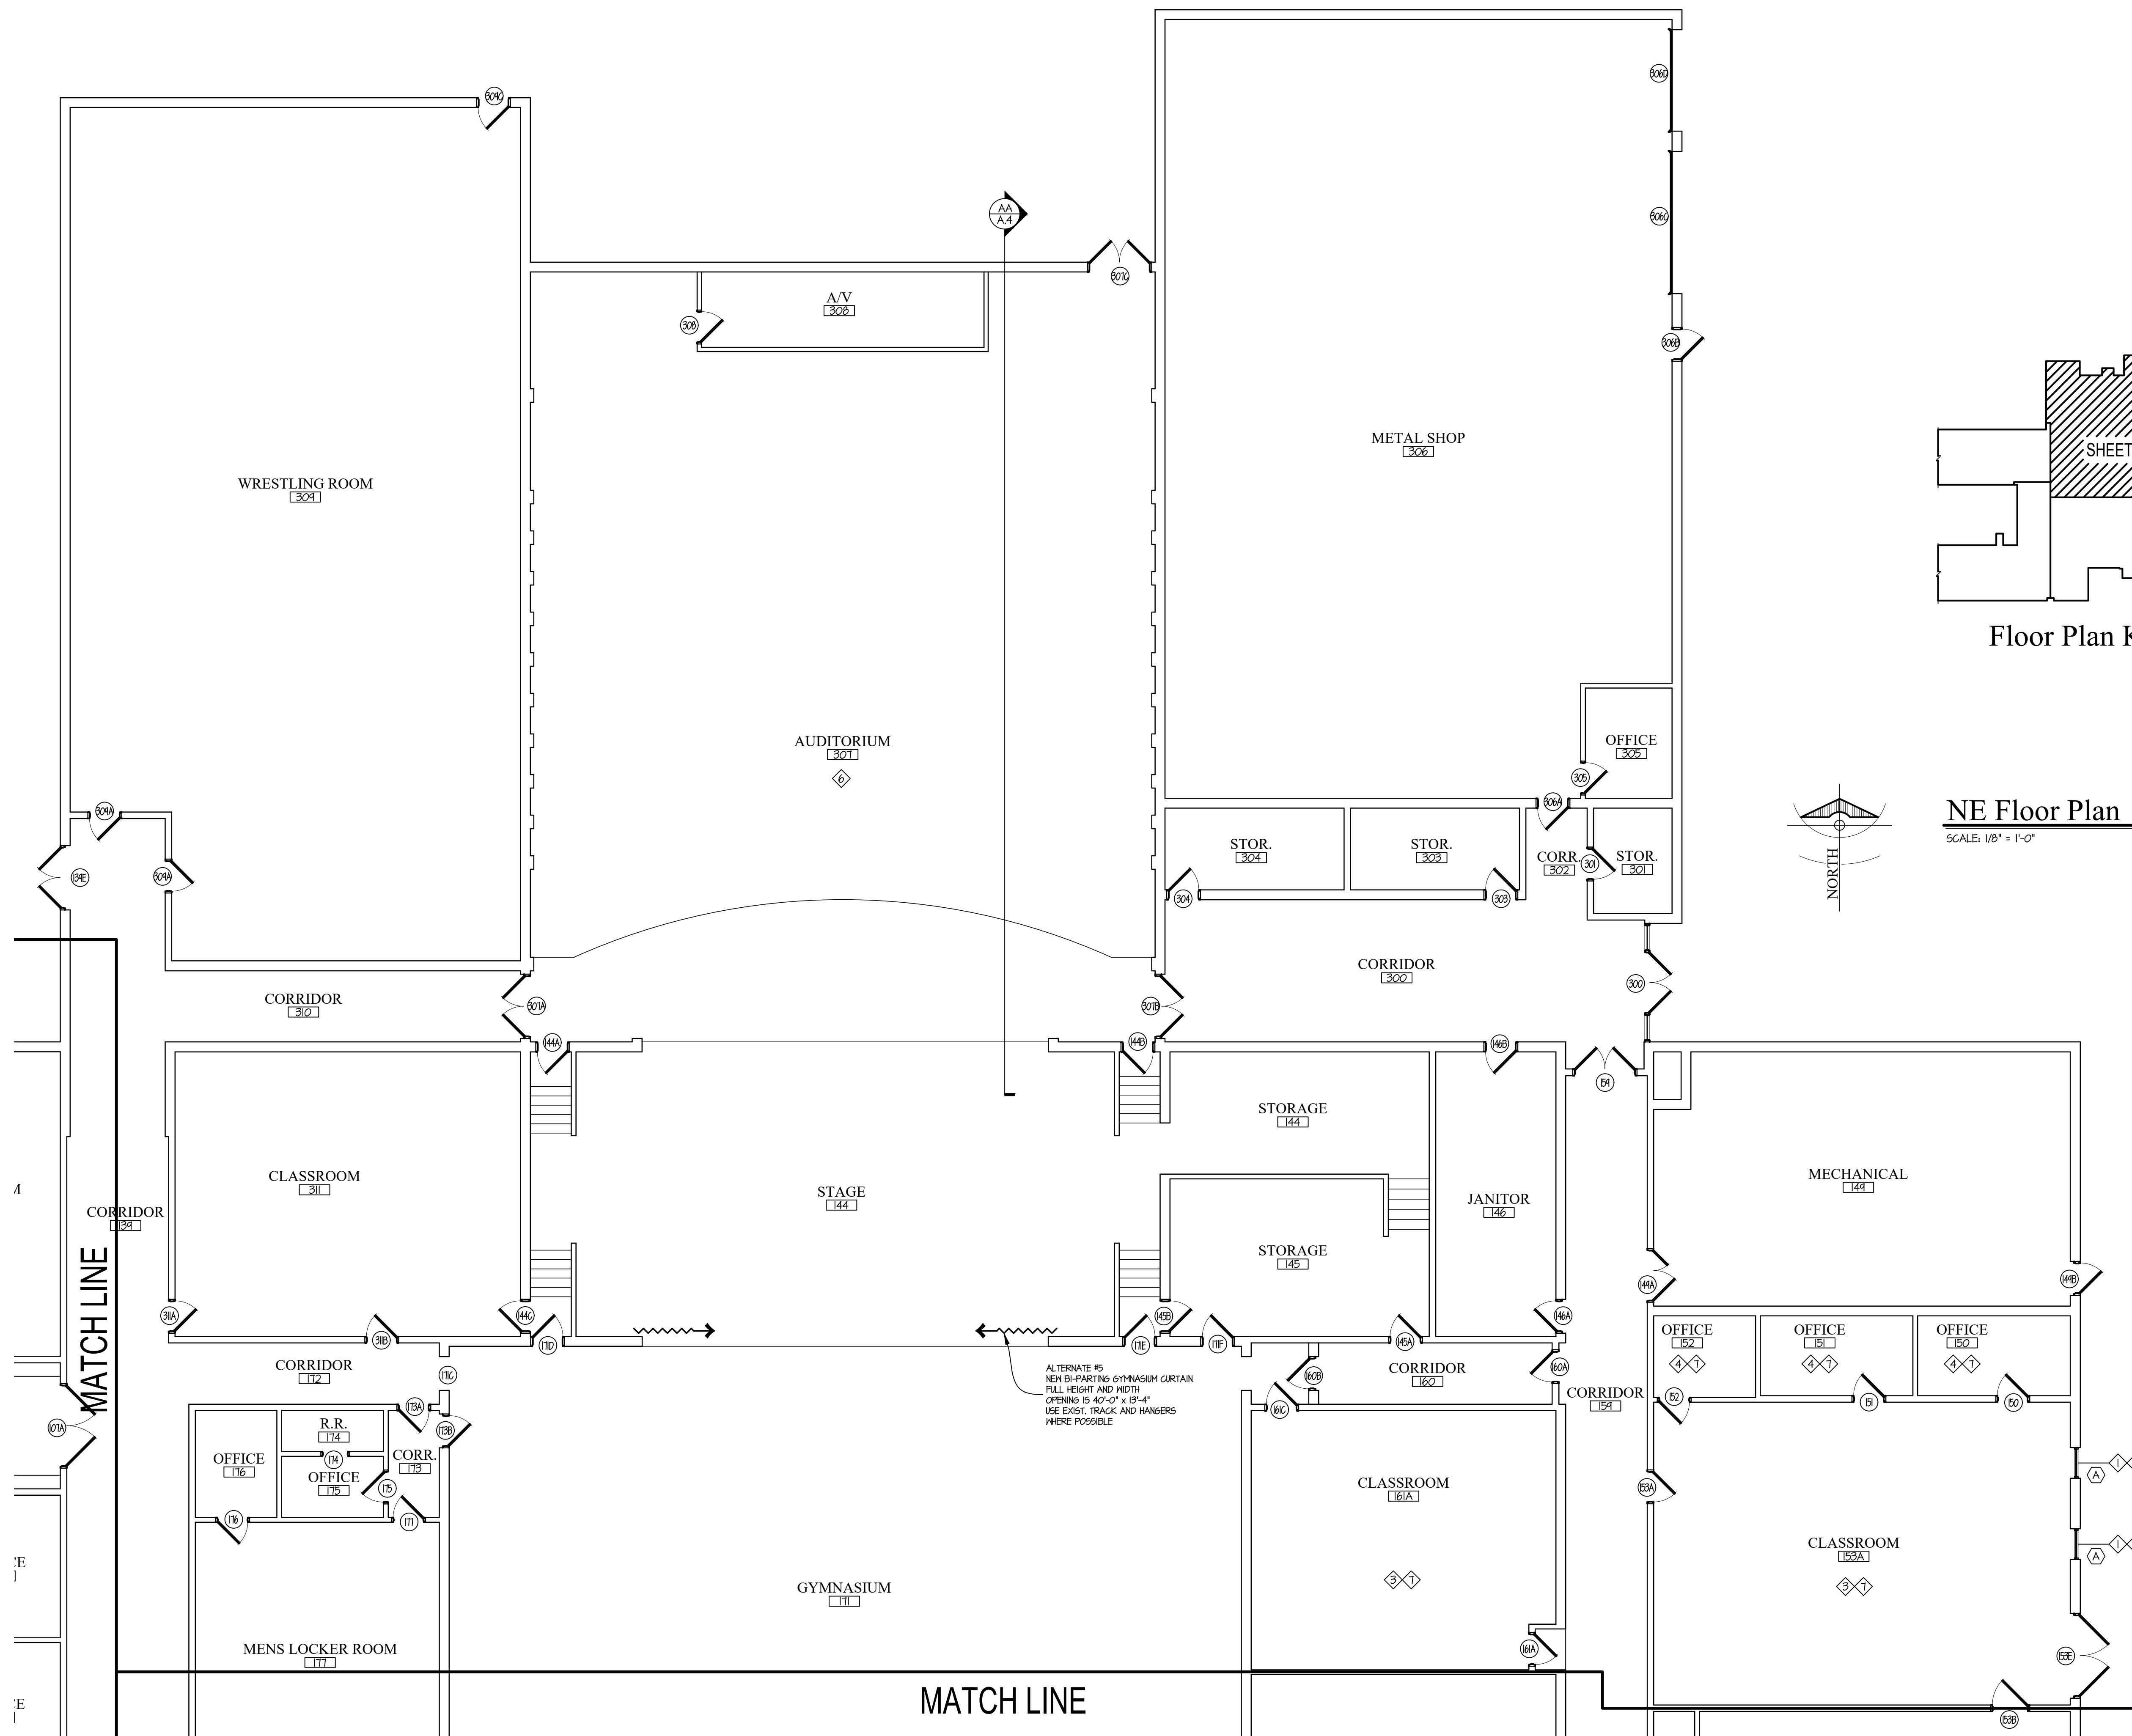

Floor Plan Key

NE Floor Plan

SCALE: 1/8" = 1'-0"


- FLOOR PLAN KEY NOTES:**
1. REMOVE EXISTING WINDOW, SEALANTS AND FLASHINGS AS REQUIRED FOR NEW WORK INSTALLATION.
 2. INSTALL NEW THERMALLY BROKEN ALUMINUM WINDOW WITH 1" INSULATED, LOW E GLASS. INSTALL FULL HEIGHT ROLLER BLIND WITH VALANCE ON THE INTERIOR.
 3. PAINT ROOM ONE WALL SHALL BE PAINTED AN ACCENT COLOR. COLORS AS SELECTED BY ARCHITECT.
 4. PAINT ROOM ALL ONE COLOR. COLOR AS SELECTED BY OWNER.
 5. CLEAN EXISTING CEILING AND ROOF STRUCTURE. PAINT CEILING AND ROOF STRUCTURE ELEMENTS USING EPOXY PAINT. COLOR AS SELECTED BY ARCHITECT.
 6. PAINT ALL WALLS COLOR #1 FROM SOUTH END FLOOR TO A LINE AT 7' A.F.F. AND COLOR #2 FROM SAME LINE AT 7' A.F.F. TO ACoustICAL CEILING CLOUDS. PAINT ALL WALLS, CEILINGS AND STRUCTURE ABOVE ACoustICAL CEILING CLOUDS BLACK. WALL COLORS AS SELECTED BY ARCHITECT.
 7. REPLACE EXISTING FLOORING WITH 12x12 VINYL COMPOSITE TILE. COLOR AS SELECTED BY ARCHITECT.
 8. REPLACE EXISTING FLOORING WITH CARPET TILE. COLOR AS SELECTED BY ARCHITECT.

REVISION	DATE
1	1.12.2025
2	
3	
4	

DATE OF ISSUE
2.20.2026

ALLAMAKEE CSD Middle School HVAC Upgrade
 1001 7th Avenue, NW, Waukon, Iowa 52172

DESIGN DYNAMICS, INC.
 7745 CENTER POINT ROAD, NE
 CEDAR RAPIDS, IOWA 52402
 TEL: 319-298-0400
 E-MAIL: DDI@DesignDynamics.biz

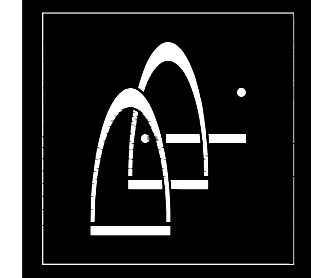


© 2026 Design Dynamics, Inc.

SHEET TITLE


NE FLOOR PLAN

A.2

PROJECT NUMBER
042-25

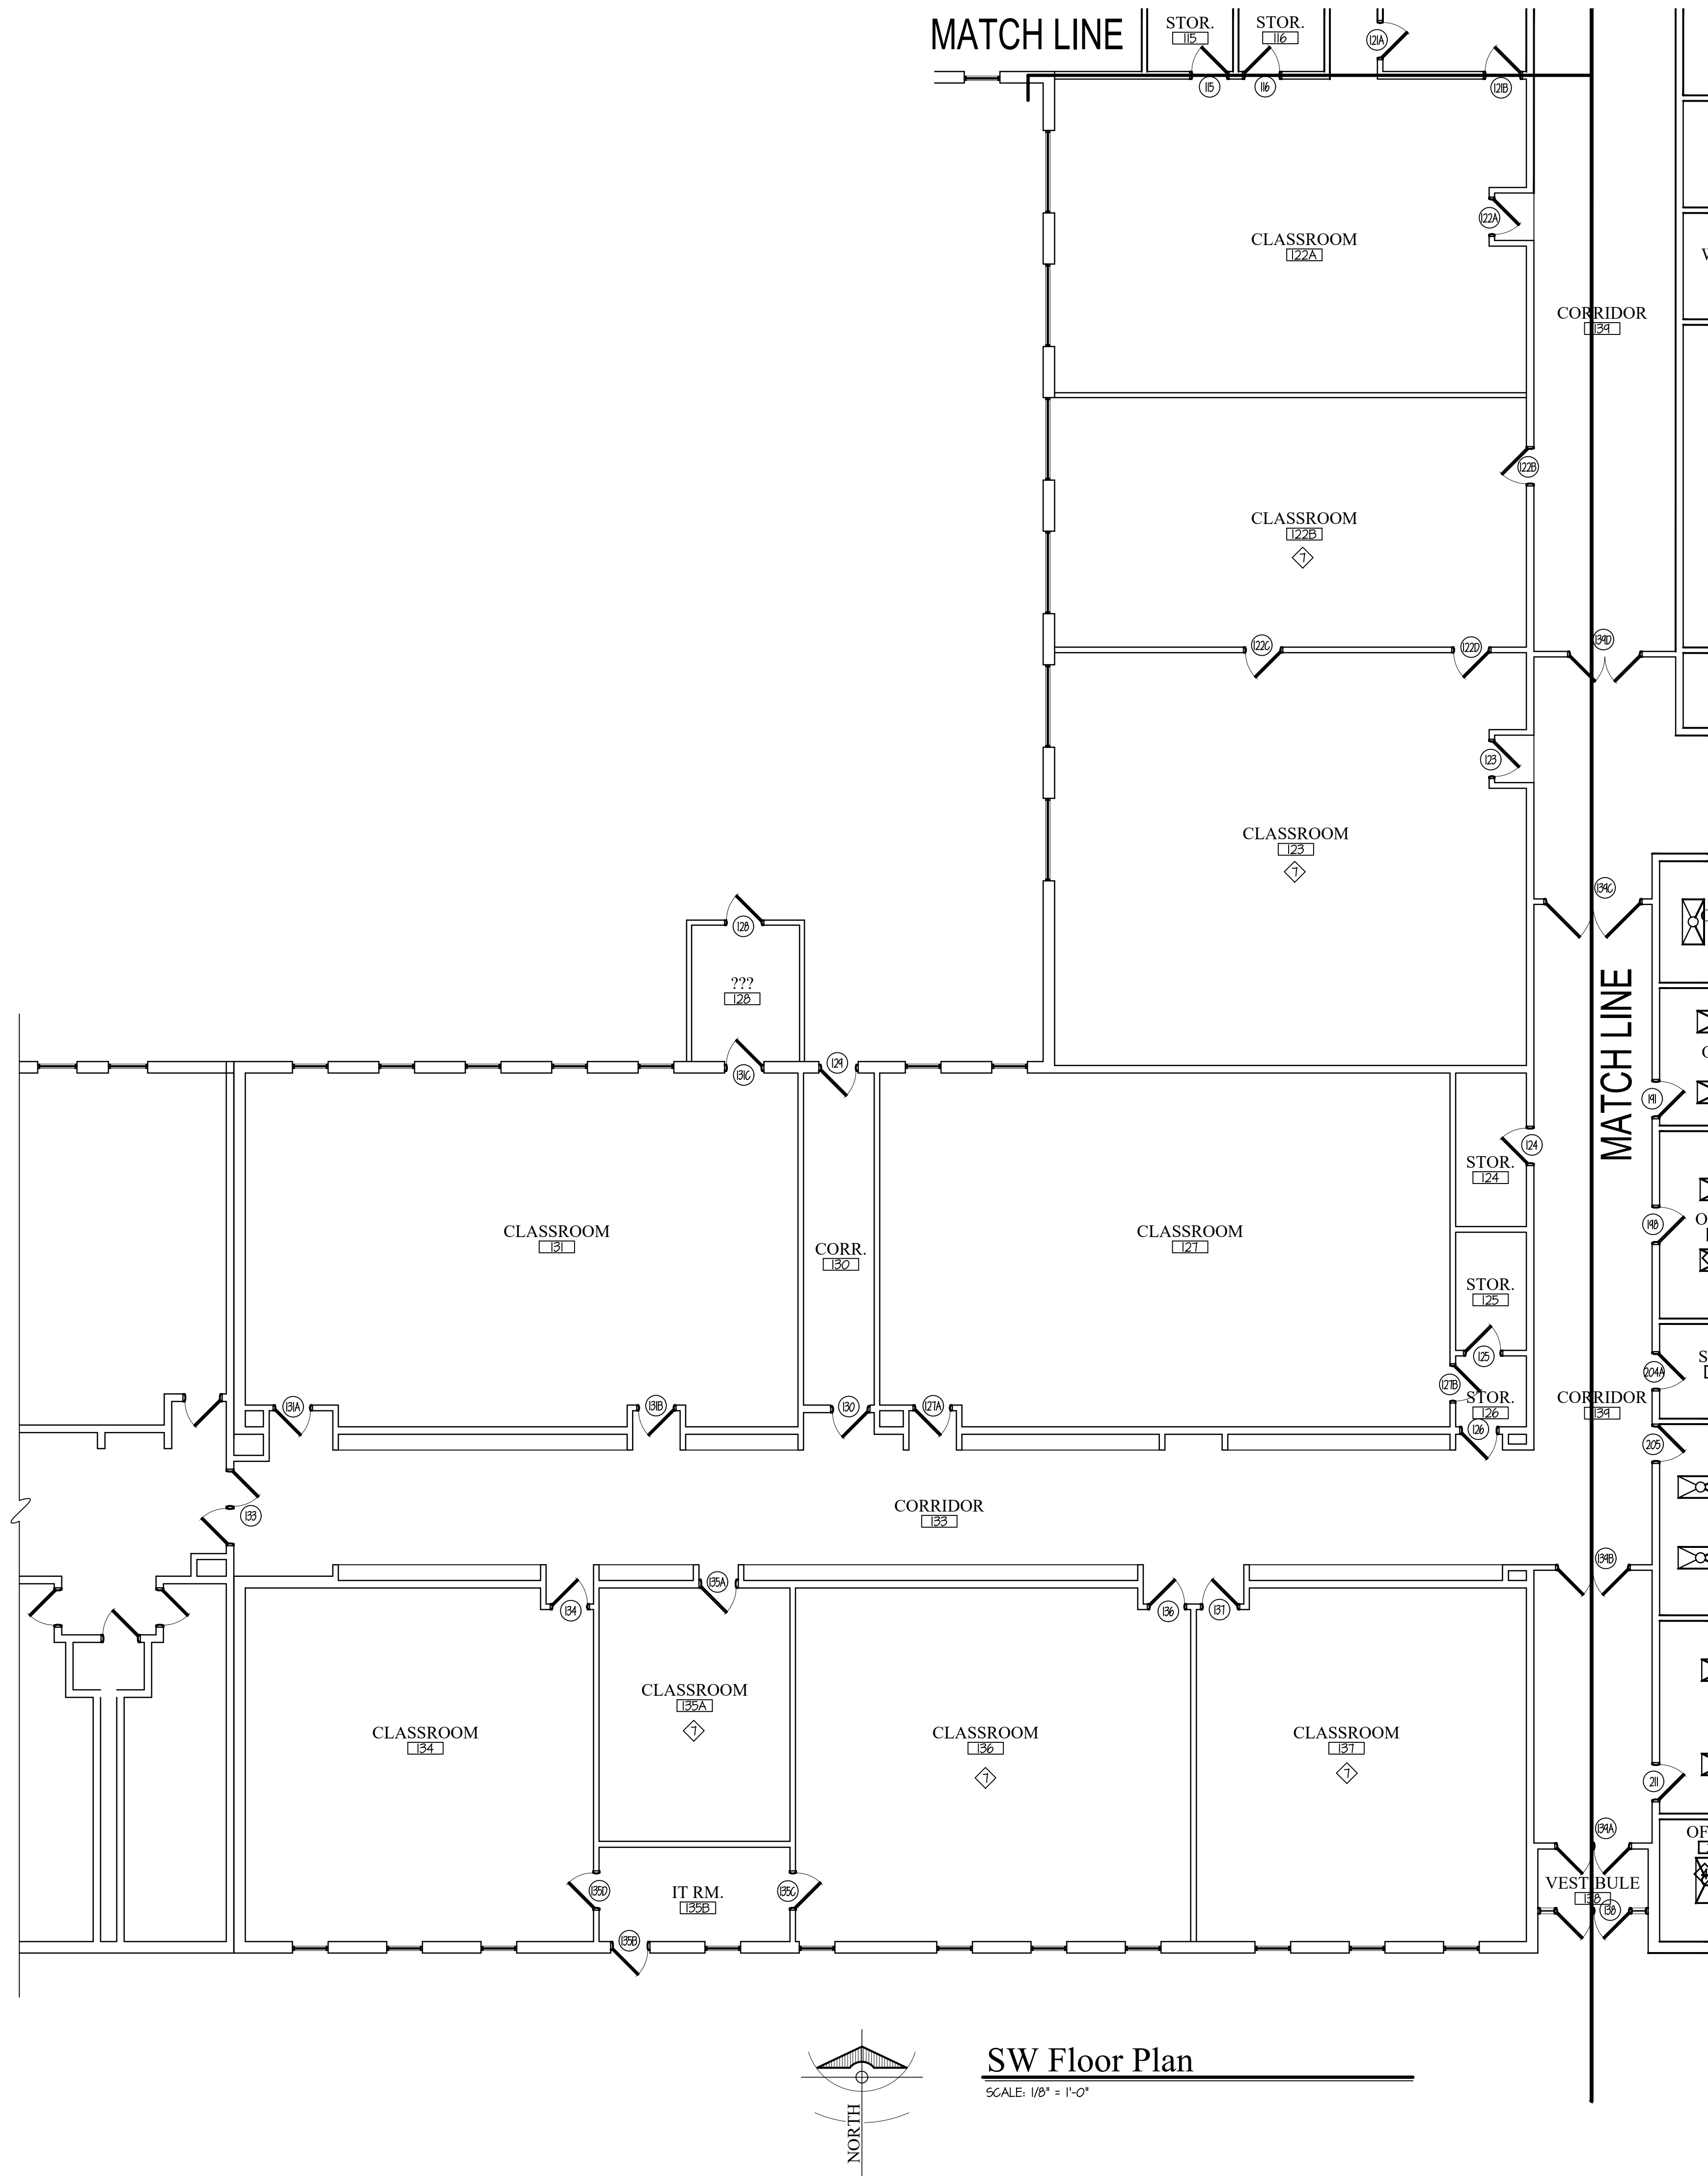

SW Floor Plan
SCALE: 1/8" = 1'-0"

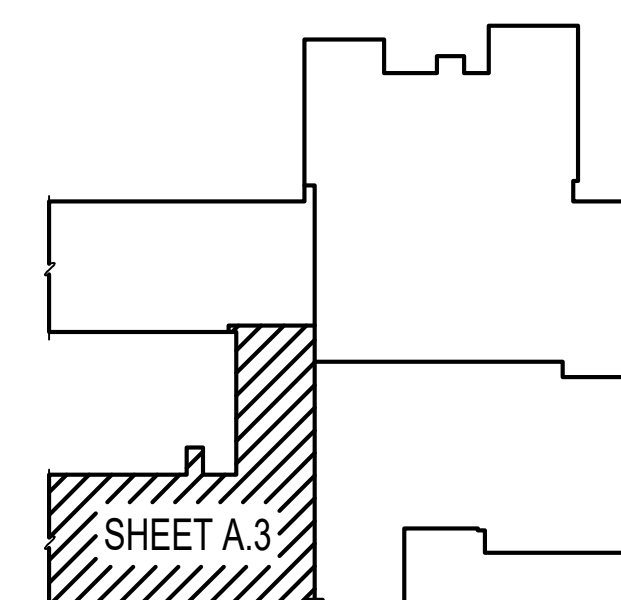

Floor Plan Key


- FLOOR PLAN KEY NOTES:**
1. REMOVE EXISTING WINDOW, SEALANTS AND FLASHINGS AS REQUIRED FOR NEW WORK INSTALLATION.
 2. INSTALL NEW THERMALLY BROKEN ALUMINUM WINDOW WITH 1" INSULATED, LOW E GLASS. INSTALL FULL HEIGHT ROLLER BLIND WITH VALANCE ON THE INTERIOR.
 3. PAINT ROOM ONE WALL SHALL BE PAINTED AN ACCENT COLOR. COLORS AS SELECTED BY ARCHITECT.
 4. PAINT ROOM ALL ONE COLOR. COLOR AS SELECTED BY OWNER.
 5. CLEAN EXISTING CEILING AND ROOF STRUCTURE. PAINT CEILING AND ROOF STRUCTURE ELEMENTS USING EPOXY PAINT. COLOR AS SELECTED BY ARCHITECT.
 6. PAINT ALL WALLS COLOR #1 FROM SOUTH END FLOOR TO A LINE AT 7' A.F.F. AND COLOR #2 FROM SAIR LINE AT 7' A.F.F. TO ACOUSTICAL CEILING CLOUDS. PAINT ALL WALLS, CEILINGS AND STRUCTURE ABOVE ACOUSTICAL CEILING CLOUDS BLACK. WALL COLORS AS SELECTED BY ARCHITECT.
 7. REPLACE EXISTING FLOORING WITH 12x12 VINYL COMPOSITE TILE. COLOR AS SELECTED BY ARCHITECT.
 8. REPLACE EXISTING FLOORING WITH CARPET TILE. COLOR AS SELECTED BY ARCHITECT.

REVISION	DATE
1	2.20.2026
2	
3	
4	
5	
6	

DATE OF ISSUE
2.20.2026

Allamakee CSD Middle School HVAC Upgrade
1061 3rd Avenue, NW, Waukeon, Iowa 52172

Design Dynamics, Inc.
747 CENTER POINT ROAD, NE
CEDAR RAPIDS, IOWA 52402
TEL: 319-298-0400
E-MAIL: DDI@DesignDynamics.biz

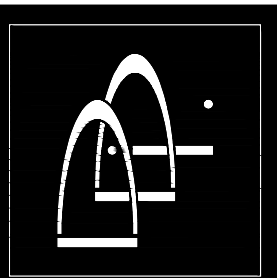


© 2026 Design Dynamics, Inc.

SHEET TITLE
SW FLOOR PLAN

A.3

PROJECT NUMBER
042-25

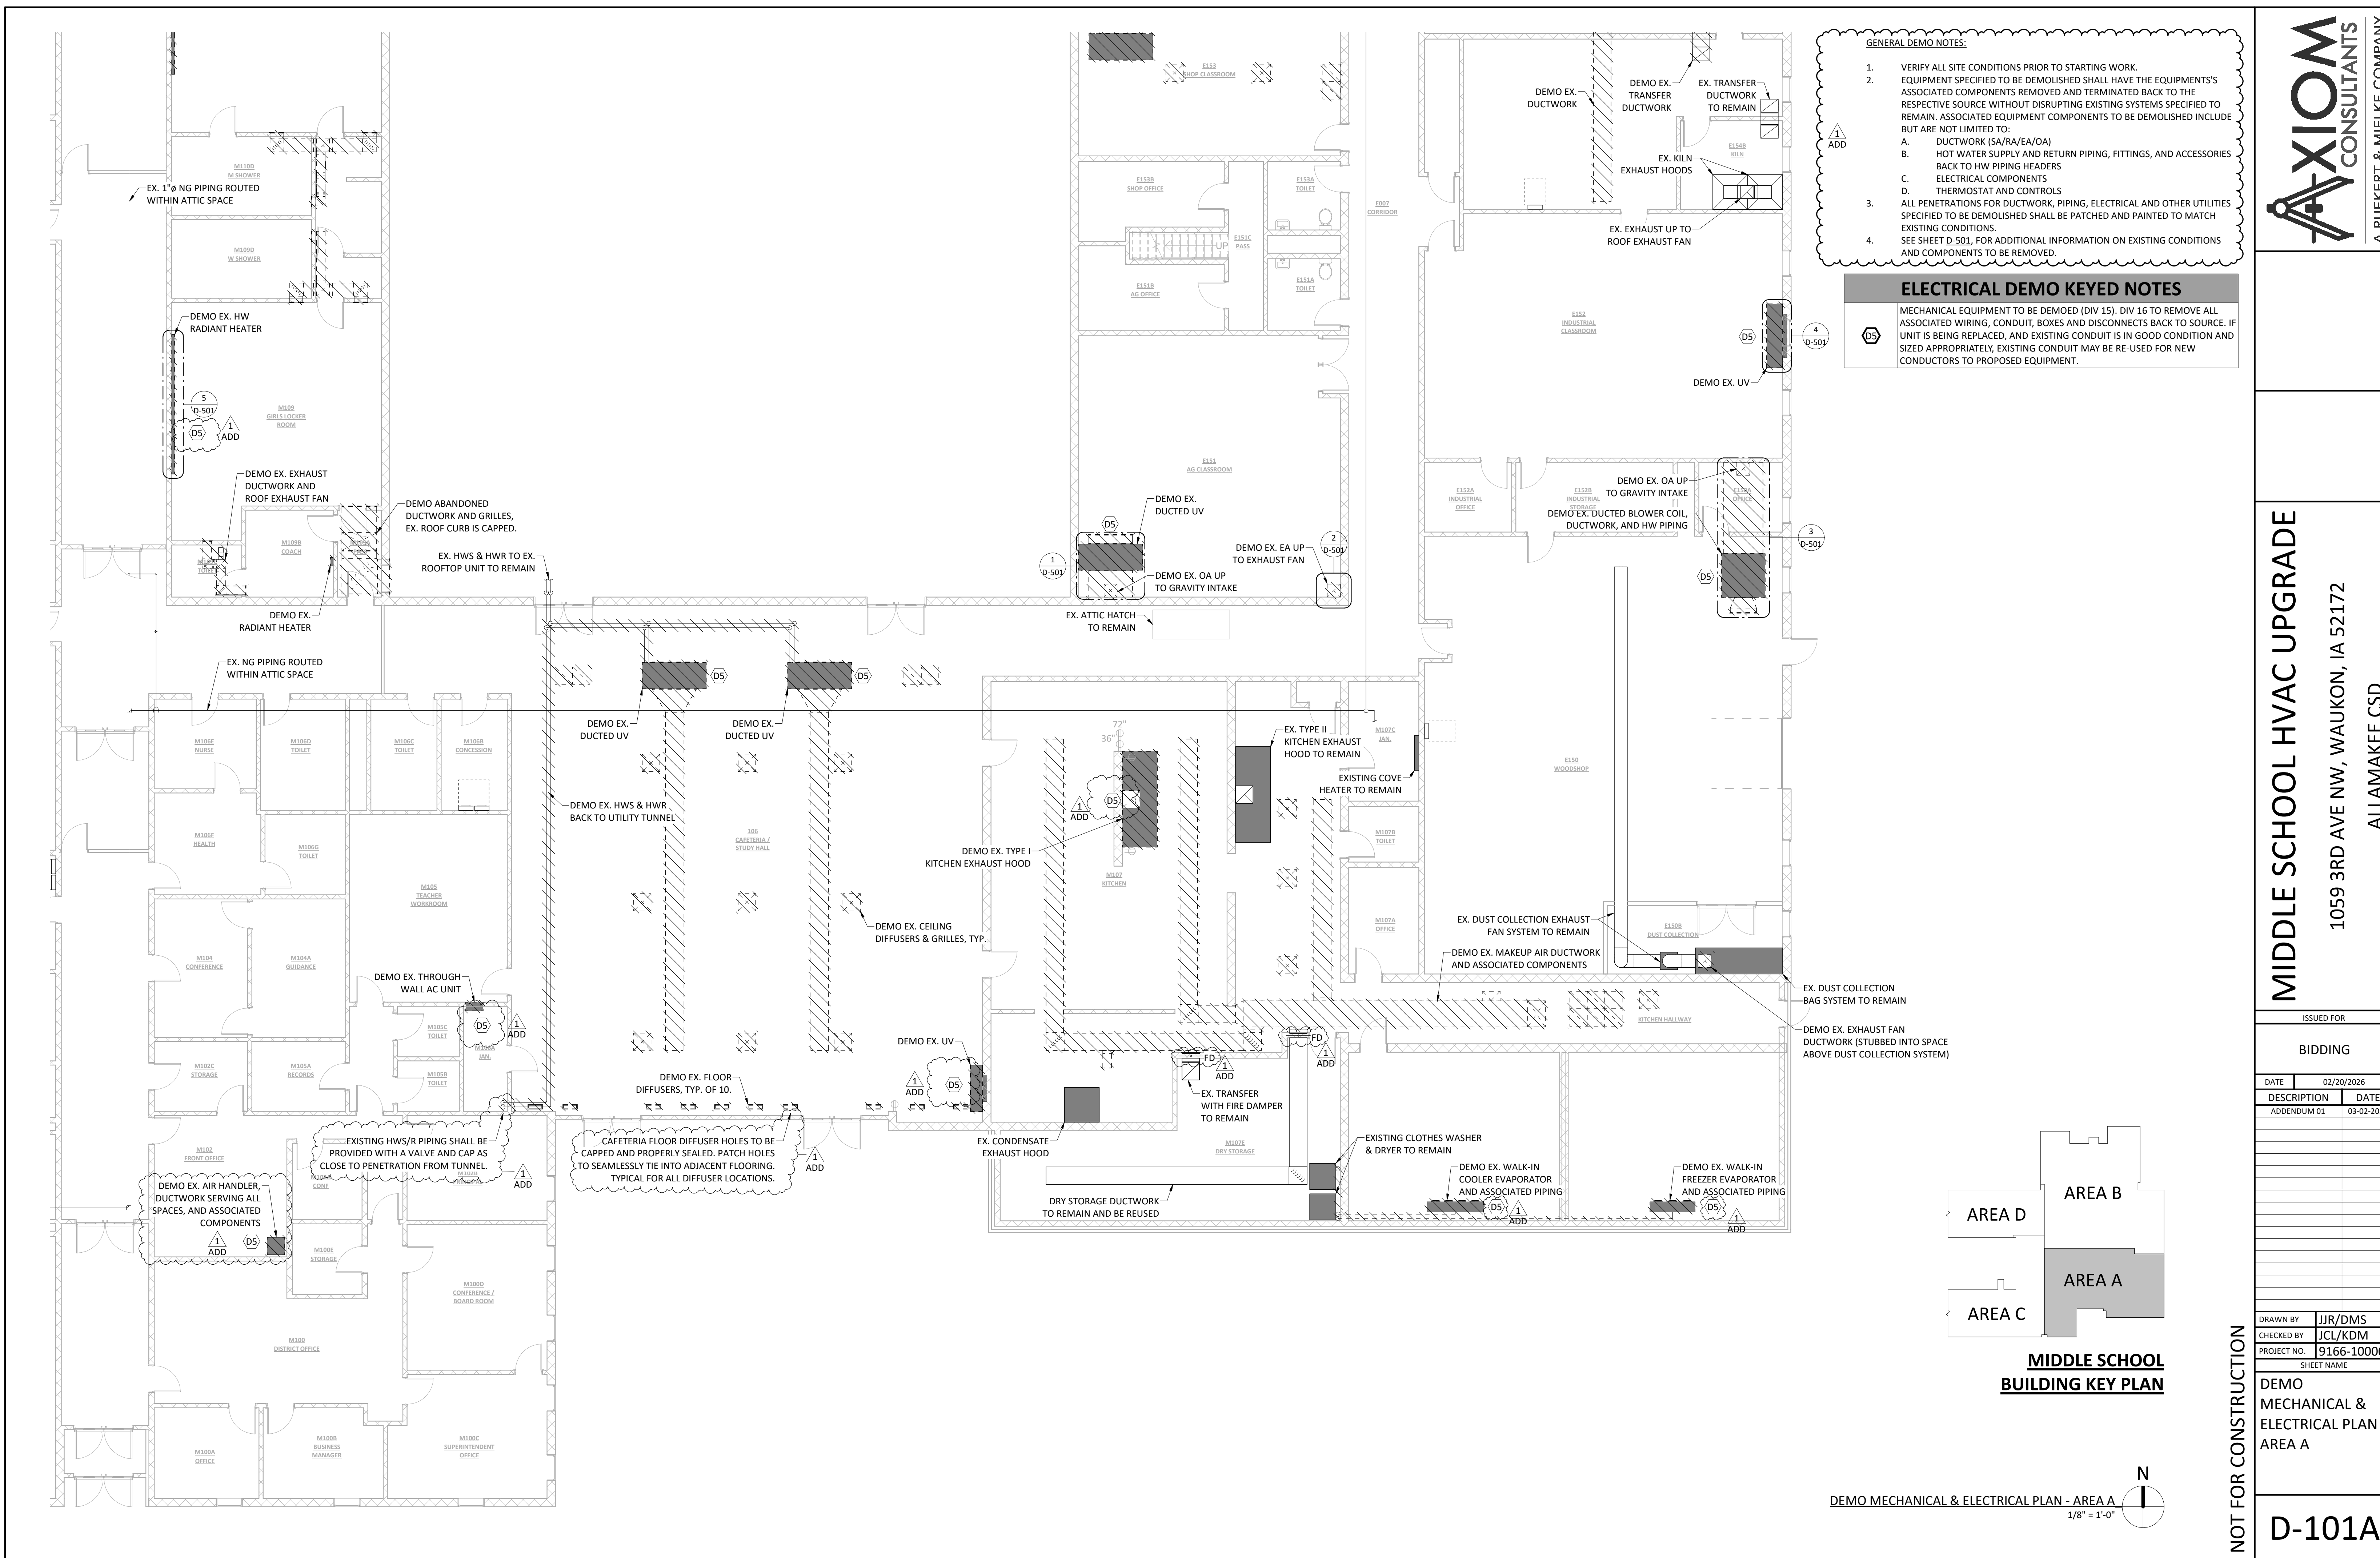

- GENERAL DEMO NOTES:**
1. VERIFY ALL SITE CONDITIONS PRIOR TO STARTING WORK.
 2. EQUIPMENT SPECIFIED TO BE DEMOLISHED SHALL HAVE THE EQUIPMENTS ASSOCIATED COMPONENTS REMOVED AND TERMINATED BACK TO THE RESPECTIVE SOURCE WITHOUT DISRUPTING EXISTING SYSTEMS SPECIFIED TO REMAIN. ASSOCIATED EQUIPMENT COMPONENTS TO BE DEMOLISHED INCLUDE BUT ARE NOT LIMITED TO:
 - A. DUCTWORK (SA/RA/EA/OA)
 - B. HOT WATER SUPPLY AND RETURN PIPING, FITTINGS, AND ACCESSORIES BACK TO HW PIPING HEADERS
 - C. ELECTRICAL COMPONENTS
 - D. THERMOSTAT AND CONTROLS
 3. ALL PENETRATIONS FOR DUCTWORK, PIPING, ELECTRICAL AND OTHER UTILITIES SPECIFIED TO BE DEMOLISHED SHALL BE PATCHED AND PAINTED TO MATCH EXISTING CONDITIONS.
 4. SEE SHEET D-501 FOR ADDITIONAL INFORMATION ON EXISTING CONDITIONS AND COMPONENTS TO BE REMOVED.

- ELECTRICAL DEMO KEYED NOTES**
- MECHANICAL EQUIPMENT TO BE DEMOED (DIV 15). DIV 16 TO REMOVE ALL ASSOCIATED WIRING, CONDUIT, BOXES AND DISCONNECTS BACK TO SOURCE. IF UNIT IS BEING REPLACED, AND EXISTING CONDUIT IS IN GOOD CONDITION AND SIZED APPROPRIATELY, EXISTING CONDUIT MAY BE RE-USED FOR NEW CONDUCTORS TO PROPOSED EQUIPMENT.

ISSUED FOR

BIDDING	
DATE	DESCRIPTION
02/20/2026	
03-02-2026	ADDENDUM 01

DRAWN BY: JJR/DMS
CHECKED BY: JCL/KDM
PROJECT NO.: 9166-10000
SHEET NAME

DEMO MECHANICAL & ELECTRICAL PLAN - AREA A

D-101A

NOT FOR CONSTRUCTION

MIDDLE SCHOOL BUILDING KEY PLAN
1/8" = 1'-0"

GENERAL DEMO NOTES:



- VERIFY ALL SITE CONDITIONS PRIOR TO STARTING WORK.
- EQUIPMENT SPECIFIED TO BE DEMOLISHED SHALL HAVE THE EQUIPMENTS'S ASSOCIATED COMPONENTS REMOVED AND TERMINATED BACK TO THE RESPECTIVE SOURCE WITHOUT DISRUPTING EXISTING SYSTEMS SPECIFIED TO REMAIN. ASSOCIATED EQUIPMENT COMPONENTS TO BE DEMOLISHED INCLUDE BUT ARE NOT LIMITED TO:
 - DUCTWORK (SA/RA/EA/OA)
 - HOT WATER SUPPLY AND RETURN PIPING, FITTINGS, AND ACCESSORIES BACK TO HW PIPING HEADERS
 - ELECTRICAL COMPONENTS
 - THERMOSTAT AND CONTROLS
- ALL PENETRATIONS FOR DUCTWORK, PIPING, ELECTRICAL AND OTHER UTILITIES SPECIFIED TO BE DEMOLISHED SHALL BE PATCHED AND PAINTED TO MATCH EXISTING CONDITIONS.
- SEE SHEET D-501 FOR ADDITIONAL INFORMATION ON EXISTING CONDITIONS AND COMPONENTS TO BE REMOVED.

ELECTRICAL DEMO KEYED NOTES

D4 EXISTING PAD MOUNTED TRANSFORMER IN DETERIORATED CONDITION AND SHALL BE COMPLETELY REMOVED INCLUDING ALL ASSOCIATED WIRING AND GROUNDING COMPONENTS. THE EXISTING CONCRETE PAD IS UNDERSIZED AND DOES NOT MEET CURRENT UTILITY OR CODE REQUIREMENTS. CONTRACTOR SHALL DEMOLISH AND DISPOSE OF THE EXISTING CONCRETE PAD IN ITS ENTIRETY. EC TO MAINTAIN ALL SAFETY MEASURES AND PROVIDE TEMPORARY PROTECTION, BARRICADES AND REQUIRED NOTICES DURING TRANSFORMER REMOVAL AND PAD REPLACEMENT. EC TO COORDINATE WITH OWNER PRIOR TO ANY DEMOLITION OR TERMINATION OF SERVICE TO BUILDING.

D5 MECHANICAL EQUIPMENT TO BE DEMOED (DIV 15). DIV 16 TO REMOVE ALL ASSOCIATED WIRING, CONDUIT, BOXES AND DISCONNECTS BACK TO SOURCE. IF UNIT IS BEING REPLACED, AND EXISTING CONDUIT IS IN GOOD CONDITION AND SIZED APPROPRIATELY, EXISTING CONDUIT MAY BE RE-USED FOR NEW CONDUCTORS TO PROPOSED EQUIPMENT.


D6 DEMO EXISTING PANEL. DE-ENERGIZE ALL FEEDERS AND BRANCH CIRCUITS SERVING THE EXISTING FLUSH-MOUNTED PANEL PRIOR TO WORK. COORDINATE OUTAGES WITH OWNER. IDENTIFY, TAG, AND DOCUMENT ALL EXISTING CIRCUITS PRIOR TO DISCONNECTION FOR RECONNECTION TO NEW SURFACE-MOUNTED PANEL. REMOVE EXISTING PANEL, BREAKERS, TRIM, GROUNDING/BONDING, AND ASSOCIATED CONDUITS. REMOVE ABANDONED CONDUCTORS IN COMPLIANCE WITH NEC. MAINTAIN GROUNDING AND BONDING CONTINUITY AND PROTECT ADJACENT SYSTEMS DURING DEMOLITION. PROVIDE TEMPORARY POWER AS REQUIRED. PATCH AND RESTORE WALL SURFACES TO MATCH EXISTING CONDITIONS.

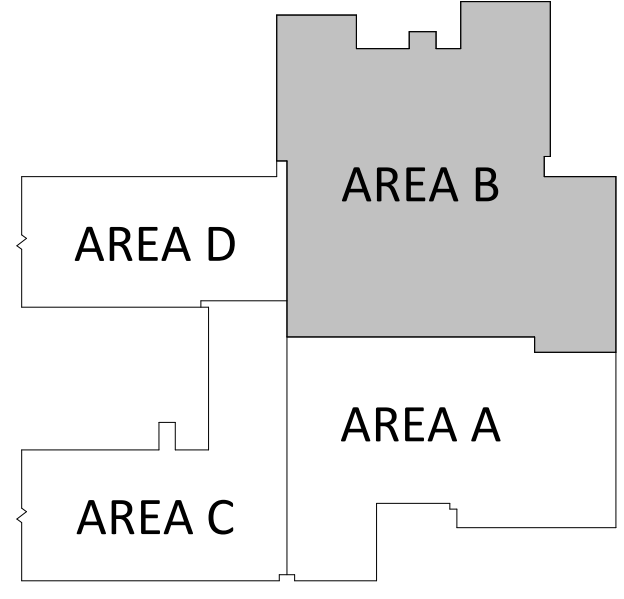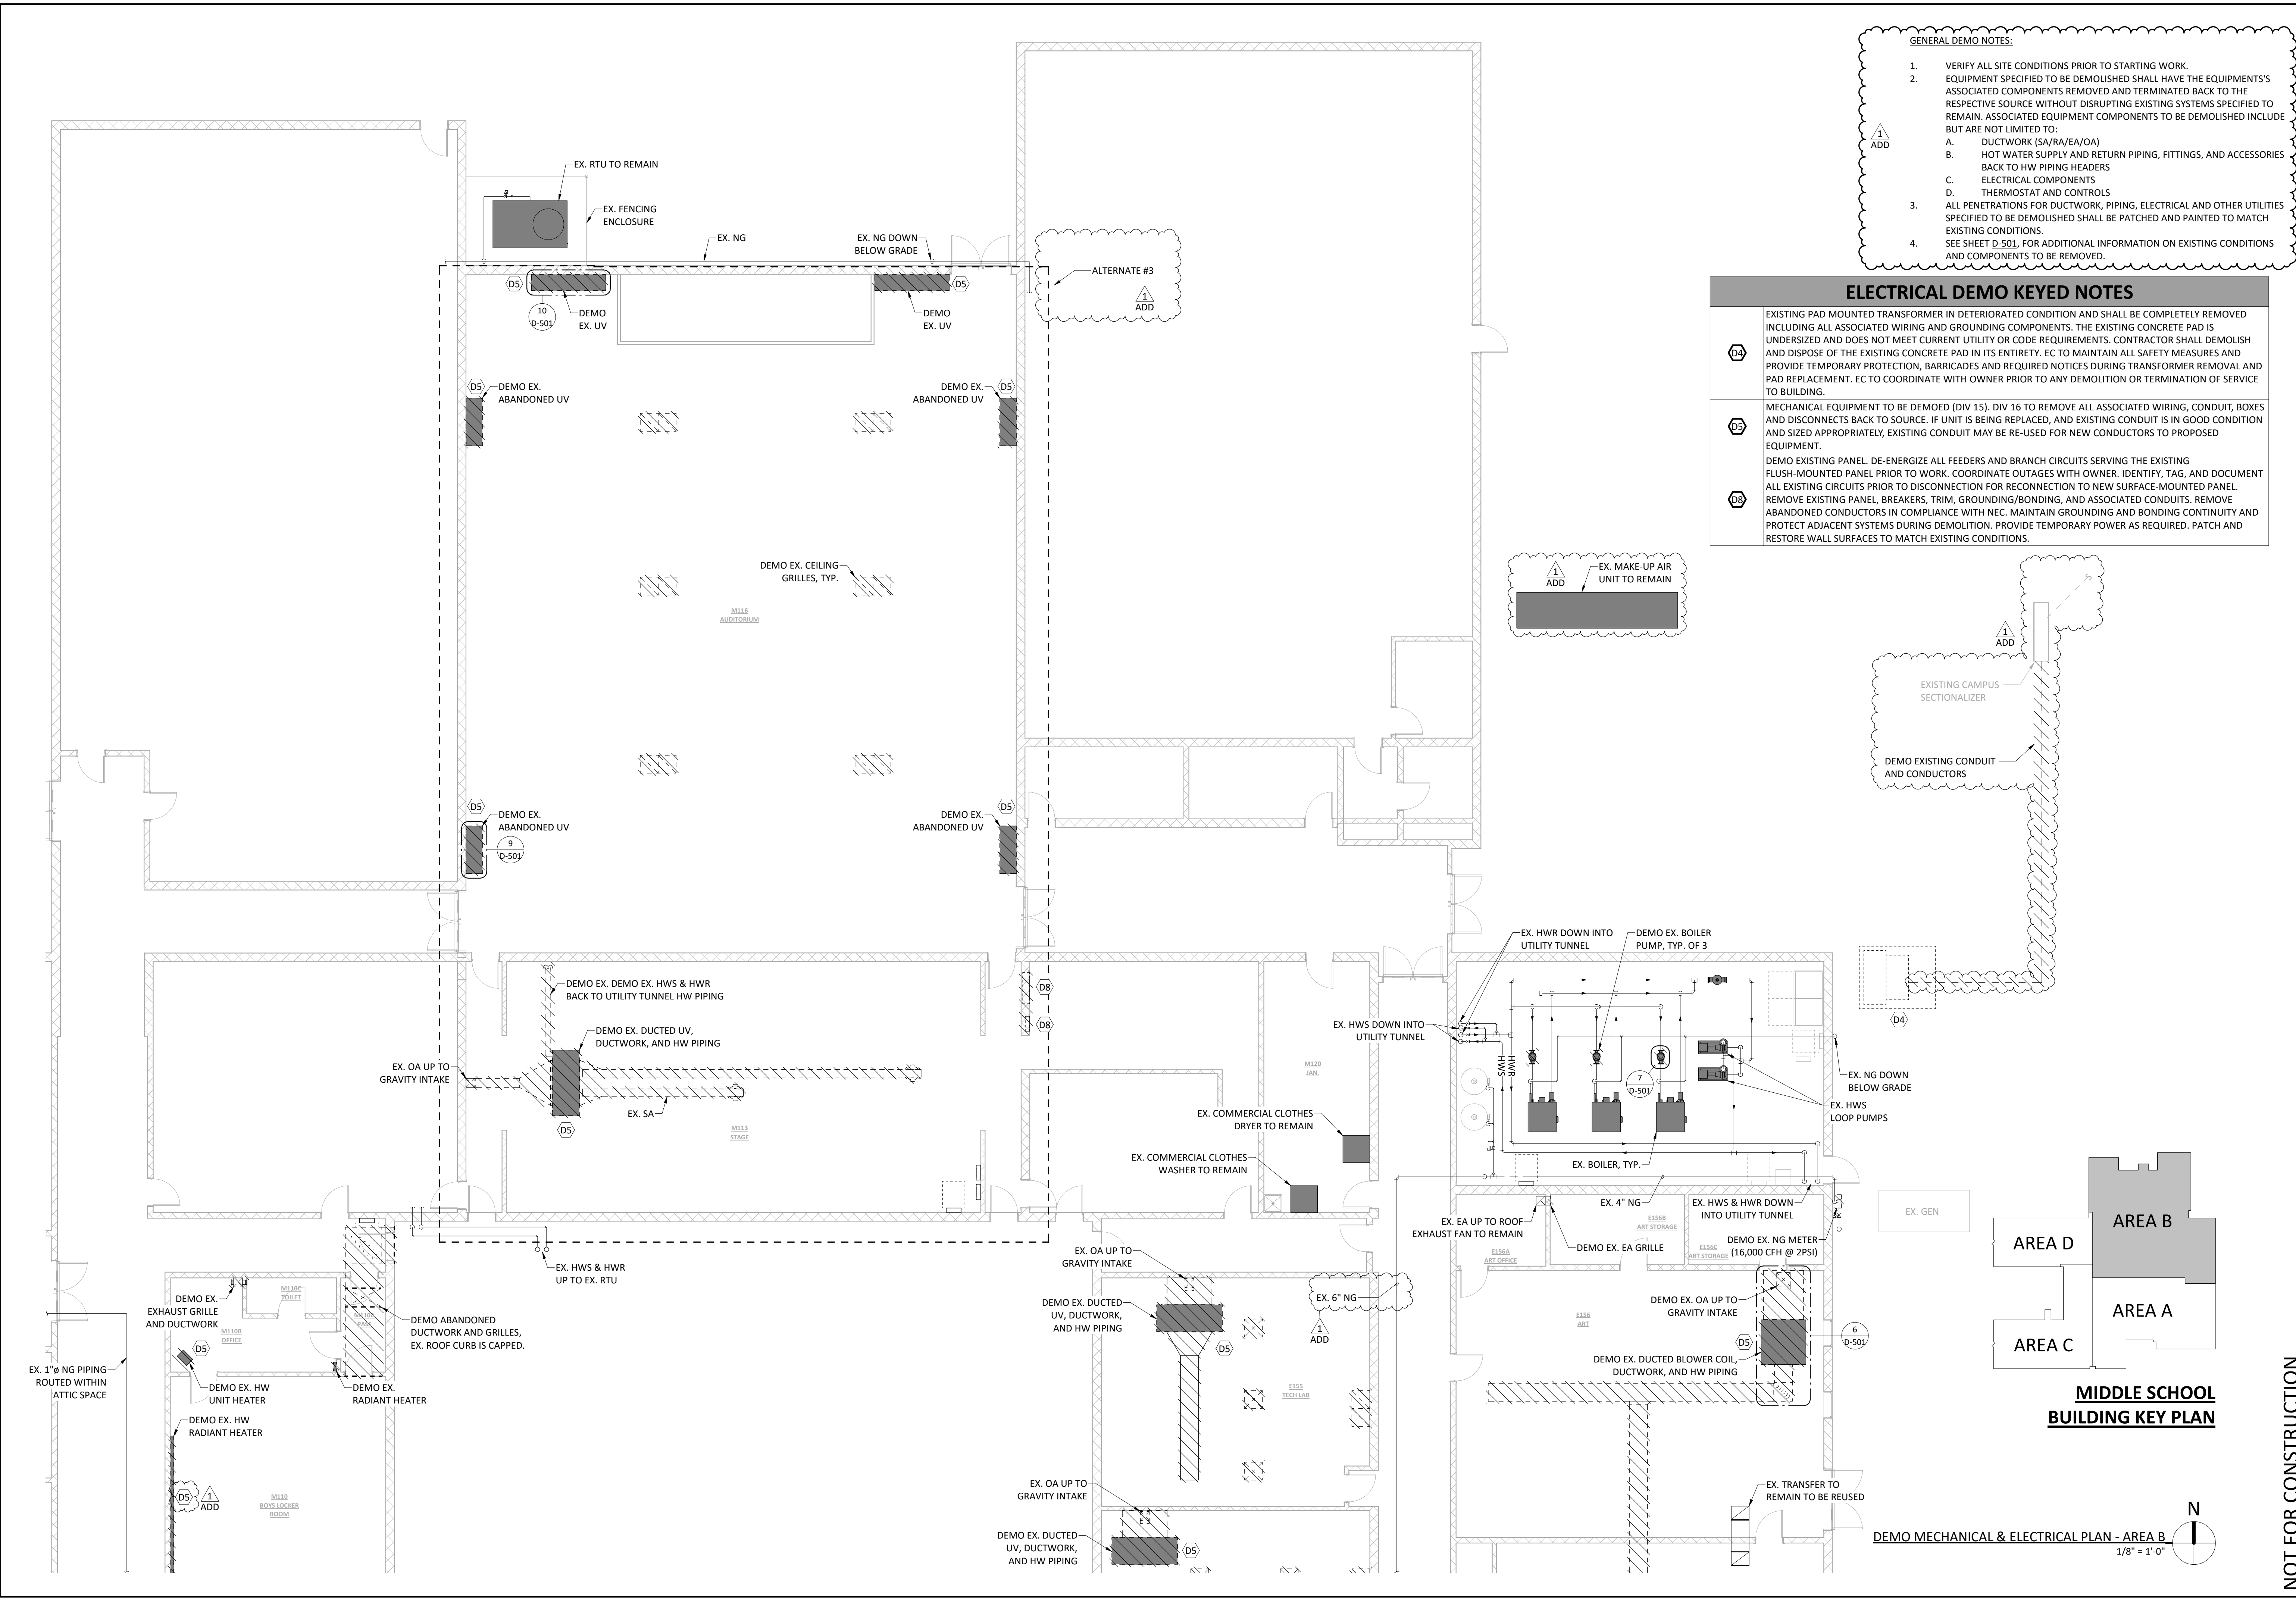

MIDDLE SCHOOL BUILDING KEY PLAN


DEMO MECHANICAL & ELECTRICAL PLAN - AREA B
1/8" = 1'-0"

NOT FOR CONSTRUCTION

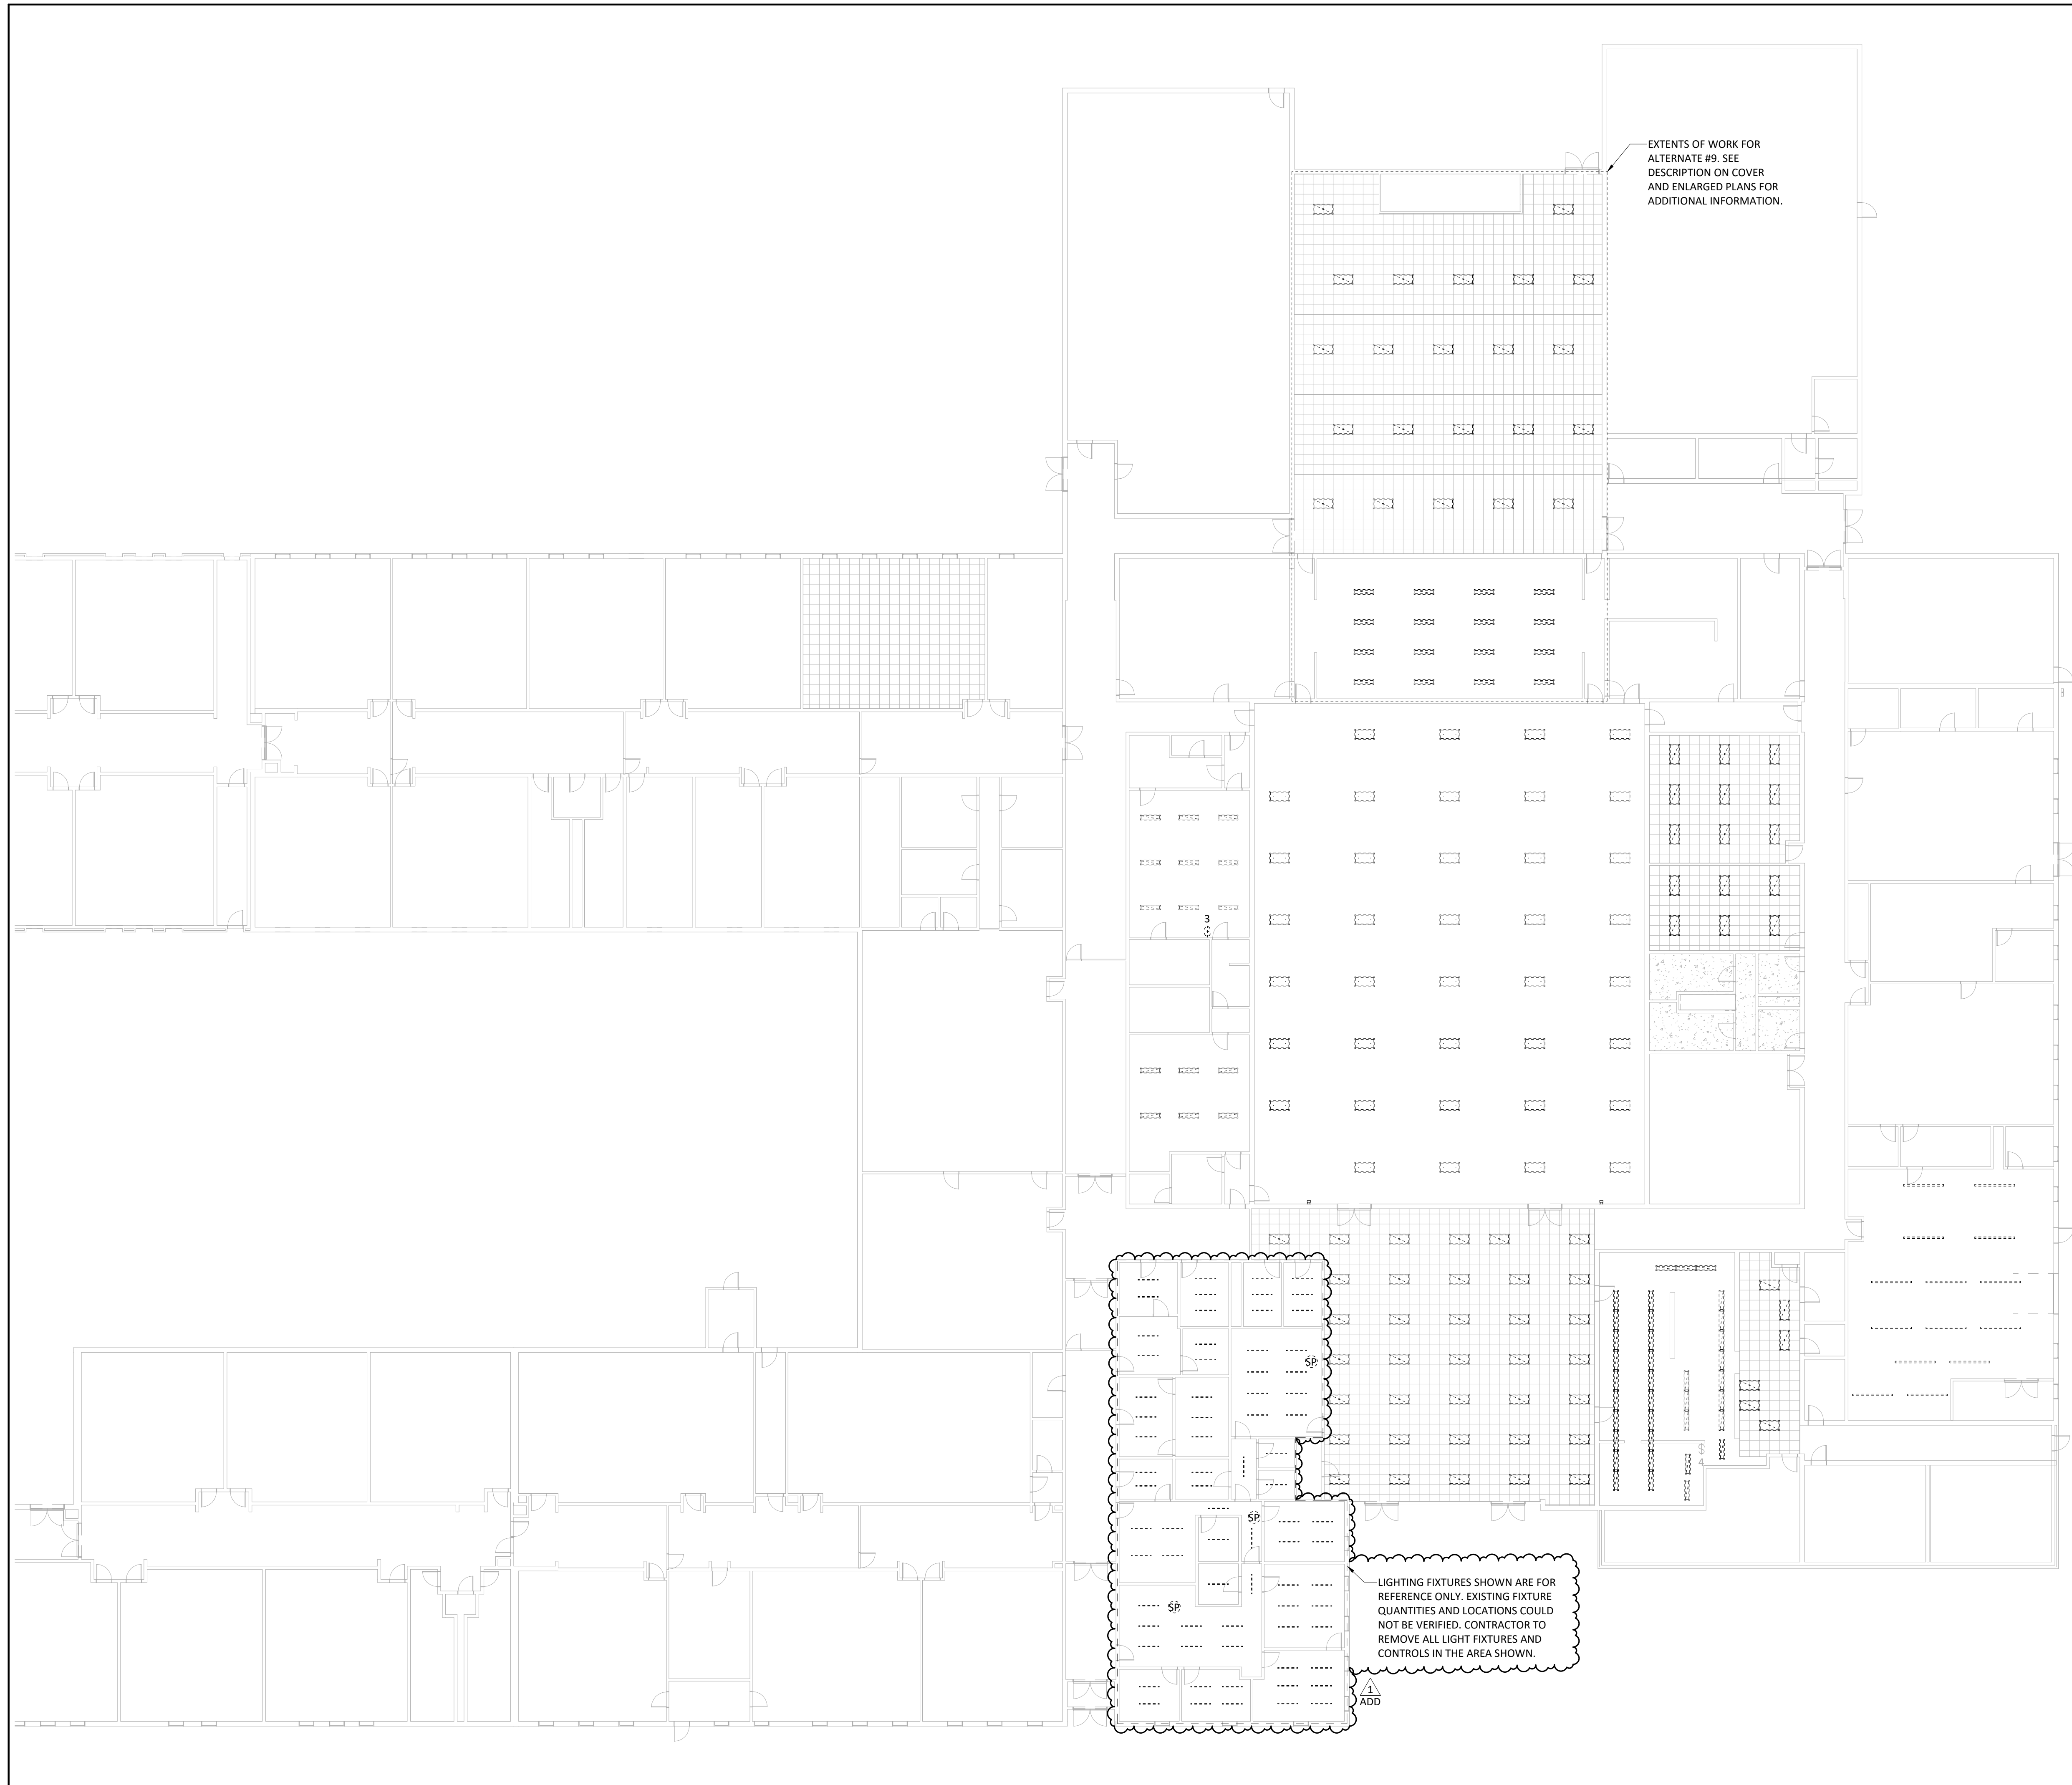


LIGHTING DEMO NOTES

1. REMOVE ALL EXISTING LIGHT FIXTURES IN AREAS INDICATED ON THE DEMOLITION PLANS. FIXTURES SHALL BE REMOVED IN THEIR ENTIRETY UNLESS NOTED TO REMAIN OR BE RELOCATED.
2. DISCONNECT AND REMOVE ASSOCIATED BRANCH CIRCUIT WIRING BACK TO THE NEAREST ACCESSIBLE JUNCTION BOX. CAP AND LABEL REMAINING CONDUCTORS APPROPRIATELY PER CODE.
3. REMOVE ALL EXISTING LIGHTING CONTROL DEVICES, INCLUDING WALL SWITCHES, DIMMERS, OCCUPANCY SENSORS, DAYLIGHT SENSORS, AND RELATED CONTROL WIRING UNLESS SPECIFICALLY NOTED OTHERWISE.
4. COORDINATE ALL FIXTURE AND CONTROL REMOVALS WITH THE NEW LIGHTING LAYOUT TO ENSURE COMPATIBILITY WITH THE NEW SWITCHING AND CONTROL SYSTEM.
5. MAINTAIN SAFE AND ADEQUATE TEMPORARY LIGHTING DURING DEMOLITION AND CONSTRUCTION.
6. RETURN ALL CEILING TO A SAFE CONDITION AFTER DEVICE REMOVAL. PROVIDE BLANK PLATES OR TEMPORARY COVERS AT ANY BOX OPENINGS UNTIL NEW DEVICES ARE INSTALLED.
7. VERIFY ALL CIRCUITS FEEDING REMOVED FIXTURES AND IDENTIFY MULTI-WIRE BRANCH CIRCUITS PRIOR TO DEMOLITION. ENSURE CIRCUITS ARE FULLY DE-ENERGIZED.
8. ALL REMOVED FIXTURES AND CONTROLS SHALL BE DISPOSED OF OFF-SITE UNLESS REQUESTED BY OWNER TO BE SALVAGED.
9. IDENTIFY AND REPORT UNFORESEEN CONDITIONS, SUCH AS CONCEALED JUNCTION BOXES, UNDOCUMENTED WIRING, INACCESSIBLE CONDUITS, OR DAMAGED CEILING, BEFORE PROCEEDING.
10. MAINTAIN EMERGENCY AND EGRESS LIGHTING UNTIL THE NEW SYSTEM IS INSTALLED AND ACCEPTED. DO NOT INTERRUPT LIFE-SAFETY LIGHTING WITHOUT OWNER/ENGINEER APPROVAL.
11. COORDINATE DEMOLITION WORK WITH SCHOOL OPERATIONS TO AVOID DISRUPTION DURING OCCUPIED HOURS AND COMPLY WITH DISTRICT SAFETY PROTOCOLS.
12. WHERE EXISTING CEILING TILES, GRIDS, OR ACCESS PANELS ARE REMOVED OR DAMAGED, PROVIDE TEMPORARY PROTECTION AND COORDINATE WITH CEILING CONTRACTOR FOR FINAL RESTORATION.
13. OTHER CEILING-MOUNTED EQUIPMENT:
 - A. NOTE THAT NOT ALL DEVICES MAY BE SHOWN, IT IS THE INTENT TO RE-INSTALL ALL EXISTING CEILING MOUNTED DEVICES UNLESS OTHERWISE NOTED. REMOVE AND RE-INSTALL CEILING-MOUNTED DEVICES INCLUDING FIRE ALARM DEVICES, WIRELESS ACCESS POINTS, PAGING SYSTEMS, SPEAKERS, PROJECTORS, AND CEILING MOUNTED RECEPTACLES.
 - B. COORDINATE REMOVAL WITH APPROPRIATE TRADES (FIRE ALARM, IT, SECURITY, A/V, ETC.) TO ENSURE PROPER DISCONNECTION, LABELING AND RELOCATION.
 - C. PROTECT ALL DEVICES NOTED TO REMAIN DURING DEMOLITION PROCESS. DO NOT DISTURB EXISTING FIRE ALARM, SECURITY, PAGING, DATA, OR OTHER COMMUNICATION CABLING. ANY ACCIDENTAL DAMAGE SHALL BE REPAIRED AT THE CONTRACTOR'S EXPENSE. DEVICES REMOVED AS PART OF CEILING WORK SHALL BE RE-INSTALLED AFTER NEW CEILING HAS BEEN INSTALLED. THIS INCLUDES FIRE ALARM, WIRELESS ACCESS POINTS, PAGING SYSTEMS, SPEAKERS, CLOCKS, PROJECTORS AND CEILING MOUNTED RECEPTACLES.
 - E. ITEMS BEING REMOVED AND RE-INSTALLED SHALL BE LOCATED AS CLOSE TO ORIGINAL POSITION AS POSSIBLE.

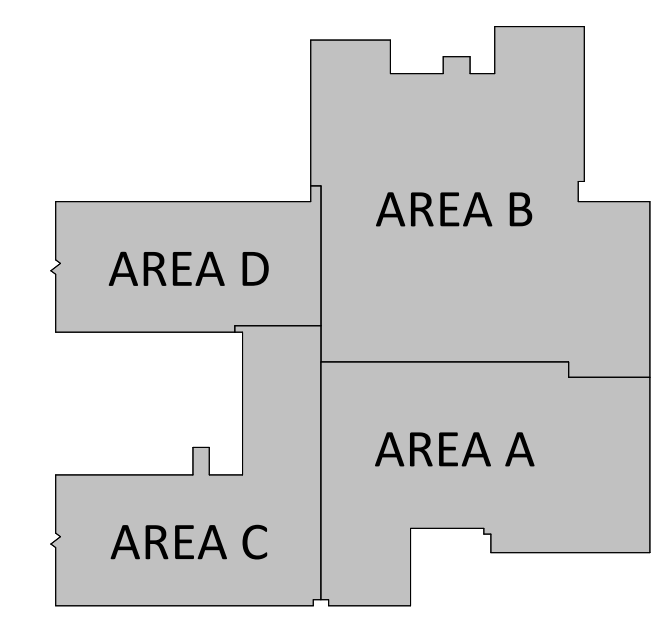

MIDDLE SCHOOL BUILDING KEY PLAN

DEMOLITION PLAN - OVERALL
1/16" = 1'-0"

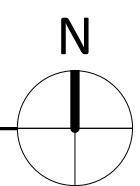


ISSUED FOR	
BIDDING	
DATE	02/20/2026
DESCRIPTION	DATE
ADDENDUM 01	03-02-2026

DRAWN BY	SMF
CHECKED BY	KDM
PROJECT NO.	9166-10000
SHEET NAME	

DEMOLITION PLAN - OVERALL

NOT FOR CONSTRUCTION

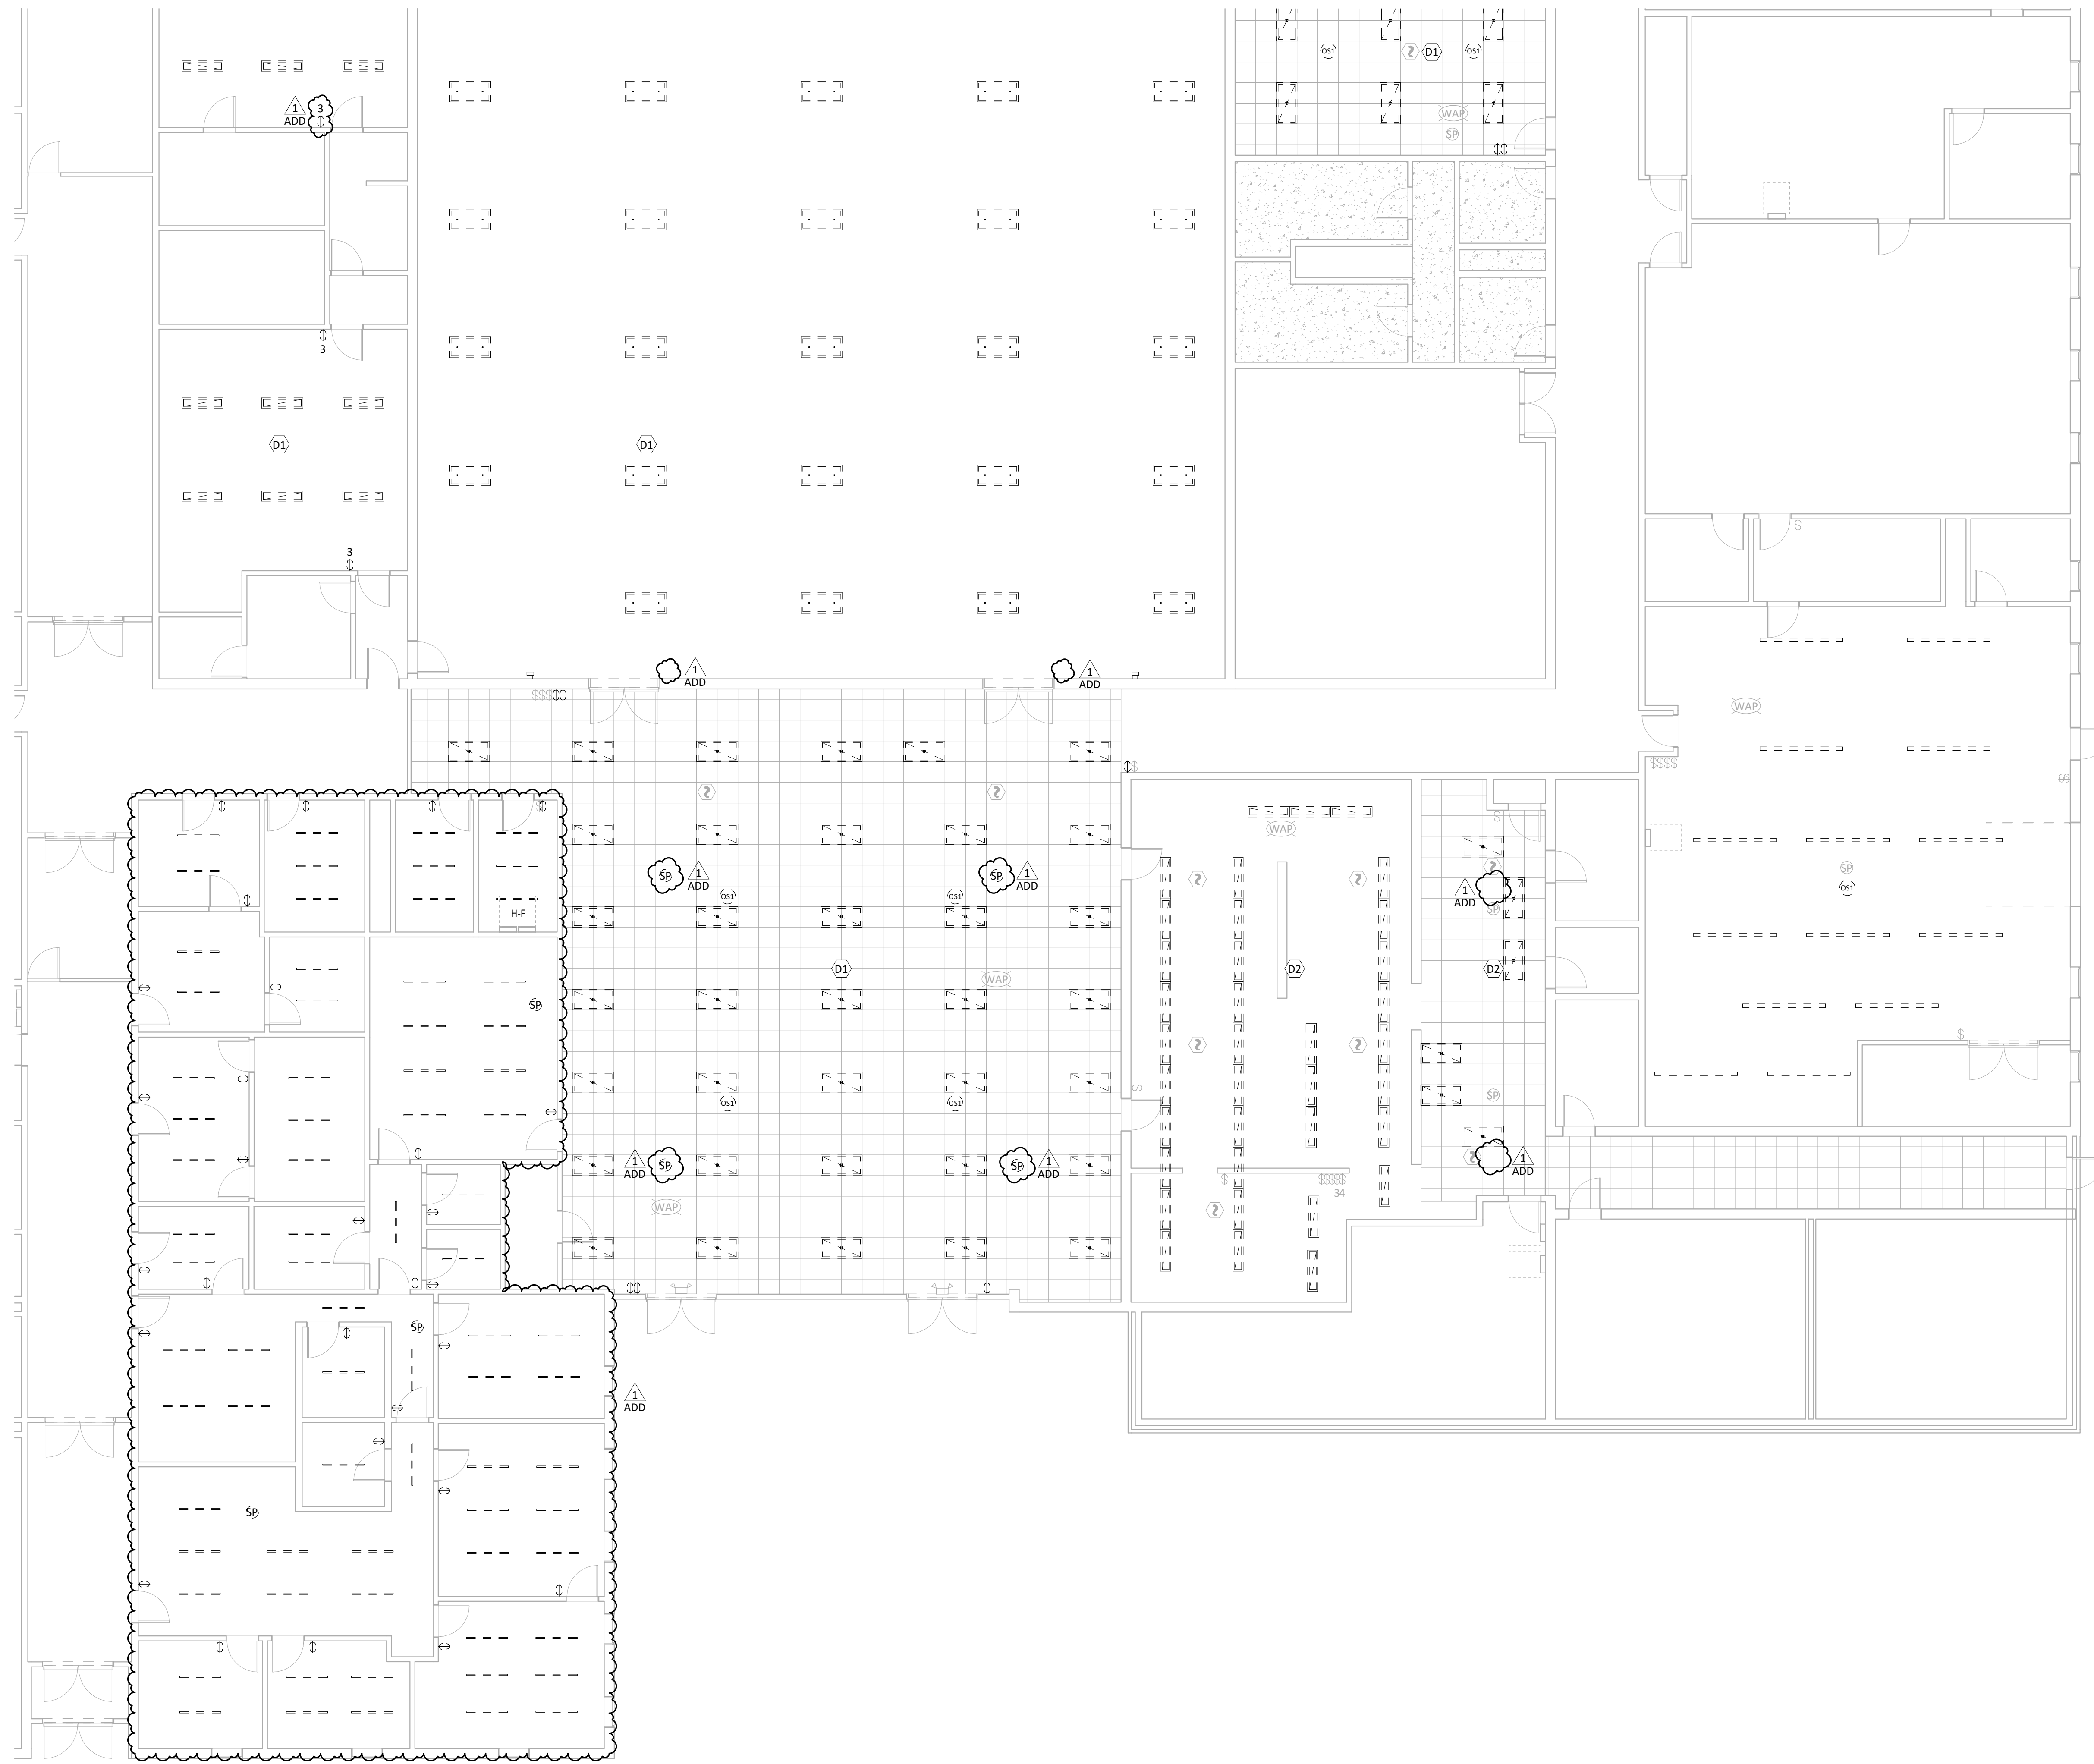

ELECTRICAL DEMO KEYED NOTES

D1 REMOVE AND RE-INSTALL CEILING MOUNTED DEVICES IN THIS AREA. NOTE THAT ALL DEVICES REQUIRING RE-INSTALLATION MAY NOT BE SHOWN. CONTRACTOR TO VERIFY CEILING MOUNTED DEVICES PRIOR TO BIDDING. RE-INSTALLED DEVICES AS CLOSE TO ORIGINAL LOCATION AS POSSIBLE.


D2 EXISTING CEILING AND CEILING MOUNTED DEVICE TO REMAIN. DEMO EXISTING LIGHTING IN THIS ROOM. NEW LIGHTS TO CONNECT TO EXISTING CIRCUITING AND CONTROLS.

ISSUED FOR

BIDDING	
DATE	02/20/2026
DESCRIPTION	DATE
ADDENDUM 01	03-02-2026

DRAWN BY	SMF
CHECKED BY	KDM
PROJECT NO.	9166-10000
SHEET NAME	


DEMOLITION PLAN - AREA A

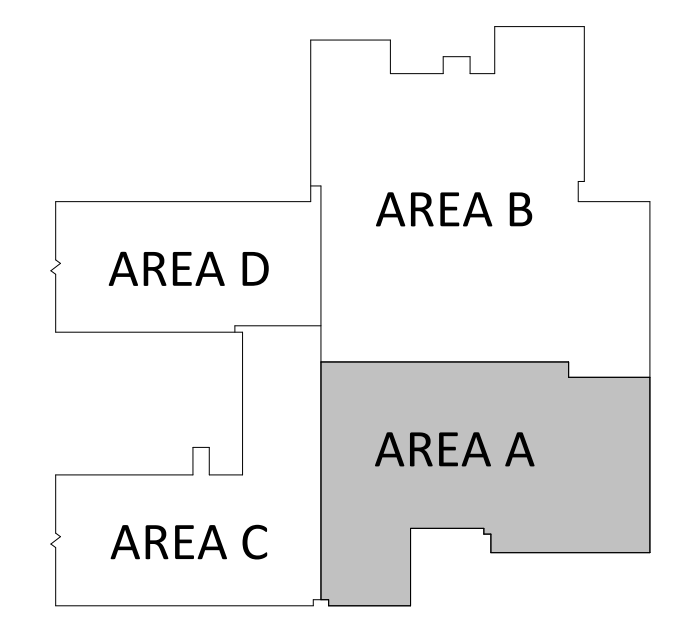

MIDDLE SCHOOL BUILDING KEY PLAN

DEMOLITION PLAN - AREA A
1/8" = 1'-0"

NOT FOR CONSTRUCTION

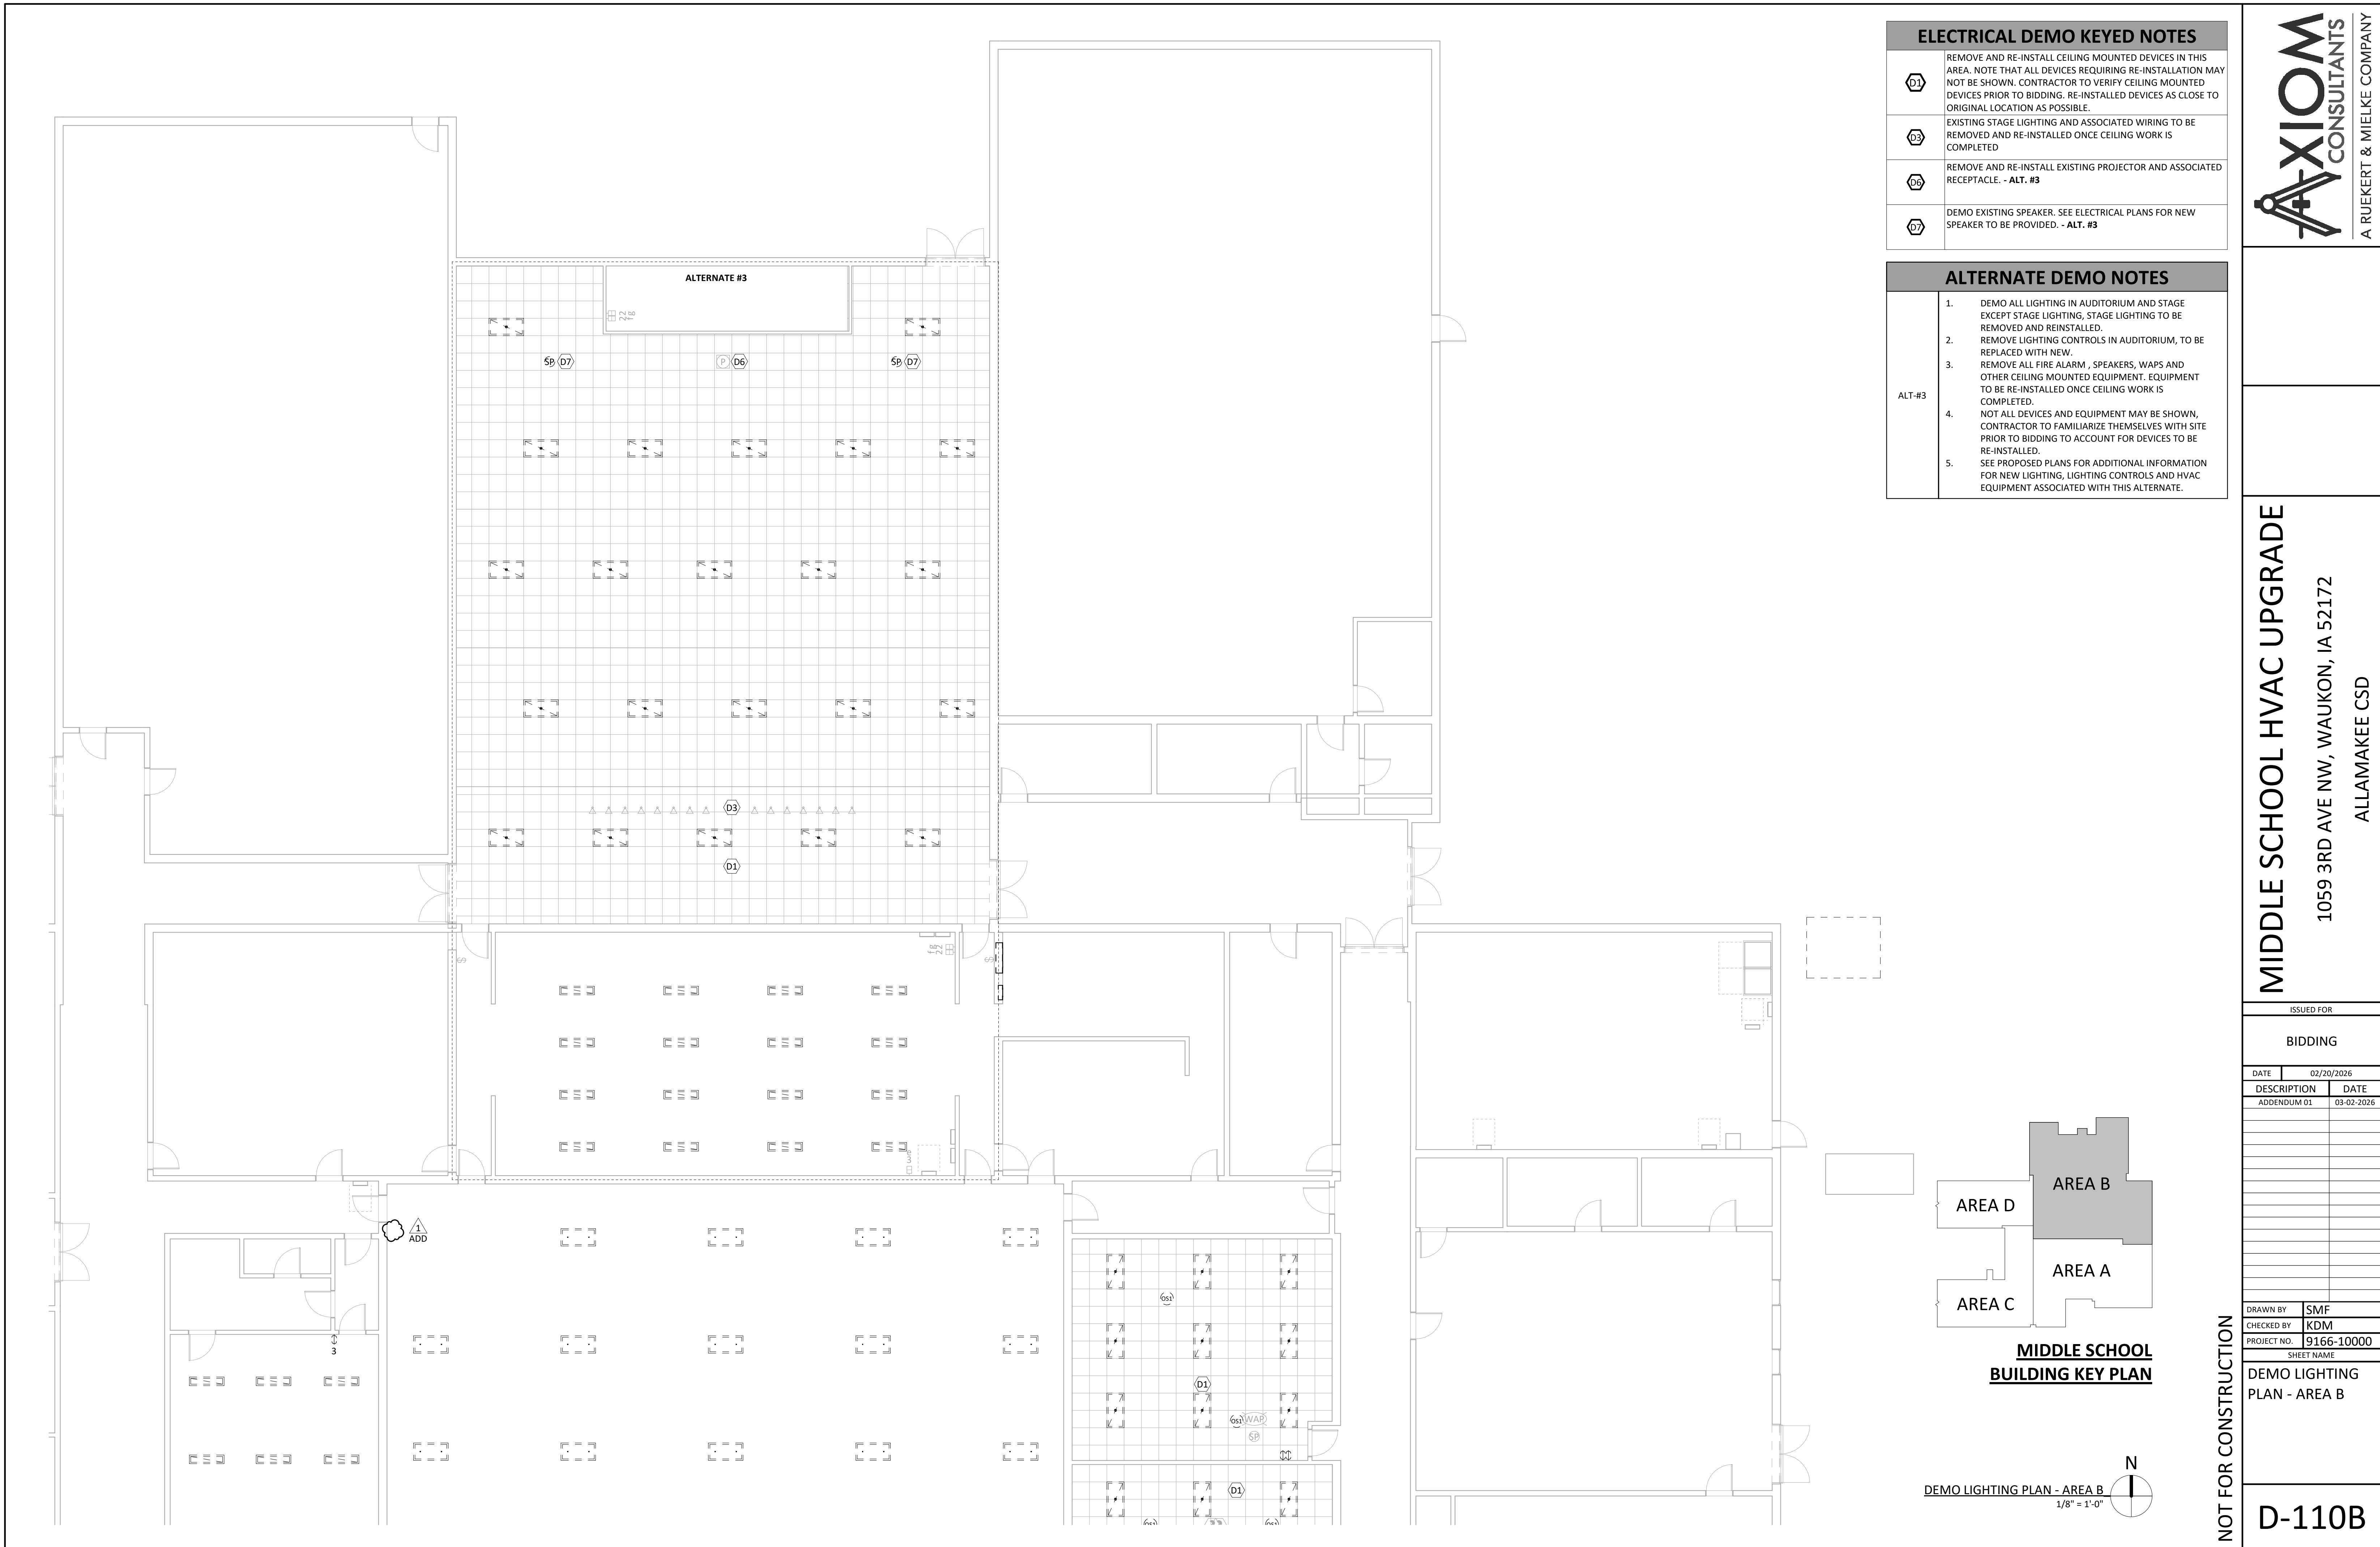


ELECTRICAL DEMO KEYED NOTES	
D1	REMOVE AND RE-INSTALL CEILING MOUNTED DEVICES IN THIS AREA. NOTE THAT ALL DEVICES REQUIRING RE-INSTALLATION MAY NOT BE SHOWN. CONTRACTOR TO VERIFY CEILING MOUNTED DEVICES PRIOR TO BIDDING. RE-INSTALLED DEVICES AS CLOSE TO ORIGINAL LOCATION AS POSSIBLE.
D3	EXISTING STAGE LIGHTING AND ASSOCIATED WIRING TO BE REMOVED AND RE-INSTALLED ONCE CEILING WORK IS COMPLETED
D6	REMOVE AND RE-INSTALL EXISTING PROJECTOR AND ASSOCIATED RECEPTACLE. - ALT. #3
D7	DEMO EXISTING SPEAKER. SEE ELECTRICAL PLANS FOR NEW SPEAKER TO BE PROVIDED. - ALT. #3

ALTERNATE DEMO NOTES	
ALT-#3	<ol style="list-style-type: none"> DEMO ALL LIGHTING IN AUDITORIUM AND STAGE EXCEPT STAGE LIGHTING, STAGE LIGHTING TO BE REMOVED AND REINSTALLED. REMOVE LIGHTING CONTROLS IN AUDITORIUM, TO BE REPLACED WITH NEW. REMOVE ALL FIRE ALARM, SPEAKERS, WAPS AND OTHER CEILING MOUNTED EQUIPMENT. EQUIPMENT TO BE RE-INSTALLED ONCE CEILING WORK IS COMPLETED. NOT ALL DEVICES AND EQUIPMENT MAY BE SHOWN, CONTRACTOR TO FAMILIARIZE THEMSELVES WITH SITE PRIOR TO BIDDING TO ACCOUNT FOR DEVICES TO BE RE-INSTALLED. SEE PROPOSED PLANS FOR ADDITIONAL INFORMATION FOR NEW LIGHTING, LIGHTING CONTROLS AND HVAC EQUIPMENT ASSOCIATED WITH THIS ALTERNATE.



MIDDLE SCHOOL HVAC UPGRADE
 1059 3RD AVE NW, WAUKON, IA 52172
 ALLAMAKEE CSD

ISSUED FOR	
BIDDING	
DATE	02/20/2026
DESCRIPTION	DATE
ADDENDUM 01	03-02-2026

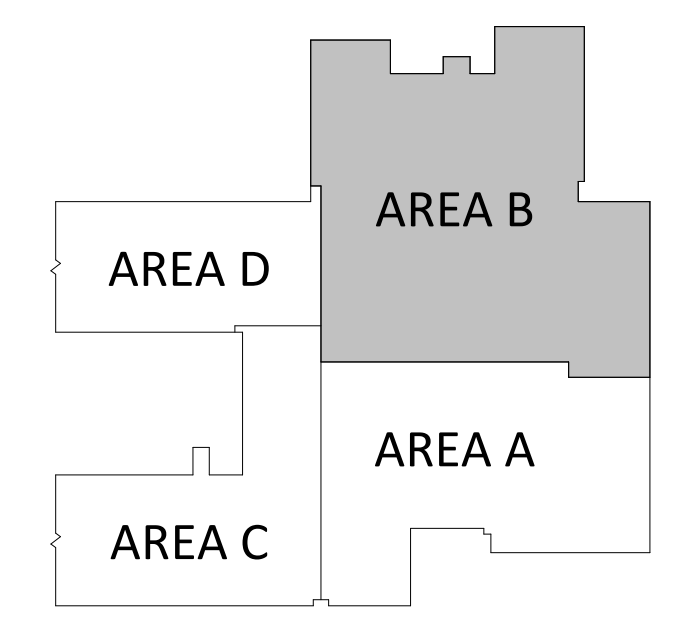

MIDDLE SCHOOL BUILDING KEY PLAN

DEMO LIGHTING PLAN - AREA B
 1/8" = 1'-0"

NOT FOR CONSTRUCTION

DRAWN BY	SMF
CHECKED BY	KDM
PROJECT NO.	9166-10000
SHEET NAME	

DEMO LIGHTING PLAN - AREA B

D-110B

ISSUED FOR

BIDDING

DATE	DESCRIPTION	DATE
02/20/2026		
03-02-2026	ADDENDUM 01	

DRAWN BY	JJR
CHECKED BY	JCL
PROJECT NO.	9166-10000
SHEET NAME	


MECHANICAL PLAN - AREA A

M-101A


NOT FOR CONSTRUCTION

- GENERAL MECHANICAL NOTES:**
- VERIFY ALL SITE CONDITIONS PRIOR TO STARTING WORK.
 - COORDINATE ALL DUCTWORK AND PIPE ROUTING WITH BUILDING STRUCTURE AND OTHER TRADES PRIOR TO INSTALLATION TO ALLOW FOR PROPER CLEARANCE SPACE.
 - MAINTAIN SERVICE CLEARANCE REQUIREMENTS AROUND ALL MECHANICAL EQUIPMENT AND ELECTRICAL EQUIPMENT. DO NOT ROUTE PIPING OR DUCTWORK IN CLEARANCE SPACE.
 - M.C. COORDINATE REFRIGERANT LINE ROUTING FROM CONDENSING UNITS TO THE RESPECTIVE UNITS.
 - MANUAL VOLUME DAMPERS SHALL BE PROVIDED ON ALL SUPPLY, RETURN, AND EXHAUST BRANCH DUCTS.
 - M.C. SHALL COORDINATE ANY AREA WHERE ACCESS TO EQUIPMENT OR HVAC COMPONENTS ARE REQUIRED TO ALLOW ACCESS FOR MAINTENANCE, OR INSPECTION WITH G.C.
 - VAV BOXES WITH MULTIPLE SUPPLY BRANCH DUCTS SHALL BE PROVIDED WITH A MANUAL VOLUME DAMPER ON ALL BRANCHES.
 - VAV BOXES SERVING A SINGLE SUPPLY DIFFUSER SHALL HAVE **NO** MANUAL VOLUME DAMPERS INSTALLED.
 - NO** MANUAL VOLUME DAMPERS SHALL BE INSTALLED UPSTREAM OF VAV BOXES. ALL MANUAL VOLUME DAMPERS SHALL BE INSTALLED IN ACCESSIBLE LOCATIONS FOR PURPOSES OF BALANCING THE AIRFLOW OF THE SYSTEM.
 - IF DUCT SIZE REVISIONS ARE NECESSARY FOR COORDINATION PURPOSES ETC. NEW DUCT SIZE SHALL BE EQUIVALENT TO THE DUCT SIZE INDICATED ON PLANS. REFER TO VARIABLE VOLUME TERMINALS SCHEDULE FOR VAV TERMINAL INLET DUCT SIZES ON SHEET **M-601**.
 - THE SIZE OF EACH BRANCH DUCT TO A VAV SHALL MATCH THE VAV'S INLET SIZE UNLESS THE BRANCH IS GREATER THAN 6'-0" IN LENGTH, THEN THE BRANCH SHOULD BE INCREASED ONE DUCT SIZE, OR NOTED OTHERWISE.
 - VAV INLET DUCTWORK REQUIREMENTS AS FOLLOWS:
 - MINIMUM 3X DIAMETER STRAIGHT INLET DUCT TO EACH VAV BOX.
 - IF BRANCH DUCT IS LONGER THAN 6'-0" IN LENGTH, BRANCH DUCT SHALL BE SIZED TO ACCOMMODATE AIRFLOW RATE UNTIL THE 3X DIAMETER STRAIGHT DUCT INLET.
 - VAV BOX DISCHARGE SHALL INCLUDE A SOUND ATTENUATOR, 3'-0" IN LENGTH.

- MECHANICAL KEYNOTES:**
- WALK-IN COOLER REFRIGERATION SYSTEM - EVAPORATOR:
ONE (1) EVAPORATIVE COIL INSTALLED IN WALK-IN COOLER
COOLING CAPACITY: 25MBH
FOUR (4) FANS, 2-SPEED EC
ELECTRICAL: 15.2A, 120V, 1-PHASE, 60Hz
REFER TO **M-201** FOR ROOF MOUNTED CONDENSING UNIT INFORMATION
BASIS OF DESIGN: BOHN MODEL BEL0250AS6AMB0200 LOW P/AIR
 - WALK-IN FREEZER REFRIGERATION SYSTEM - EVAPORATOR:
TWO (2) EVAPORATIVE COIL INSTALLED IN WALK-IN COOLER
COOLING CAPACITY: 13.5 MBH
THREE (3) FANS, 2-SPEED EC
ELECTRICAL: 15.2A, 208V, 1-PHASE, 60 Hz
REFER TO **M-201** FOR ROOF MOUNT CONDENSING UNIT INFORMATION
BASIS OF DESIGN: BOHN MODEL BEL0130B56MAB0200 P/ELEC

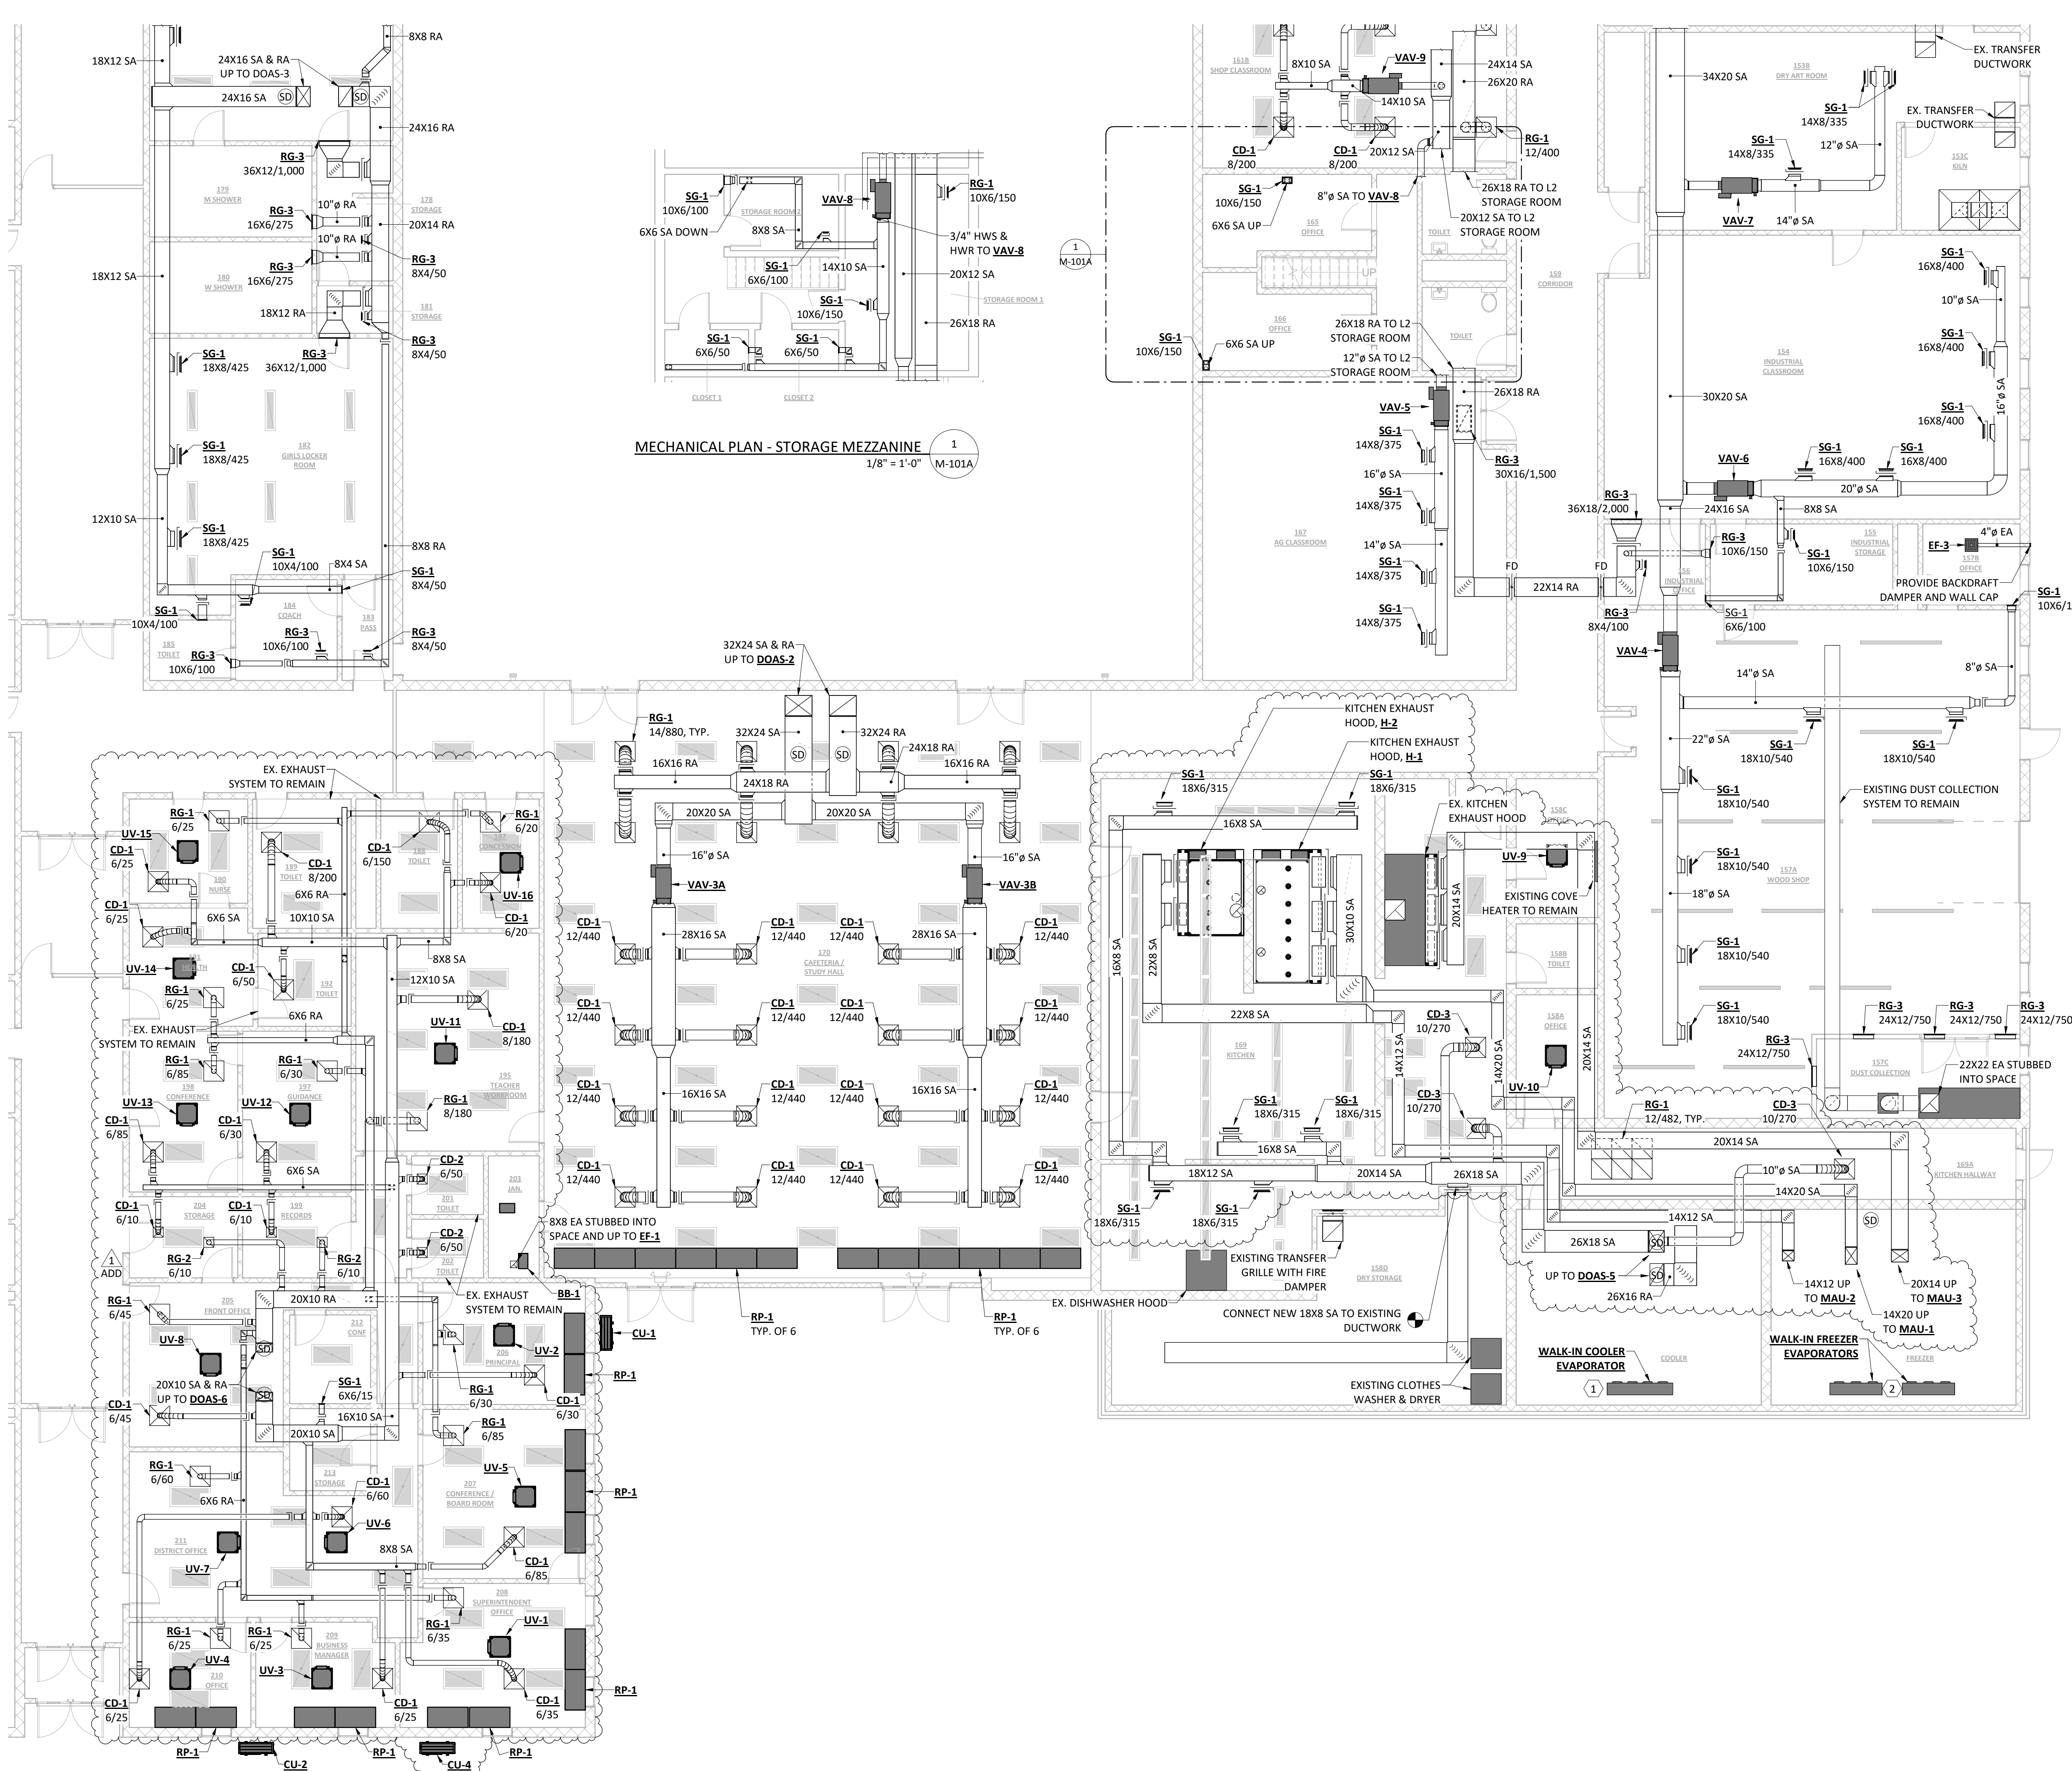

MECHANICAL PLAN - STORAGE MEZZANINE
1/8" = 1'-0" M-101A

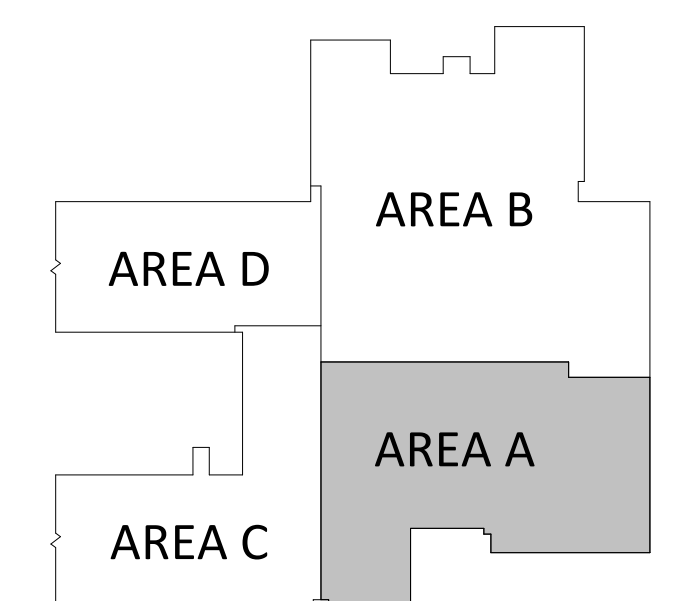

MIDDLE SCHOOL BUILDING KEY PLAN

MECHANICAL PLAN - AREA A
1/8" = 1'-0"

DATE	DESCRIPTION	DATE
02/20/2026		
03-02-2026	ADDENDUM 01	

DRAWN BY	JJR
CHECKED BY	JCL
PROJECT NO.	9166-10000
SHEET NAME	

MECHANICAL PLAN
- AREA B



M-101B

GENERAL MECHANICAL NOTES:

- VERIFY ALL SITE CONDITIONS PRIOR TO STARTING WORK.
- COORDINATE ALL DUCTWORK AND PIPE ROUTING WITH BUILDING STRUCTURE AND OTHER TRADES PRIOR TO INSTALLATION TO ALLOW FOR PROPER CLEARANCE SPACE.
- MAINTAIN SERVICE CLEARANCE REQUIREMENTS AROUND ALL MECHANICAL EQUIPMENT AND ELECTRICAL EQUIPMENT. DO NOT ROUTE PIPING OR DUCTWORK IN CLEARANCE SPACE.
- M.C. COORDINATE REFRIGERANT LINE ROUTING FROM CONDENSING UNITS TO THE RESPECTIVE UNITS.
- MANUAL VOLUME DAMPERS SHALL BE PROVIDED ON ALL SUPPLY, RETURN, AND EXHAUST BRANCH DUCTS.
- M.C. SHALL COORDINATE ANY AREA WHERE ACCESS TO EQUIPMENT OR HVAC COMPONENTS ARE REQUIRED TO ALLOW ACCESS FOR MAINTENANCE, OR INSPECTION WITH G.C.
- VAV BOXES WITH MULTIPLE SUPPLY BRANCH DUCTS SHALL BE PROVIDED WITH A MANUAL VOLUME DAMPER ON ALL BRANCHES.
- VAV BOXES SERVING A SINGLE SUPPLY DIFFUSER SHALL HAVE NO MANUAL VOLUME DAMPERS INSTALLED.
- NO MANUAL VOLUME DAMPERS SHALL BE INSTALLED UPSTREAM OF VAV BOXES. ALL MANUAL VOLUME DAMPERS SHALL BE INSTALLED IN ACCESSIBLE LOCATIONS FOR PURPOSES OF BALANCING THE AIRFLOW OF THE SYSTEM.
- IF DUCT SIZE REVISIONS ARE NECESSARY FOR COORDINATION PURPOSES ETC. NEW DUCT SIZE SHALL BE EQUIVALENT TO THE DUCT SIZE INDICATED ON PLANS. REFER TO VARIABLE VOLUME TERMINALS SCHEDULE FOR VAV TERMINAL INLET DUCT SIZES ON SHEET M-601.
- THE SIZE OF EACH BRANCH DUCT TO A VAV SHALL MATCH THE VAV'S INLET SIZE UNLESS THE BRANCH IS GREATER THAN 6'-0" IN LENGTH, THEN THE BRANCH SHOULD BE INCREASED ONE DUCT SIZE, OR NOTED OTHERWISE.
- VAV INLET DUCTWORK REQUIREMENTS AS FOLLOWS:
 - MINIMUM 3X DIAMETER STRAIGHT INLET DUCT TO EACH VAV BOX.
 - IF BRANCH DUCT IS LONGER THAN 3X DIAMETER, BRANCH DUCT SHALL BE SIZED TO ACCOMMODATE AIRFLOW RATE UNTIL THE 3X DIAMETER STRAIGHT DUCT INLET.
 - VAV BOX DISCHARGE SHALL INCLUDE A SOUND ATTENUATOR, 3'-0" IN LENGTH.

MECHANICAL KEYNOTES:


- PROVIDE CO & GAS SENSOR IN ROOM TECH LAB ROOM E155.

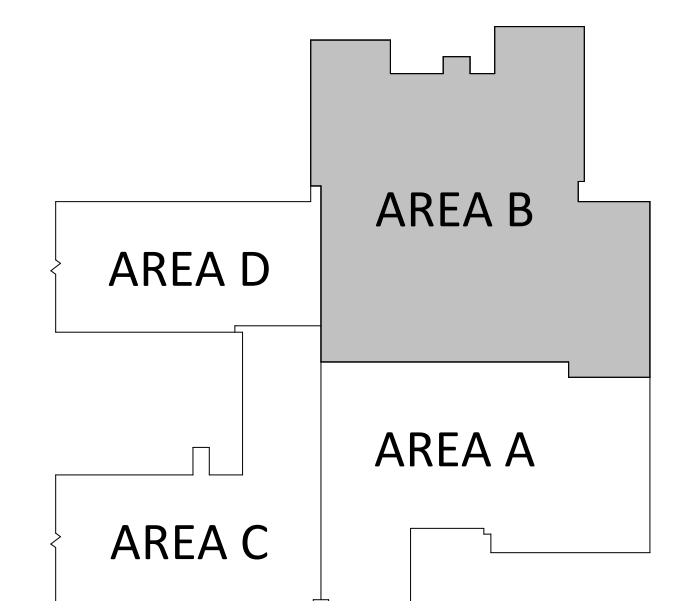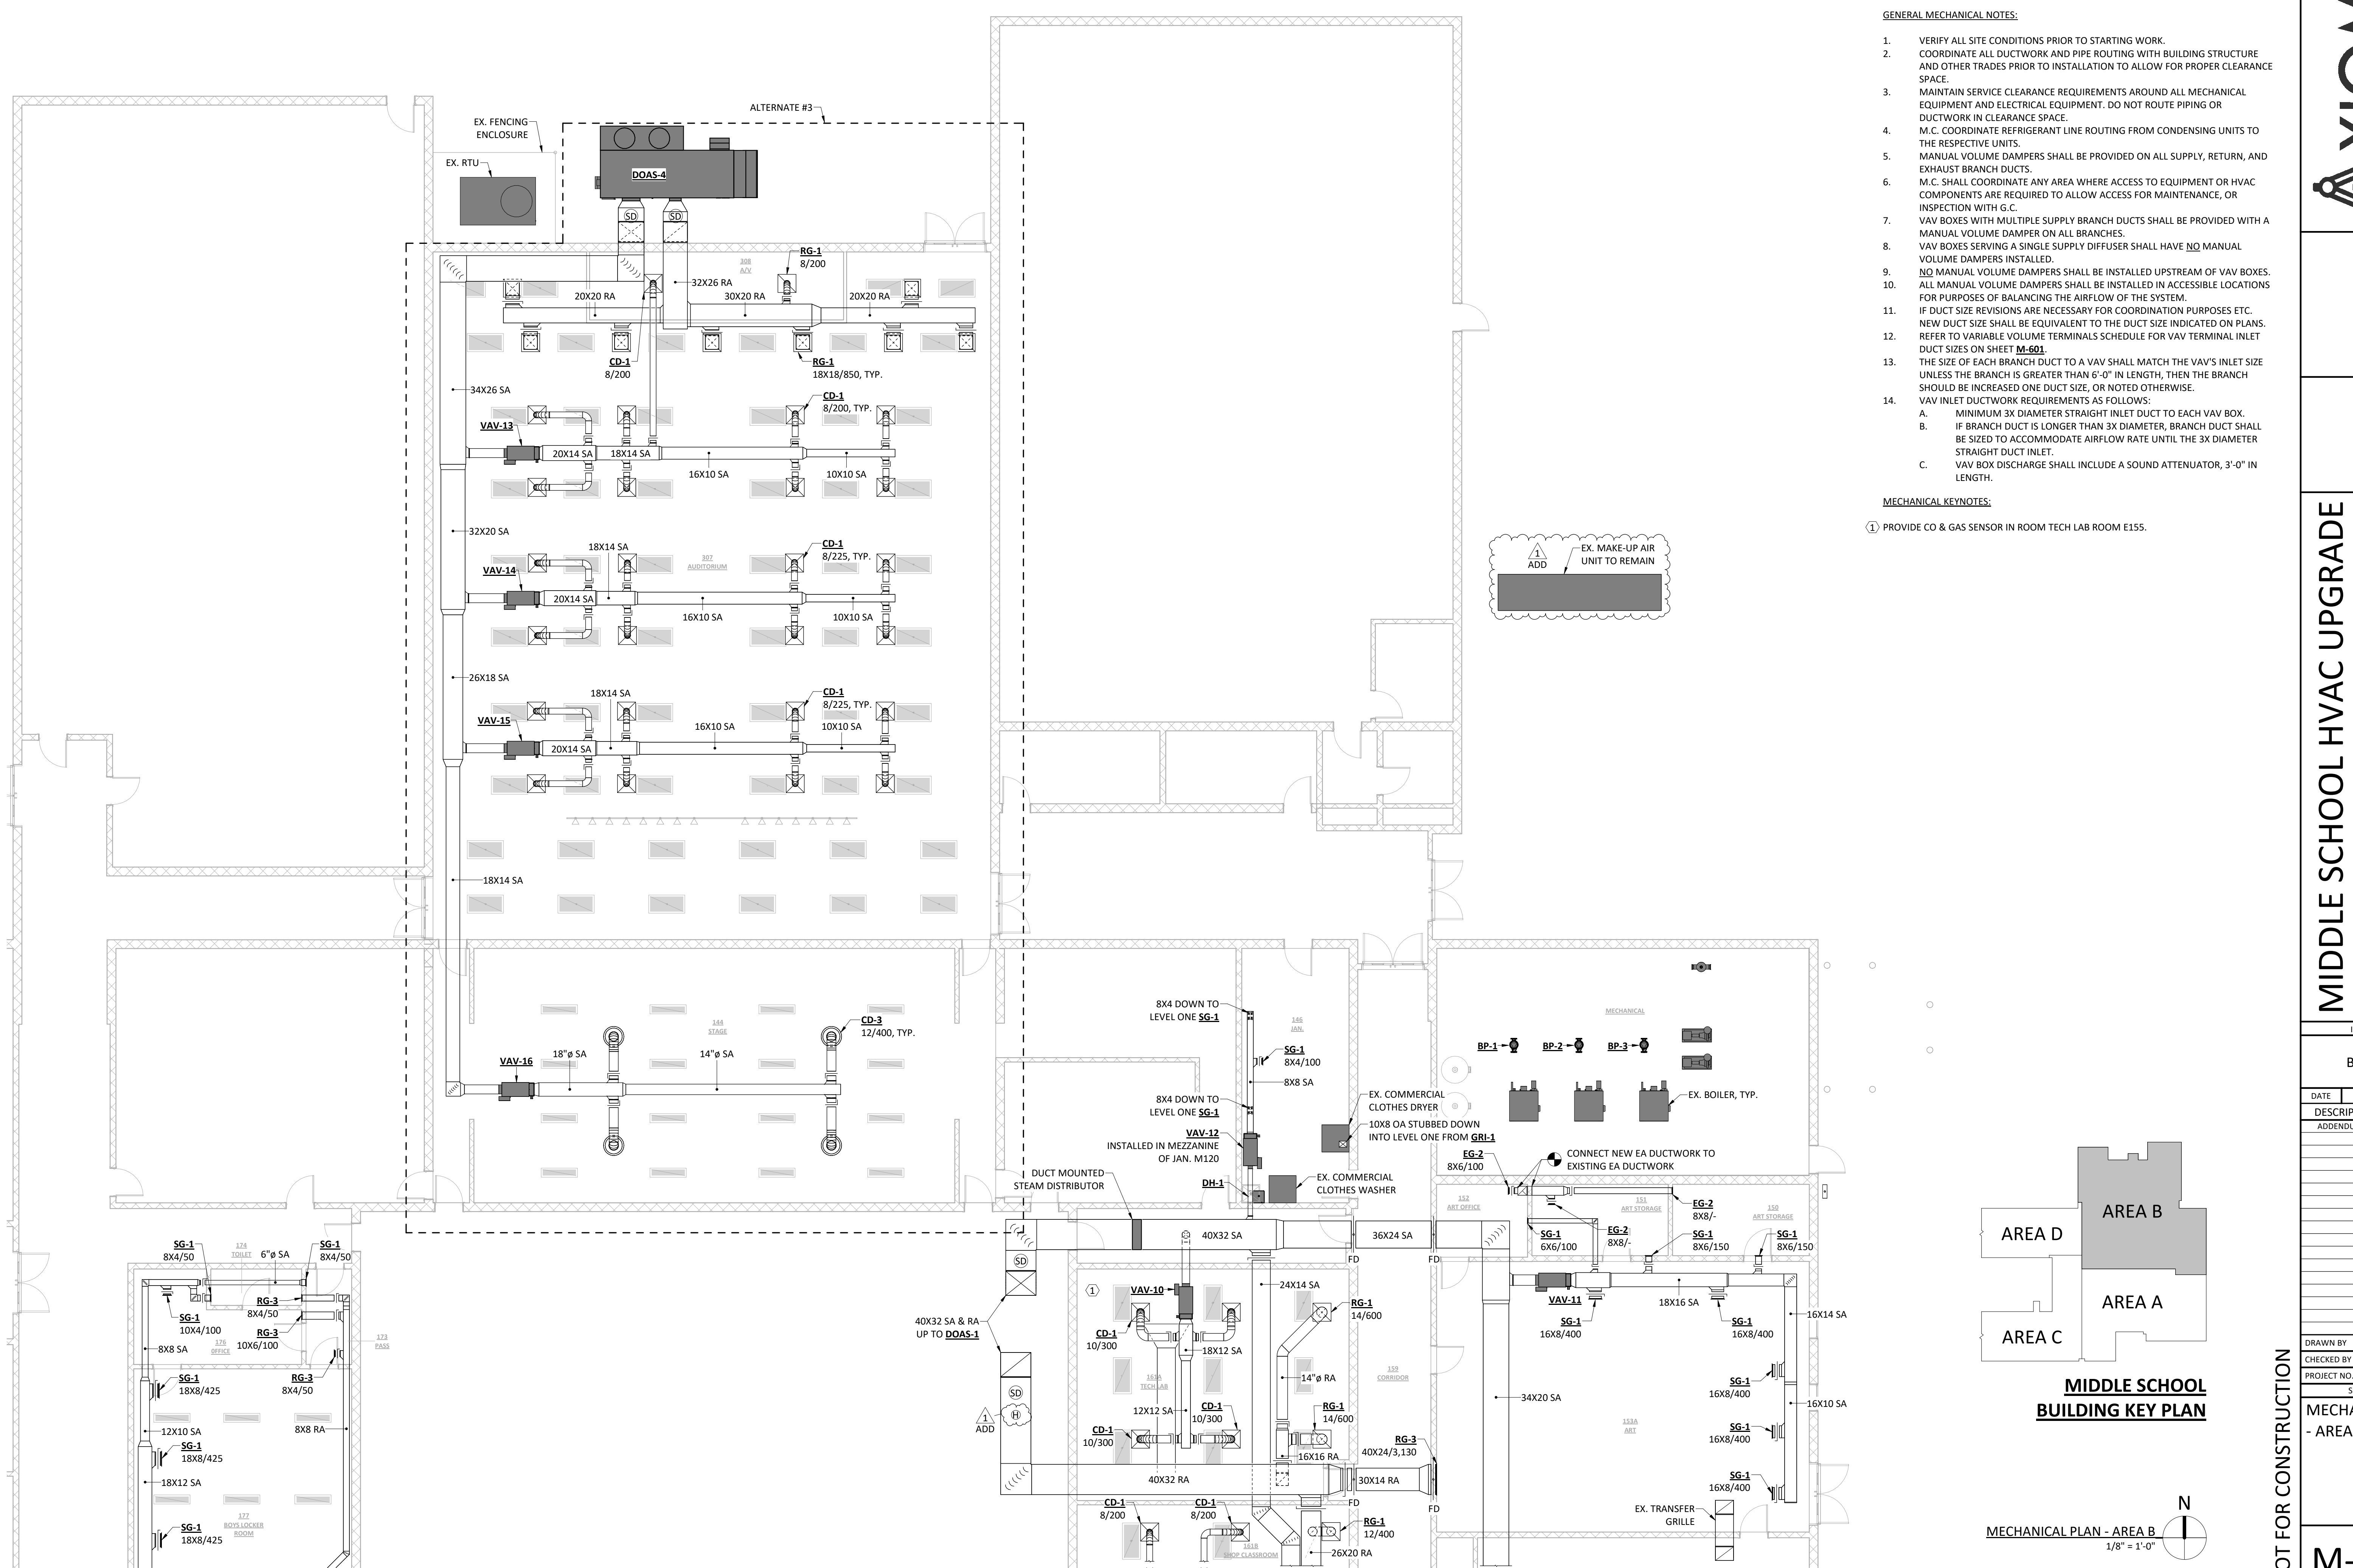

MIDDLE SCHOOL BUILDING KEY PLAN

MECHANICAL PLAN - AREA B
1/8" = 1'-0"

NOT FOR CONSTRUCTION

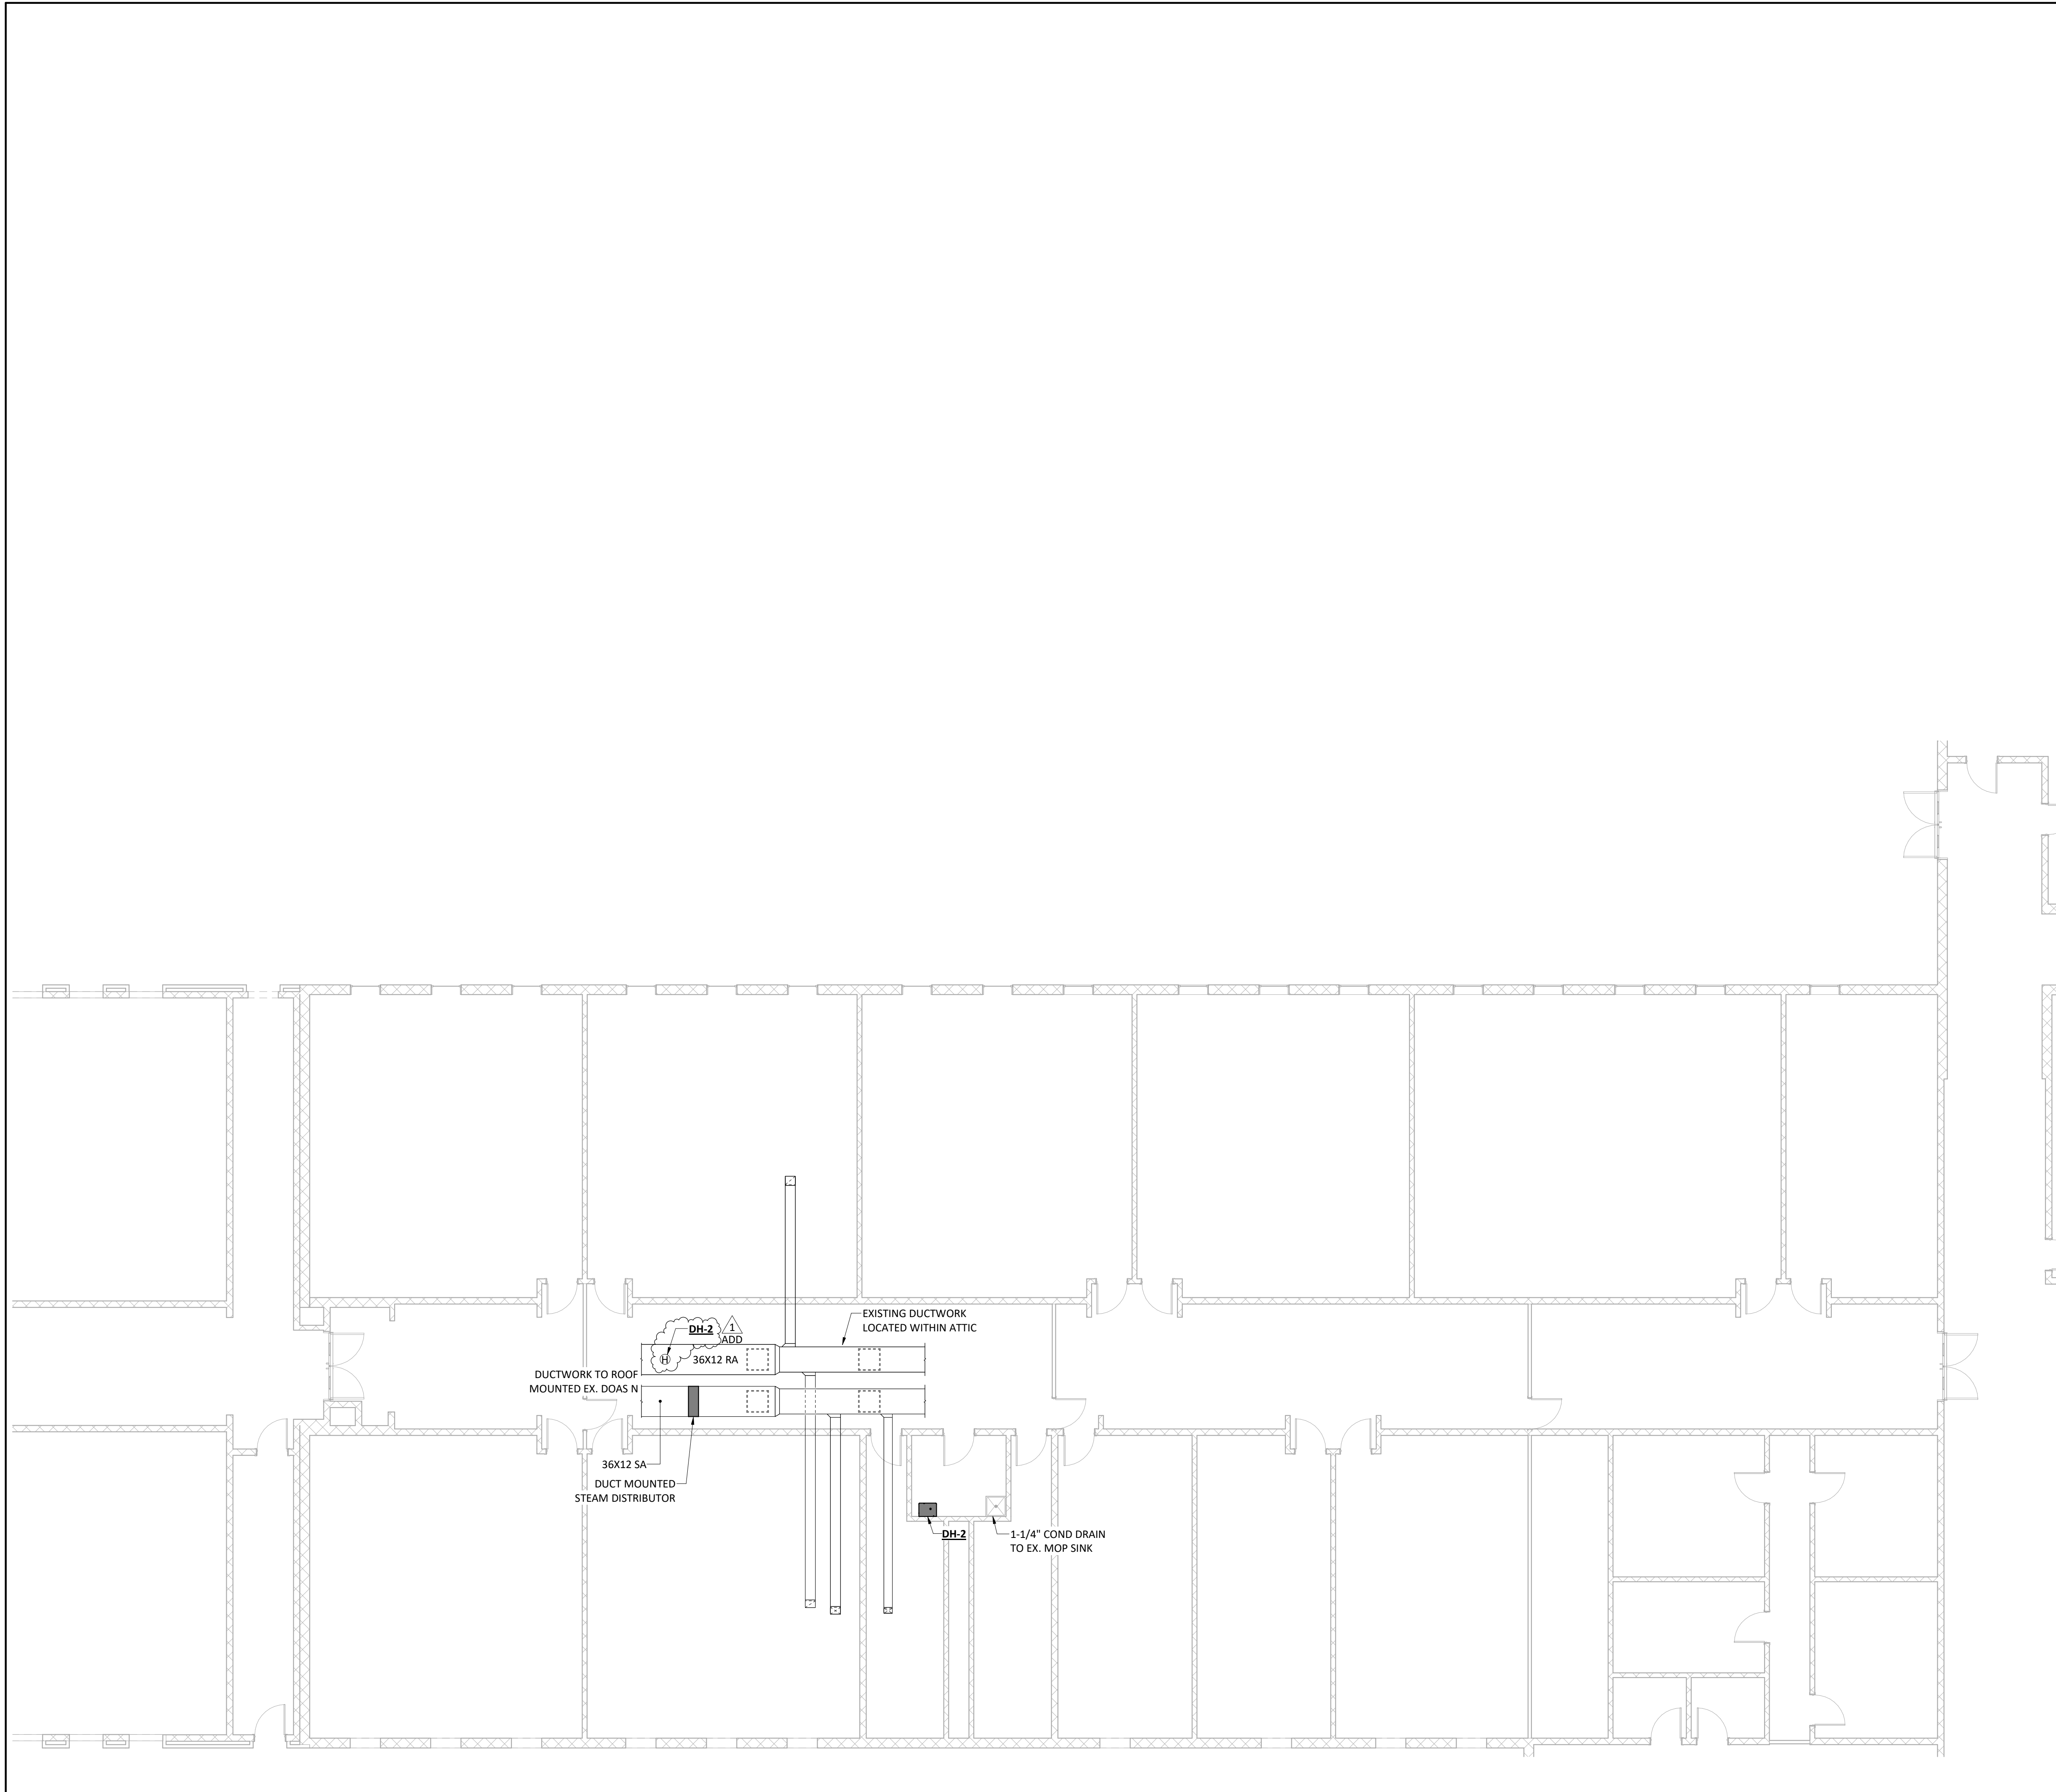

- GENERAL MECHANICAL NOTES:**
1. VERIFY ALL SITE CONDITIONS PRIOR TO STARTING WORK.
 2. COORDINATE ALL DUCTWORK AND PIPE ROUTING WITH BUILDING STRUCTURE AND OTHER TRADES PRIOR TO INSTALLATION TO ALLOW FOR PROPER CLEARANCE SPACE.
 3. MAINTAIN SERVICE CLEARANCE REQUIREMENTS AROUND ALL MECHANICAL EQUIPMENT AND ELECTRICAL EQUIPMENT. DO NOT ROUTE PIPING OR DUCTWORK IN CLEARANCE SPACE.
 4. M.C. COORDINATE REFRIGERANT LINE ROUTING FROM CONDENSING UNITS TO THE RESPECTIVE UNITS.
 5. MANUAL VOLUME DAMPERS SHALL BE PROVIDED ON ALL SUPPLY, RETURN, AND EXHAUST BRANCH DUCTS.
 6. M.C. SHALL COORDINATE ANY AREA WHERE ACCESS TO EQUIPMENT OR HVAC COMPONENTS ARE REQUIRED TO ALLOW ACCESS FOR MAINTENANCE, OR INSPECTION WITH G.C.




A RUEKERT & MIELKE COMPANY

MIDDLE SCHOOL HVAC UPGRADE

1059 3RD AVE NW, WAUKON, IA 52172

ALLAMAKEE CSD

ISSUED FOR	
BIDDING	
DATE	02/20/2026
DESCRIPTION	DATE
ADDENDUM 01	03-02-2026

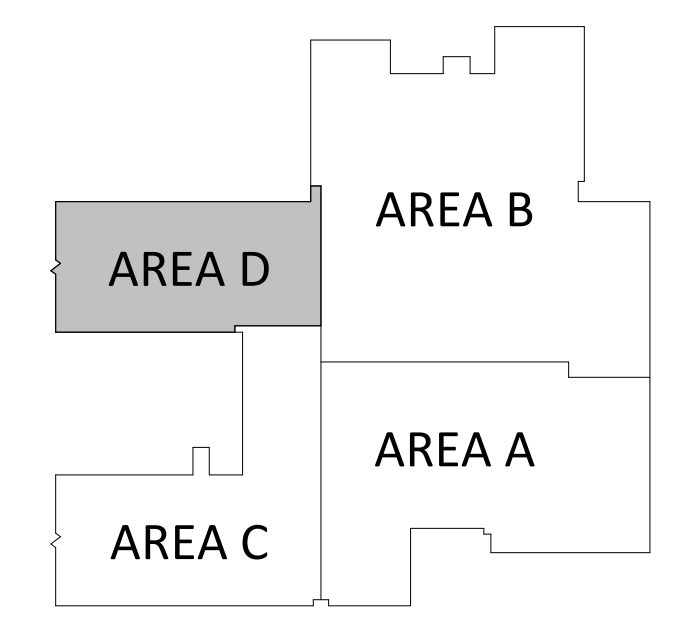

MIDDLE SCHOOL BUILDING KEY PLAN

MECHANICAL PLAN - AREA D
1/8" = 1'-0"

NOT FOR CONSTRUCTION

DRAWN BY	JJR
CHECKED BY	JCL
PROJECT NO.	9166-10000
SHEET NAME	

MECHANICAL PLAN - AREA D


M-101D

GENERAL MECHANICAL NOTES:


1. VERIFY ALL SITE CONDITIONS PRIOR TO STARTING WORK.
2. COORDINATE ALL DUCTWORK AND PIPE ROUTING WITH BUILDING STRUCTURE AND OTHER TRADES PRIOR TO INSTALLATION TO ALLOW FOR PROPER CLEARANCE SPACE.
3. MAINTAIN SERVICE CLEARANCE REQUIREMENTS AROUND ALL MECHANICAL EQUIPMENT AND ELECTRICAL EQUIPMENT. DO NOT ROUTE PIPING OR DUCTWORK IN CLEARANCE SPACE.
4. M.C. COORDINATE REFRIGERANT LINE ROUTING FROM CONDENSING UNITS TO THE RESPECTIVE UNITS.
5. MANUAL VOLUME DAMPERS SHALL BE PROVIDED ON ALL SUPPLY, RETURN, AND EXHAUST BRANCH DUCTS.
6. M.C. SHALL COORDINATE ANY AREA WHERE ACCESS TO EQUIPMENT OR HVAC COMPONENTS ARE REQUIRED TO ALLOW ACCESS FOR MAINTENANCE, OR INSPECTION WITH G.C.

GENERAL NATURAL GAS NOTES

1. NATURAL GAS PIPING SIZED PER IFGC 2021 - TABLE 402.4(5); INLET PRESSURE AT 2.0 PSI | PRESSURE DROP OF 1.0 PSI.
 - A. ASSUMED DEVELOPED LENGTH OF PIPING = 1,200 FEET.
 - B. TOTAL EXISTING BUILDING NATURAL GAS LOAD = 23,138 CFH (ESTIMATED FROM EXISTING PLANS, AND PREVIOUS HVAC UPGRADE PROJECT).
 - C. TOTAL ADDED NATURAL GAS LOAD THIS PROJECT (BASE + ALT.) = 2,683 CFH.
 - D. TOTAL EXISTING GAS METER CAPACITY = 16,000 CFH. (STATED FROM PREVIOUS HVAC UPGRADE PLANS)
 - E. NEW GAS METER CAPACITY = 26,000 CFH.
 - F. GAS PIPE SIZING UTILIZES 1,000 BTUH PER CUBIC FOOT (CFH).
2. PROVIDE EACH NATURAL GAS-FIRED EQUIPMENT WITH MANUAL GAS SHUTOFF VALVE AND A PRESSURE REGULATOR.
3. NATURAL GAS PRESSURE REGULATORS SHALL BE VENTED TO THE EXTERIOR PER MANUFACTURER'S REQUIREMENTS.

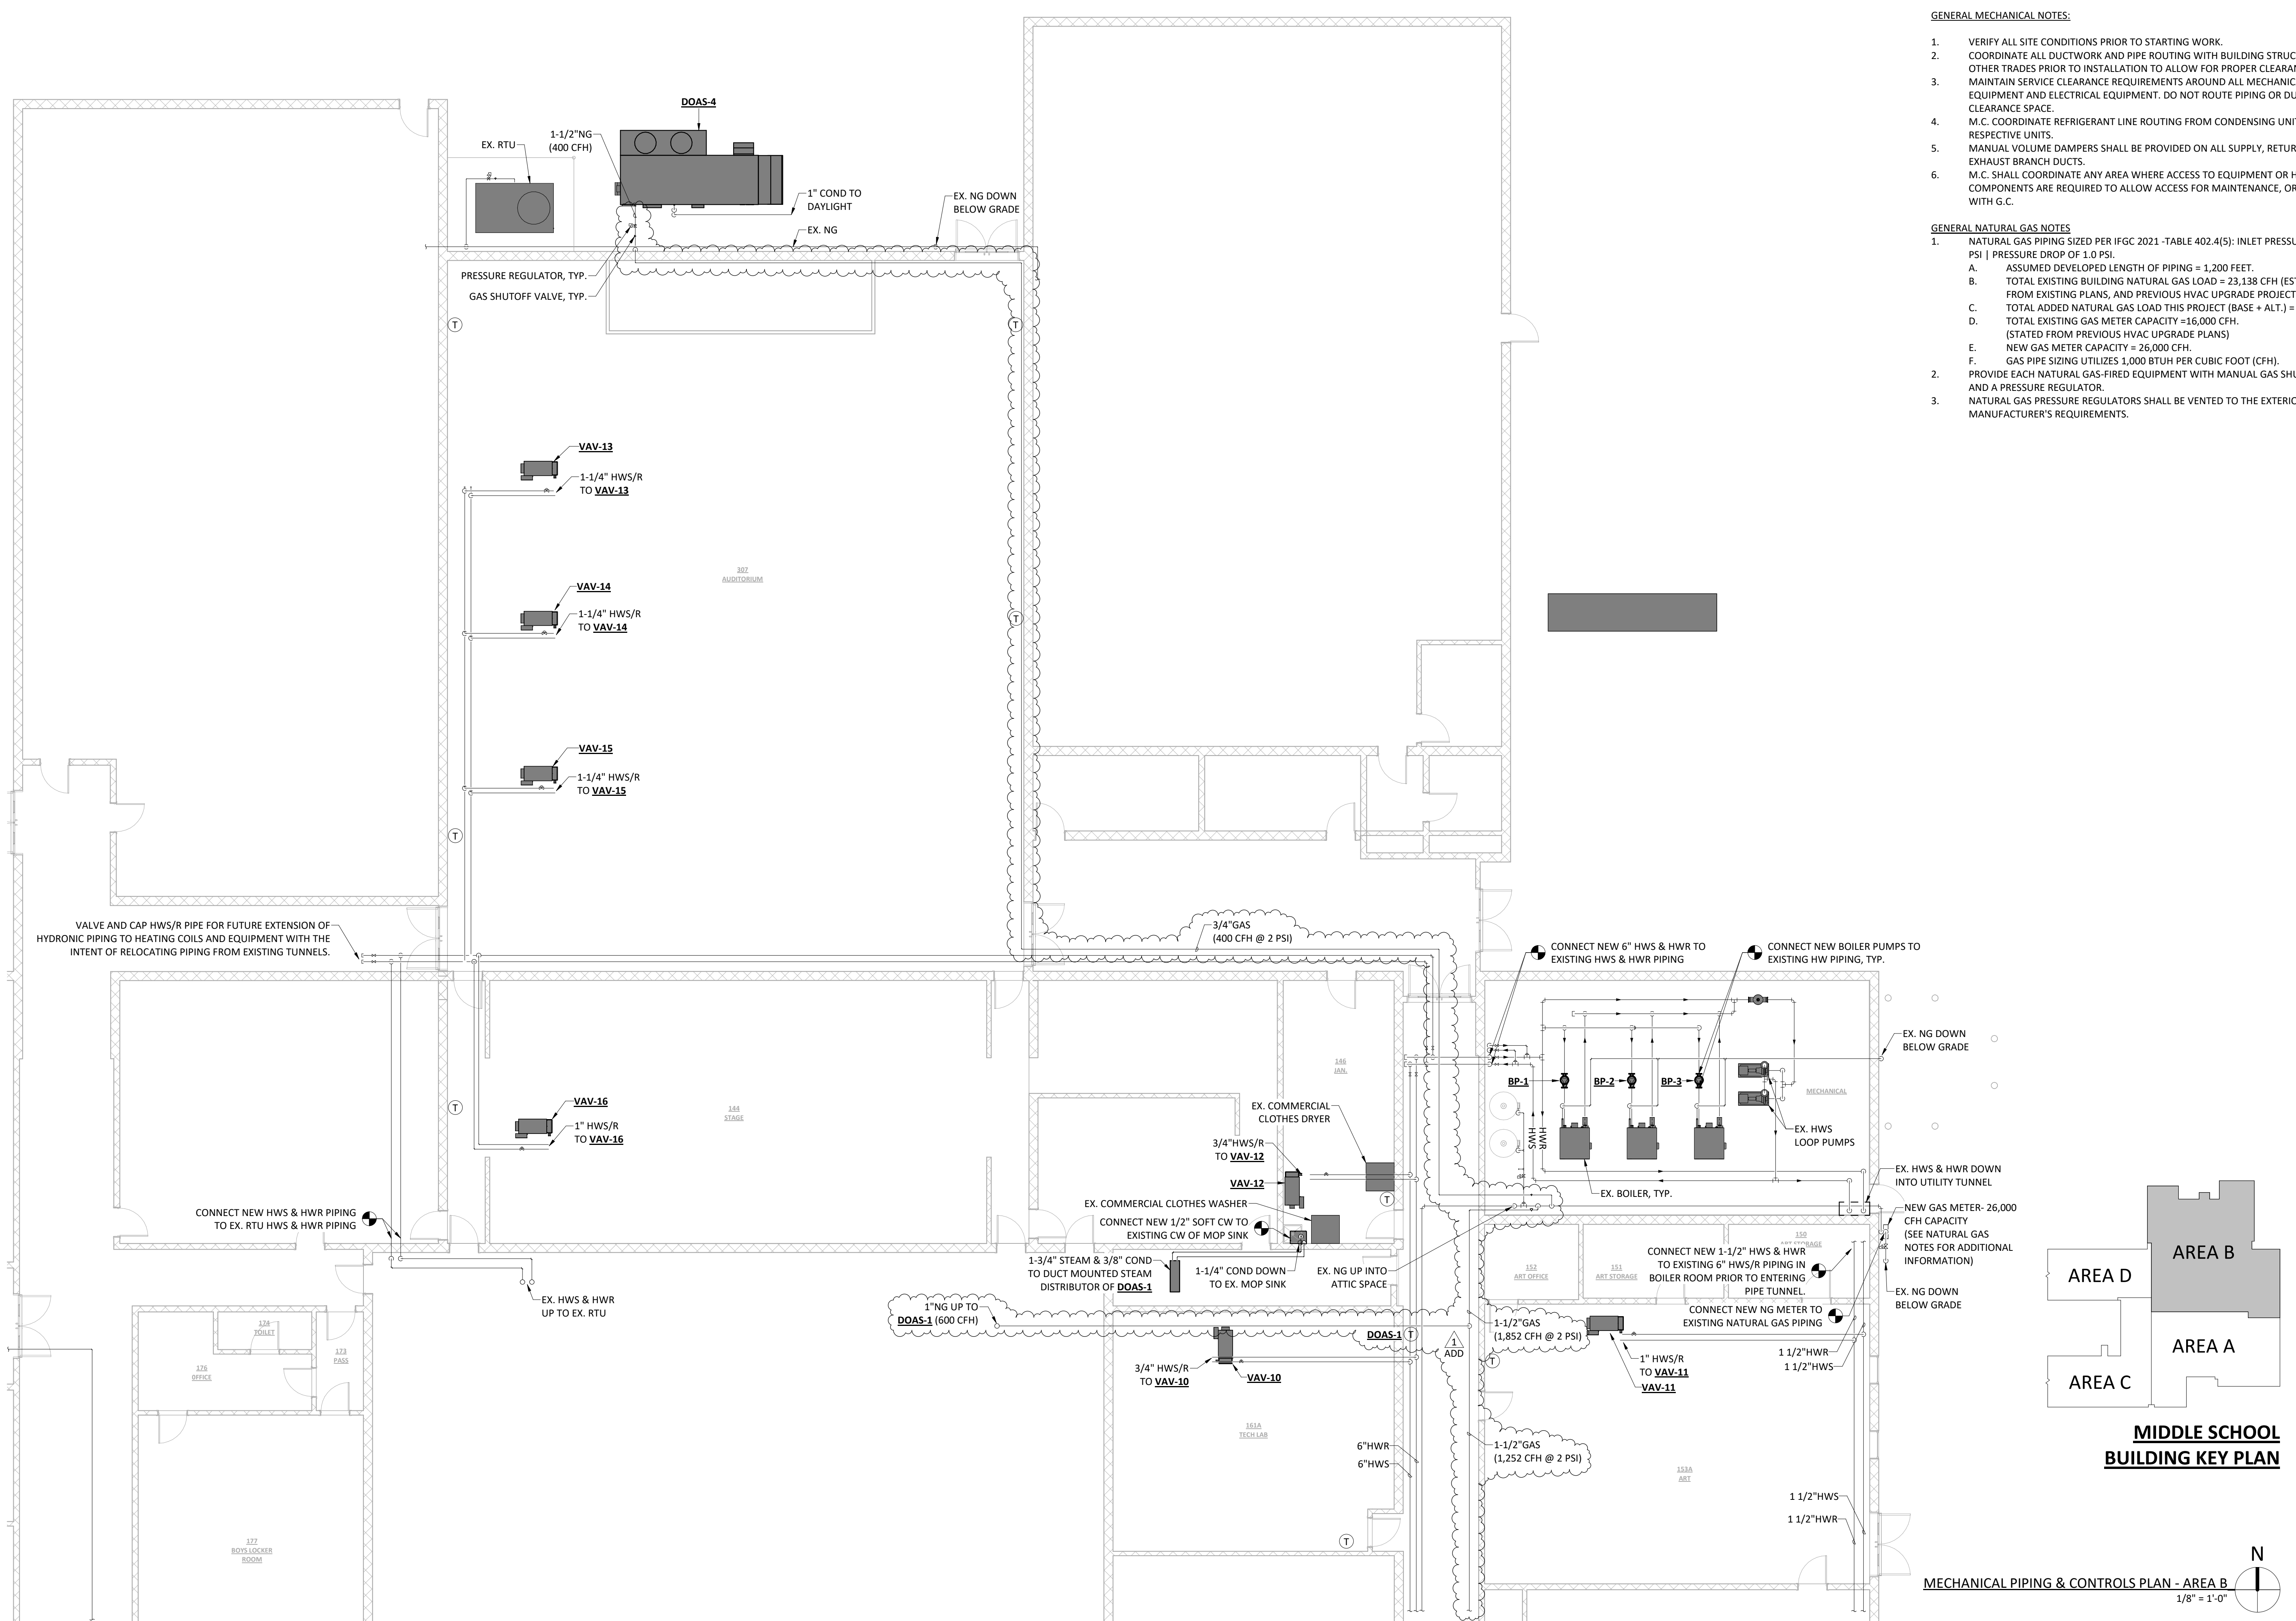

MIDDLE SCHOOL BUILDING KEY PLAN
MECHANICAL PIPING & CONTROLS PLAN - AREA B
1/8" = 1'-0"

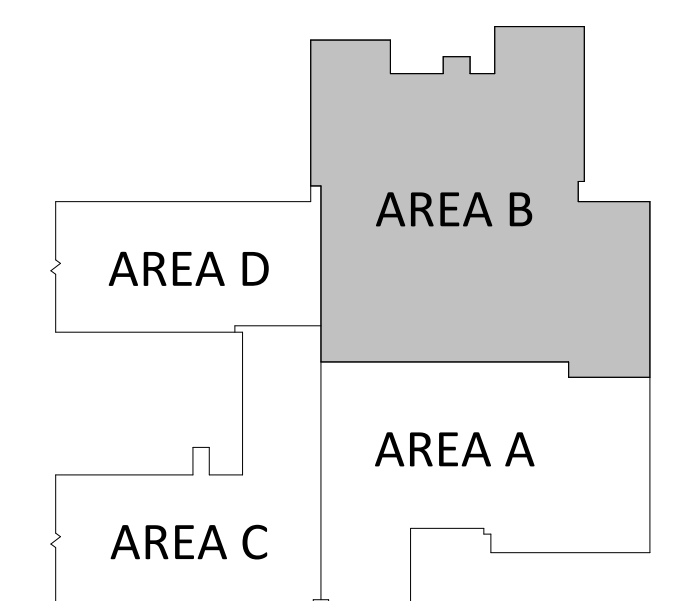

ISSUED FOR	
BIDDING	
DATE	02/20/2026
DESCRIPTION	DATE
ADDENDUM 01	03-02-2026

DRAWN BY	JJR
CHECKED BY	JCL
PROJECT NO.	9166-10000
SHEET NAME	

MECHANICAL PIPING & CONTROLS PLAN - AREA B

M-111B

NOT FOR CONSTRUCTION

GENERAL MECHANICAL NOTES:

1. VERIFY ALL SITE CONDITIONS PRIOR TO STARTING WORK.
2. COORDINATE ALL DUCTWORK AND PIPE ROUTING WITH BUILDING STRUCTURE AND OTHER TRADES PRIOR TO INSTALLATION TO ALLOW FOR PROPER CLEARANCE SPACE.
3. MAINTAIN SERVICE CLEARANCE REQUIREMENTS AROUND ALL MECHANICAL EQUIPMENT AND ELECTRICAL EQUIPMENT. DO NOT ROUTE PIPING OR DUCTWORK IN CLEARANCE SPACE.
4. M.C. COORDINATE REFRIGERANT LINE ROUTING FROM CONDENSING UNITS TO THE RESPECTIVE UNITS.
5. MANUAL VOLUME DAMPERS SHALL BE PROVIDED ON ALL SUPPLY, RETURN, AND EXHAUST BRANCH DUCTS.
6. M.C. SHALL COORDINATE ANY AREA WHERE ACCESS TO EQUIPMENT OR HVAC COMPONENTS ARE REQUIRED TO ALLOW ACCESS FOR MAINTENANCE, OR INSPECTION WITH G.C.

MIDDLE SCHOOL HVAC UPGRADE

1059 3RD AVE NW, WAUKON, IA 52172
ALLAMAKEE CSD

ISSUED FOR



BIDDING

DATE	DESCRIPTION	DATE
02/20/2026		
03-02-2026	ADDENDUM 01	

DRAWN BY	JJR
CHECKED BY	JCL
PROJECT NO.	9166-10000
SHEET NAME	

MECHANICAL
PIPING &
CONTROLS PLAN -
AREA D

M-111D

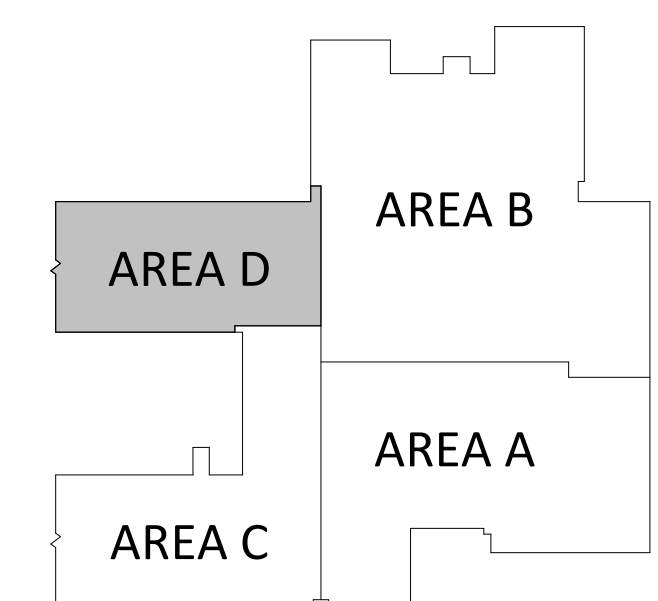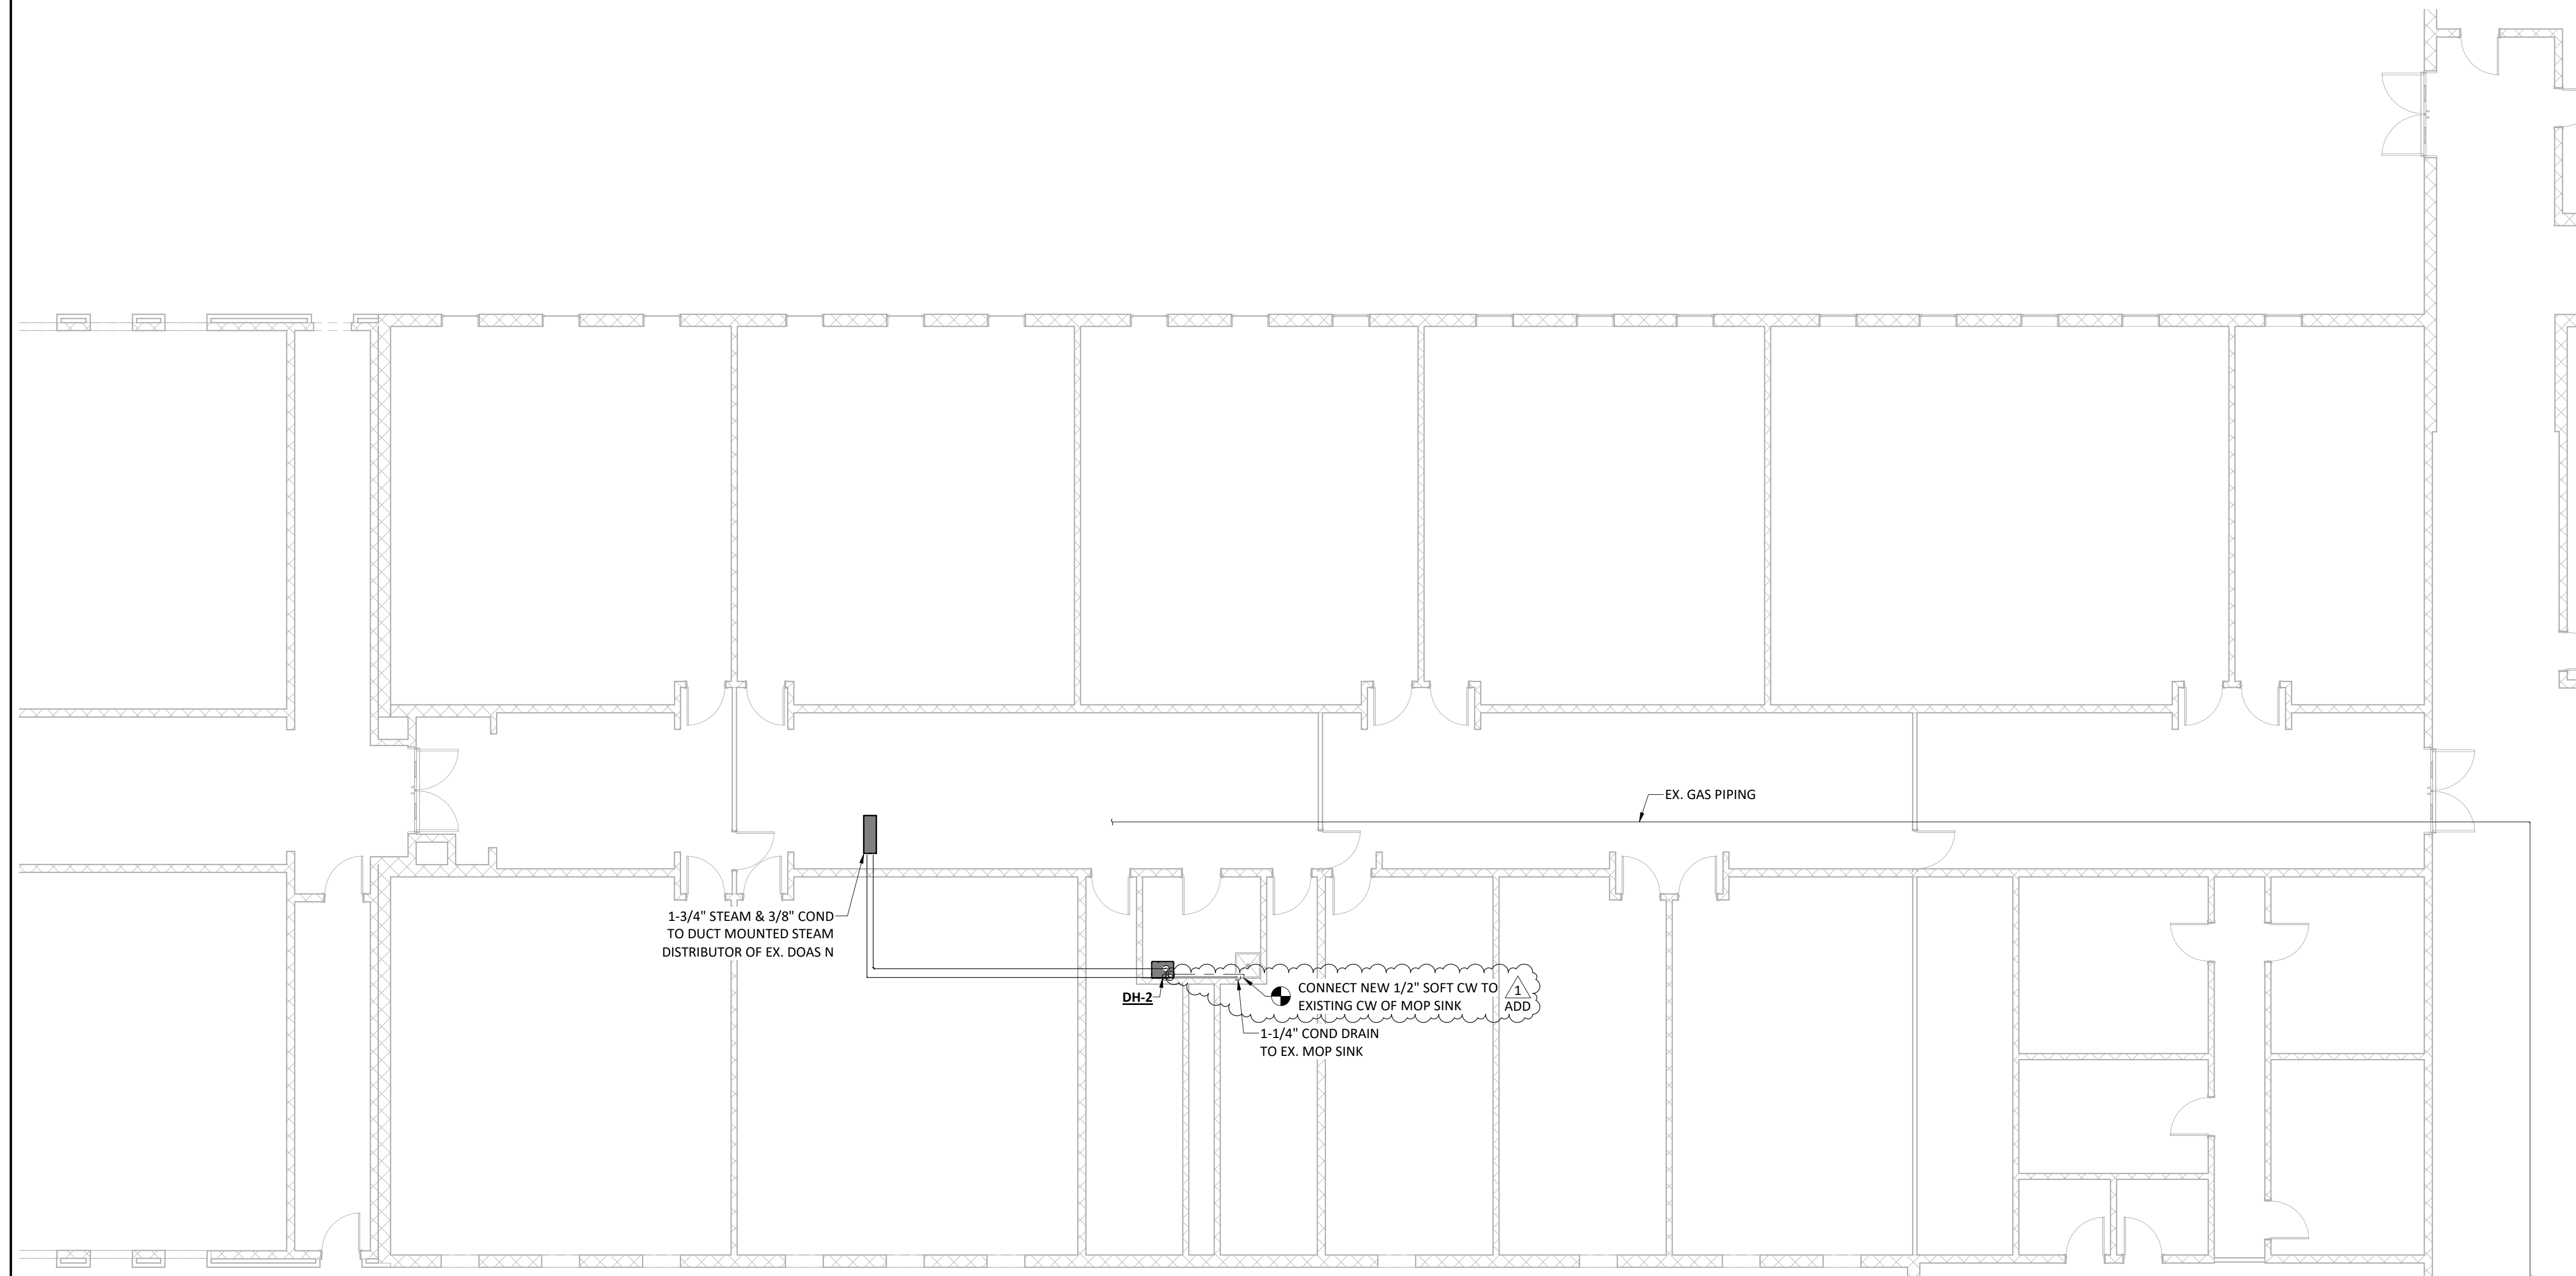

**MIDDLE SCHOOL
BUILDING KEY PLAN**

MECHANICAL PIPING & CONTROLS PLAN - AREA D
1/8" = 1'-0"

NOT FOR CONSTRUCTION

DATE	02/20/2026
DESCRIPTION	DATE
ADDENDUM 01	03-02-2026

DRAWN BY	JJR
CHECKED BY	JCL
PROJECT NO.	9166-10000

SHEET NAME
MECHANICAL SCHEDULES

M-601

NOT FOR CONSTRUCTION

VARIABLE AIR VOLUME TERMINALS SCHEDULE															
PLAN MARK	MAX. COOLING AIRFLOW (CFM)	INLET SIZE (INCH Ø)	STATIC PRESSURE (IN. W.G.) (1)	HEATING CONDITIONS		HEATING COIL DATA					NC RATING	MANUFACTURER MODEL	WEIGHT (LBS.)	NOTES	
				AIRFLOW (CFM)	APD (IN. W.G.)	ROWS	MBH	FLOW RATE (GPM)	WPD (FT. HD.)	EAT (°F)					LAT (°F)
VAV-1															ADD
VAV-2															
VAV-3A	3,500	16	0.75	2,600	0.45	2	98.3	5	1.1	61	90	(2)	TRANE SINGLE-DUCT HW VAV BOX MODEL VCVF16	94	ALL
VAV-3B	3,500	16	0.75	2,600	0.45	2	98.3	5	1.1	61	90	(2)	TRANE SINGLE-DUCT HW VAV BOX MODEL VCVF16	94	ALL
VAV-4	3,400	16	0.75	2,200	0.35	2	83.2	5	1.1	55	90	(2)	TRANE SINGLE-DUCT HW VAV BOX MODEL VCVF16	94	ALL
VAV-5	1,500	12	0.42	900	0.20	2	34.1	3.5	0.7	55	90	(2)	TRANE SINGLE-DUCT HW VAV BOX MODEL VCVF12	66	ALL
VAV-6	2,250	14	0.45	1,400	0.25	2	69.4	5	1.1	55	90	(2)	TRANE SINGLE-DUCT HW VAV BOX MODEL VCVF12	66	ALL
VAV-7	1,000	10	0.65	700	0.25	2	41.3	2.5	1.0	55.0	90.0	(2)	TRANE SINGLE-DUCT HW VAV BOX MODEL VCVF10	52	ALL
VAV-8	750	8	0.56	500	0.47	2	18.9	2.5	0.5	55	90	(2)	TRANE SINGLE-DUCT HW VAV BOX MODEL VCVF08	39	ALL
VAV-9	800	8	0.68	600	0.38	2	30.8	2.5	0.5	55	90	(2)	TRANE SINGLE-DUCT HW VAV BOX MODEL VCVF08	39	ALL
VAV-10	1,200	10	0.30	600	0.15	1	23.3	1.5	6.3	55	90	(2)	TRANE SINGLE-DUCT HW VAV BOX MODEL VCVF10	48	ALL
VAV-11	2,400	14	0.28	1,800	0.20	1	54.8	3.0	2.4	55	90	(2)	TRANE SINGLE-DUCT HW VAV BOX MODEL VCVF14	75	ALL
VAV-12	300	6	0.17	200	0.12	1	9.5	1.0	1.7	55	90	(2)	TRANE SINGLE-DUCT HW VAV BOX MODEL VCVF06	32	ALL

1. STATIC PRESSURE DROP AT LISTED AIRFLOW RATE THROUGH VAV BOX (DAMPER 100% OPEN).
2. NC RATING IS MAXIMUM DISCHARGE OR RADIATED RATING ALLOWED. NC RATINGS TO BE CALCULATED IN ACCORDANCE WITH AHRI-885.
3. PROVIDE VARIABLE VOLUME TERMINALS WITH SOUND ATTENUATION.
4. HEATING COIL SHALL BE INSTALLED UPSTREAM OF SOUND ATTENUATOR.

ADD

ADD

MINI-SPLIT MULTI-ZONE HEAT PUMP SCHEDULE																	
PLAN MARK	AREA SERVED / CONNECTED SYSTEM (INDOOR/OUTDOOR UNIT)	AIRFLOW (CFM)	COOLING CAPACITY (MBH)	REFRIGERANT TYPE	SEER2 / HSPF	HEATING CAPACITY @ 47°F (MBH)	HEATING CAPACITY @ -13°F (MBH)	ELECTRICAL			DIMENSIONS (INCH)			REFRIG (LBS. OZ)	WEIGHT (LBS.)	MANUFACTURER MODEL	NOTES
								AMP (MCA)	VOLTAGE	Ø	WIDTH	DEPTH	HEIGHT				
UNIT VENTILATOR (INDOOR UNIT)																	
UV-1	SUPERINTENDENT OFFICE (M100C) / CU-1	530	12	(4)	--	14	--	1	208	1	33	33	10	--	46	TRANE CEILING CASSETTE UNIT MODEL PLA-AE12NL	1, 2, 3
UV-2	PRINCIPAL OFFICE (M102B) / CU-1	300	9	(4)	--	11	--	1	208	1	23	23	9	--	31	TRANE CEILING CASSETTE UNIT MODEL SLZ-AF09NL	1, 2, 3
UV-3	BUSINESS MGR OFFICE (M100B) / CU-1	300	9	(4)	--	11	--	1	208	1	23	23	9	--	31	TRANE CEILING CASSETTE UNIT MODEL SLZ-AF09NL	1, 2, 3
UV-4	OFFICE (M100A) / CU-1	300	9	(4)	--	11	--	1	208	1	23	23	9	--	31	TRANE CEILING CASSETTE UNIT MODEL SLZ-AF09NL	1, 2, 3
UV-5	CONF & BOARD ROOM (M100D) / CU-1	335	12	(4)	--	13.5	--	0.36	208	1	23	23	9	--	31	TRANE CEILING CASSETTE UNIT MODEL PLEY-L12NFMU-A	1, 2, 3
UV-6	DISTRICT OFFICE (M100) / CU-2	335	12	(4)	--	13.5	--	0.36	208	1	23	23	9	--	31	TRANE CEILING CASSETTE UNIT MODEL PLEY-L12NFMU-A	1, 2, 3
UV-7	DISTRICT OFFICE (M100) / CU-2	335	12	(4)	--	13.5	--	0.36	208	1	23	23	9	--	31	TRANE CEILING CASSETTE UNIT MODEL PLEY-L12NFMU-A	1, 2, 3
UV-8	FRONT OFFICE (M102) / CU-2	335	12	(4)	--	13.5	--	0.36	208	1	23	23	9	--	31	TRANE CEILING CASSETTE UNIT MODEL PLEY-L12NFMU-A	1, 2, 3
UV-9	KITCHEN OFFICE (M107C) / CU-3	335	12	(4)	--	13.5	--	0.36	208	1	23	23	9	--	31	TRANE CEILING CASSETTE UNIT MODEL PLEY-L12NFMU-A	1, 2, 3
UV-10	KITCHEN OFFICE (M107A) / CU-3	335	12	(4)	--	13.5	--	0.36	208	1	23	23	9	--	31	TRANE CEILING CASSETTE UNIT MODEL PLEY-L12NFMU-A	1, 2, 3
UV-11	TEACHER WORKROOM / CU-4	600	18	(4)	--	19	--	1	208	1	33	33	10	--	46	TRANE CEILING CASSETTE UNIT MODEL PLA-AE12NL	1, 2, 3
UV-12	GUIDANCE / CU-2	335	12	(4)	--	13.5	--	0.36	208	1	23	23	9	--	31	TRANE CEILING CASSETTE UNIT MODEL PLEY-L12NFMU-A	1, 2, 3
UV-13	CONFERENCE / CU-4	300	9	(4)	--	11	--	1	208	1	23	23	9	--	31	TRANE CEILING CASSETTE UNIT MODEL SLZ-AF09NL	1, 2, 3
UV-14	HEALTH / CU-4	300	9	(4)	--	11	--	1	208	1	23	23	9	--	31	TRANE CEILING CASSETTE UNIT MODEL SLZ-AF09NL	1, 2, 3
UV-15	NURSE / CU-4	300	9	(4)	--	11	--	1	208	1	23	23	9	--	31	TRANE CEILING CASSETTE UNIT MODEL SLZ-AF09NL	1, 2, 3
UV-16	CONCESSION / CU-4	300	9	(4)	--	11	--	1	208	1	23	23	9	--	31	TRANE CEILING CASSETTE UNIT MODEL SLZ-AF09NL	1, 2, 3
HEAT PUMP (OUTDOOR UNIT)																	
CU-1	ADMIN PERIMETER OFFICES / UV-1 THRU UV-5	--	60	R454B (4)	20/10.5	65	30	55	208	1	42	13	53	6, 10	280	TRANE AIR-COOLED HEAT PUMP MODEL MXZ-SM6GNL	3, 5, 6, 7, 8, 9, 10
CU-2	ADMIN INTERIOR OFFICES / UV-6 THRU UV-8, UV-12	--	60	R454B (4)	20/10.5	65	30	55	208	1	42	13	53	6, 10	280	TRANE AIR-COOLED HEAT PUMP MODEL MXZ-SM6GNL	3, 5, 7, 8, 9, 10
CU-3	KITCHEN OFFICES / UV-9 AND UV-10	--	36	R454B (4)	23/12	42	42	55	208	1	42	13	53	6, 10	280	TRANE AIR-COOLED HEAT PUMP MODEL MXZ-SM36NLHZ	3, 5, 7, 8, 9, 10
CU-4	ADMIN INTERIOR OFFICES / UV-11 AND UV-16 (NO UV-12)	--	60	R454B (4)	20/10.5	65	30	55	208	1	42	13	53	6, 10	280	TRANE AIR-COOLED HEAT PUMP MODEL MXZ-SM6GNL	3, 5, 6, 7, 8, 9, 10

1. PROVIDE UNIT VENTILATORS WITH BUILT-IN CONDENSATE LIFT MECHANISM. ROUTE CONDENSATE TO NEAREST ACCEPTABLE DRAIN LOCATION, OR TERMINATE ON EXTERIOR OF BUILDING. DIVISION 16 CONTRACTOR SHALL WIRE THE CONDENSATE LIFT PIPING.
2. PROVIDE CONTROLLER MODEL PAR-42MAAUB WHICH PROVIDES REFRIGERANT LEAK ALARMS. BUILDING AUTOMATION CONTRACTOR SHALL PROVIDE COMBINATION HUMIDITY AND CO2 SENSOR.
3. REFRIGERANT LINESETS SHALL BE ROUTED IN MOST EFFICIENT PATH AND MINIMAL REFRIGERANT PIPE SHALL BE EXPOSED. ALL REFRIGERANT LINESETS SHALL BE INSULATED PER ENERGY CODE REQUIREMENTS. PRE-INSULATED LINESETS ARE ACCEPTABLE.
4. MINI-SPLIT MANUFACTURER SHALL PROVIDE REFRIGERANT TYPE THAT MEETS ALL NEW FEDERAL REQUIREMENTS. REFER TO INTERNATIONAL MECHANICAL CODE, CHAPTER 11 REFRIGERANTS FOR MAXIMUM ALLOWABLE QUANTITY FOR SUBMITTED REFRIGERANT.
5. REFER TO SUBMITTED MANUFACTURER PIPING LENGTH AND ROUTING RESTRICTIONS.
6. PROVIDE WITH 5 PORT BRANCH BOX, MODEL PAC-LMA50BC. BRANCH BOX SHALL BE POWERED THROUGH THE ASSOCIATED HEAT PUMP (OUTDOOR UNIT). ELECTRICAL REQUIREMENTS: 208V, 1-PHASE, 0.003 kW INPUT, 0.15 AMP RUNNING CURRENT.
7. PROVIDE HAIL GUARD.
8. PROVIDE WIND BAFFLE.
9. PROVIDE WALL BRACKET FOR INSTALLATION, MINIMUM 18" ABOVE GRADE.
10. PROVIDE LINE-HIDE COVER ON ALL PIPING EXPOSED ON THE EXTERIOR WALL OF THE BUILDING PRIOR TO PENETRATING INTO INTERIOR SPACE.

DEDICATED OUTSIDE AIR SYSTEM (DOAS) SCHEDULE																																									
PLAN MARK	SUPPLY FAN(S)				EXHAUST FAN(S)				COOLING CAPACITY			SUMMER ENERGY RECOVERY				ELECTRIC PRE-HEAT		GAS HEATING		WINTER DESIGN ENERGY RECOVERY				HEAT EXCHANGER MATERIAL	FUEL - NATURAL GAS			ELECTRICAL			WEIGHT (LBS.)	MANUFACTURER MODEL NO.	NOTES								
	DESIGN AIRFLOW	ESP / TSP	DRIVE TYPE	MOTOR QTY HP	DESIGN AIRFLOW	ESP / TSP	DRIVE TYPE	MOTOR QTY HP	TOTAL (MBH)	SENSIBLE (MBH)	LATENT (MBH)	OUTSIDE AIR (°F) EAT (DB) EAT (WB) LAT (DB) LAT (WB)	FRESH AIR (°F) EAT (DB) EAT (WB) LAT (DB) LAT (WB)	REFRIGERANT	CAPACITY (KW)	EAT / LAT (DB°F)	INPUT (MBH)	OUTPUT (MBH)	OUTSIDE AIR (°F) EAT (DB) EAT (WB) LAT (DB) LAT (WB)	FRESH AIR (°F) EAT (DB) EAT (WB) LAT (DB) LAT (WB)	LAT (°F)	AFUE	GAS SIZE (Ø)		MIN.-MAX. INLET PRESSURE	LENGTH	WIDTH	HEIGHT (NOTE 16)	AMPS	VOLTAGE				Ø							
DOAS-1	13,500	1.7 / 3.4	DIRECT/VFD	1 10	3,000	1.0 / 1.7	DIRECT/VFD	1 3	562	371	191	95 78 80 68	R454B	20	-10 / 11	600	486	11 -- 46 41	97	STAINLESS STEEL	81%	1"	7"-14" W.C.	338	278	108	268	208	3	10,400	TRANE HORIZON DOAS MODEL OAN6055C1	ALL									
DOAS-2	7,000	1.0 / 3.35	DIRECT/VFD	1 10	2,000	1.2 / 2.1	DIRECT/VFD	1 1.5	215	154	61	95 78 80 69	R454B	15	-10 / 13	400	324	13 -- 45 40	105	STAINLESS STEEL	81%	1"	7"-14" W.C.	213	100	62	109	208	3	4,392	TRANE HORIZON DOAS MODEL OADG020C1	ALL									
DOAS-3	3,000	1.4 / 3.0	DIRECT/VFD	1 3	3,000	1.2 / 2.4	DIRECT/VFD	1 2	203	108	95	95 78 80 69	R454B	20	-10 / 11	200	160	11 NA NA NA	101	STAINLESS STEEL	81%	1"	7"-14" W.C.	183	95	68	108	208	3	4,223	TRANE HORIZON DOAS OADG020C1	1,2,3,4,5,6,7,8,9, 10,13,14,15,16									
DOAS-4	ALTERNATE 3 - REFER TO MECHANICAL SCHEDULES M-603								ALTERNATE 3 - REFER TO MECHANICAL SCHEDULES M-603								ALTERNATE 3 - REFER TO MECHANICAL SCHEDULES M-603																								
DOAS-5	3,400	0.5 / -	DIRECT/VFD	1 3	2,890	N/A	N/A	N/A	N/A	139	94	45	85 78 N/A N/A	R454B	N/A	N/A	173	140	-10 NA NA NA	90	STAINLESS STEEL	81%	3/4"	7"-14" W.C.	108	81	61	62	208	3	2,036	ECON-AIR RTU MODEL EARTU2-1.200-18-10T	1,2,3,4,5,6,7,8,9, 10,13,14,15,16								
DOAS-6	1,200	1.7 / 2.46	DIRECT/VFD	1 1	650	1.2 / 1.72	DIRECT/VFD	1 2	45	30	15	95 78 80 68	R454B	5.0	-10 / 7	75	60	7 4 54 46	92	STAINLESS STEEL	81%	3/4"	7"-14" W.C.	161	52	55	34	208	3	1,964	TRANE HORIZON DOAS MODEL OABDQ48A3-C1	ALL									
MAU-1	REFER TO MECHANICAL SCHEDULES M-604								REFER TO MECHANICAL SCHEDULES M-604								REFER TO MECHANICAL SCHEDULES M-604																								

1. SUPPLY FAN AND EXHAUST FAN MOTORS SHALL BE DIRECT-DRIVE WITH FACTORY INSTALLED VARIABLE FREQUENCY DRIVES.
2. UNITS SHALL BE MULTI-ZONE VAV CONTROLS.
3. PROVIDE THE FOLLOWING MOTORIZED CONTROL DAMPERS: OUTSIDE AIR, EXHAUST AIR, ENERGY RECOVERY WHEEL BYPASS, AND RECIRCULATION AIRSTREAMS.
4. DIRECT EXPANSION (DX) COOLING COIL: SHALL BE TYPE 6-ROW.
5. PROVIDE UNITS WITH MODULATING HOT GAS REHEAT (HGRH) COIL DOWNSTREAM OF DX COOLING COIL TO PROVIDE DEHUMIDIFICATION.
6. PROVIDE UNITS WITH FACTORY MOUNTED AND WIRED UV LIGHTS BETWEEN EVAPORATOR COIL AND THE HGRH COIL.
7. PROVIDE 2-INCH MERV8 PRE-FILTER UPSTREAM OF THE ENERGY RECOVERY WHEEL.
8. PROVIDE 2-INCH MERV13 PRIMARY FILTER UPSTREAM OF DX COOLING COIL DOWNSTREAM OF THE RECIRCULATING MODULATING DAMPER.
9. COMPRESSORS SHALL BE DIGITAL-SCROLL, MINIMUM OF 2 CIRCUITS.
10. PRIMARY HEATING SECTION SHALL BE INDIRECT-FIRED GAS BURNER AND SHALL BE STAINLESS STEEL, INDUCED DRAFT COMBUSTION AND USE A DIRECT SPARK IGNITION SYSTEM.
11. SECONDARY HEATING SHALL BE STAGED ELECTRIC HEATING COIL UPSTREAM OF THE ENERGY RECOVERY WHEEL ON THE OUTSIDE AIRSTREAM. CONTROL SHALL BE ON/OFF.
12. ENERGY RECOVERY SECTION SHALL BE A TOTAL ENERGY RECOVERY WHEEL WITH FROST PROTECTION AND VARIABLE FREQUENCY DRIVE.
13. PROVIDE FACTORY MOUNT NON-FUSED DISCONNECT.
14. PROVIDE POWERED CONVENIENCE OUTLET.
15. PROVIDE UNITS WITH HAIL GUARDS ON THE CONDENSER COIL.
16. PROVIDE UNITS WITH ROOF CURB. CURB SHALL MAINTAIN MINIMUM 18" CLEAR ABOVE ROOF AND INSULATION FINISHED ELEVATION.

NOT FOR CONSTRUCTION

AIRFLOW MATRIX												
ROOM NAME	ROOM #	AREA (FT ²)	SUPPLY	RETURN	MIN. VENTILATION RATES				ZONE DISTRIBUTION EFFECTIVENESS (Ez)	IMC CALCULATED VENTILATION (CFM)	TOTAL EXHAUST (CFM)	SYSTEM
					OCCUPANCY	CFM/PERSON	CFM/FT ²	EXHAUST				
AG CLASSROOM	167	882 SF	1500 CFM	1500 CFM	30	10.0 CFM	0.12 CFM	0 CFM	0.8	507 CFM	0 CFM	DOAS-1
ART	153A	1225 SF	2000 CFM	2000 CFM	20	10.0 CFM	0.12 CFM	0 CFM	0.8	434 CFM	0 CFM	DOAS-1
ART OFFICE	152	81 SF	100 CFM	0 CFM	2	5.0 CFM	0.06 CFM	0 CFM	0.8	19 CFM	100 CFM	DOAS-1
ART STORAGE	151	118 SF	150 CFM	0 CFM	0	0.0 CFM	0.06 CFM	0 CFM	0.8	9 CFM	150 CFM	DOAS-1
ART STORAGE	150	119 SF	150 CFM	0 CFM	0	0.0 CFM	0.06 CFM	0 CFM	0.8	9 CFM	150 CFM	DOAS-1
CLOSET 1		33 SF	50 CFM	0 CFM	0	0.0 CFM	0.00 CFM	0 CFM	0.8	0 CFM	0 CFM	DOAS-1
CLOSET 2		33 SF	50 CFM	0 CFM	0	0.0 CFM	0.00 CFM	0 CFM	0.8	0 CFM	0 CFM	DOAS-1
CORRIDOR	159	1507 SF	800 CFM	800 CFM	0	0.0 CFM	0.06 CFM	0 CFM	0.8	113 CFM	0 CFM	DOAS-1
DRY ART ROOM	153B	587 SF	1000 CFM	1000 CFM	10	10.0 CFM	0.12 CFM	0 CFM	0.8	213 CFM	0 CFM	DOAS-1
DUST COLLECTION	157C	158 SF	50 CFM	0 CFM	0	0.0 CFM	0.06 CFM	0 CFM	0.8	12 CFM	50 CFM	DOAS-1
INDUSTRIAL CLASSROOM	154	1132 SF	2000 CFM	2000 CFM	25	10.0 CFM	0.12 CFM	0 CFM	0.8	482 CFM	0 CFM	DOAS-1
INDUSTRIAL OFFICE	156	80 SF	100 CFM	100 CFM	2	5.0 CFM	0.06 CFM	0 CFM	0.8	19 CFM	0 CFM	DOAS-1
INDUSTRIAL STORAGE	155	144 SF	150 CFM	150 CFM	0	0.0 CFM	0.06 CFM	0 CFM	0.8	11 CFM	0 CFM	DOAS-1
JAN.	146	332 SF	300 CFM	0 CFM	0	0.0 CFM	0.06 CFM	0 CFM	0.8	25 CFM	0 CFM	DOAS-1
KILN	153C	119 SF	0 CFM	0 CFM	0	0.0 CFM	0.06 CFM	0 CFM	0.8	9 CFM	800 CFM	DOAS-1
OFFICE	157B	77 SF	250 CFM	0 CFM	0	0.0 CFM	0.06 CFM	0 CFM	0.8	6 CFM	0 CFM	DOAS-1
OFFICE	166	137 SF	150 CFM	150 CFM	2	5.0 CFM	0.06 CFM	0 CFM	0.8	23 CFM	0 CFM	DOAS-1
OFFICE	165	135 SF	150 CFM	150 CFM	2	5.0 CFM	0.06 CFM	0 CFM	0.8	23 CFM	0 CFM	DOAS-1
SHOP CLASSROOM	161B	511 SF	800 CFM	800 CFM	20	10.0 CFM	0.12 CFM	0 CFM	0.8	327 CFM	0 CFM	DOAS-1
STORAGE ROOM 1		236 SF	150 CFM	150 CFM	0	0.0 CFM	0.06 CFM	0 CFM	0.8	18 CFM	0 CFM	DOAS-1
STORAGE ROOM 2		81 SF	100 CFM	0 CFM	0	0.0 CFM	0.06 CFM	0 CFM	0.8	6 CFM	0 CFM	DOAS-1
TECH LAB	161A	753 SF	1200 CFM	1200 CFM	20	10.0 CFM	0.12 CFM	0 CFM	0.8	363 CFM	0 CFM	DOAS-1
WOOD SHOP	157A	1892 SF	3400 CFM	0 CFM	20	10.0 CFM	0.12 CFM	0 CFM	0.8	534 CFM	3400 CFM	DOAS-1
CAFETERIA / STUDY HALL	170	3134 SF	7000 CFM	7000 CFM	130	7.5 CFM	0.18 CFM	0 CFM	0.8	1924 CFM	0 CFM	DOAS-2
OFFICE	176	148 SF	100 CFM	100 CFM	1	5.0 CFM	0.06 CFM	0 CFM	0.8	17 CFM	70 CFM	DOAS-3
BOYS LOCKER ROOM	177	705 SF	1275 CFM	1000 CFM	0	0.0 CFM	0.00 CFM	450 CFM	0.8	0 CFM	450 CFM	DOAS-3
COACH	184	100 SF	100 CFM	100 CFM	2	5.0 CFM	0.06 CFM	0 CFM	0.8	20 CFM	0 CFM	DOAS-3
GIRLS LOCKER ROOM	182	593 SF	1275 CFM	1000 CFM	0	0.0 CFM	0.00 CFM	375 CFM	0.8	0 CFM	375 CFM	DOAS-3
M SHOWER	179	145 SF	0 CFM	275 CFM	0	0.0 CFM	0.00 CFM	200 CFM	0.8	0 CFM	250 CFM	DOAS-3
PASS	173	53 SF	50 CFM	50 CFM	0	0.0 CFM	0.00 CFM	0 CFM	0.8	0 CFM	0 CFM	DOAS-3
PASS	183	50 SF	50 CFM	50 CFM	0	0.0 CFM	0.00 CFM	0 CFM	0.8	0 CFM	0 CFM	DOAS-3
STORAGE	181	35 SF	0 CFM	50 CFM	0	0.0 CFM	0.06 CFM	0 CFM	0.8	3 CFM	0 CFM	DOAS-3
STORAGE	178	99 SF	0 CFM	50 CFM	0	0.0 CFM	0.06 CFM	0 CFM	0.8	7 CFM	0 CFM	DOAS-3
TOILET	174	40 SF	50 CFM	50 CFM	0	0.0 CFM	0.00 CFM	70 CFM	0.8	0 CFM	70 CFM	DOAS-3
TOILET	185	48 SF	100 CFM	100 CFM	0	0.0 CFM	0.00 CFM	70 CFM	0.8	0 CFM	70 CFM	DOAS-3
W SHOWER	180	145 SF	0 CFM	275 CFM	0	0.0 CFM	0.00 CFM	200 CFM	0.8	0 CFM	250 CFM	DOAS-3
A/V	308	210 SF	200 CFM	200 CFM	5	5.0 CFM	0.06 CFM	0 CFM	0.8	47 CFM	0 CFM	DOAS-4
AUDITORIUM	307	4438 SF	5400 CFM	7000 CFM	400	5.0 CFM	0.06 CFM	0 CFM	0.8	2833 CFM	0 CFM	DOAS-4
STAGE	144	1740 SF	1600 CFM	0 CFM	30	10.0 CFM	0.06 CFM	0 CFM	0.8	506 CFM	0 CFM	DOAS-4
BUSINESS MANAGER	209	159 SF	100 CFM	100 CFM	2	5.0 CFM	0.06 CFM	0 CFM	0.8	15 CFM	0 CFM	DOAS-6
CONCESSION	187	97 SF	150 CFM	150 CFM	2	5.0 CFM	0.06 CFM	0 CFM	0.8	20 CFM	0 CFM	DOAS-6
CONF	212	70 SF	100 CFM	100 CFM	1	5.0 CFM	0.06 CFM	0 CFM	0.8	12 CFM	0 CFM	DOAS-6
CONFERENCE	198	170 SF	300 CFM	300 CFM	10	5.0 CFM	0.06 CFM	0 CFM	0.8	75 CFM	0 CFM	DOAS-6
CONFERENCE / BOARD ROOM	207	268 SF	400 CFM	400 CFM	8	5.0 CFM	0.06 CFM	0 CFM	0.8	70 CFM	0 CFM	DOAS-6
DISTRICT OFFICE	211	451 SF	400 CFM	400 CFM	4	5.0 CFM	0.06 CFM	0 CFM	0.8	59 CFM	0 CFM	DOAS-6
FRONT OFFICE	205	318 SF	250 CFM	250 CFM	4	5.0 CFM	0.06 CFM	0 CFM	0.8	49 CFM	0 CFM	DOAS-6
GUIDANCE	197	170 SF	200 CFM	200 CFM	2	5.0 CFM	0.06 CFM	0 CFM	0.8	25 CFM	0 CFM	DOAS-6
HEALTH	191	142 SF	200 CFM	200 CFM	2	5.0 CFM	0.06 CFM	0 CFM	0.8	23 CFM	0 CFM	DOAS-6
NURSE	190	120 SF	150 CFM	150 CFM	2	5.0 CFM	0.06 CFM	0 CFM	0.8	22 CFM	0 CFM	DOAS-6
OFFICE	210	124 SF	150 CFM	150 CFM	2	5.0 CFM	0.06 CFM	0 CFM	0.8	22 CFM	0 CFM	DOAS-6
PRINCIPAL	206	193 SF	200 CFM	200 CFM	2	5.0 CFM	0.06 CFM	0 CFM	0.8	27 CFM	0 CFM	DOAS-6
RECORDS	199	86 SF	50 CFM	50 CFM	0	0.0 CFM	0.06 CFM	0 CFM	0.8	6 CFM	0 CFM	DOAS-6
STORAGE	213	65 SF	100 CFM	100 CFM	0	0.0 CFM	0.06 CFM	0 CFM	0.8	5 CFM	0 CFM	DOAS-6
STORAGE	204	86 SF	50 CFM	50 CFM	0	0.0 CFM	0.06 CFM	0 CFM	0.8	6 CFM	0 CFM	DOAS-6
SUPERINTENDENT OFFICE	208	247 SF	250 CFM	250 CFM	2	5.0 CFM	0.06 CFM	0 CFM	0.8	31 CFM	0 CFM	DOAS-6
TEACHER WORKROOM	195	389 SF	815 CFM	815 CFM	20	5.0 CFM	0.12 CFM	0 CFM	0.8	180 CFM	0 CFM	DOAS-6
TOILET	188	97 SF	150 CFM	0 CFM	0	0.0 CFM	0.00 CFM	210 CFM	0.8	0 CFM	210 CFM	DOAS-6
TOILET	189	124 SF	200 CFM	0 CFM	0	0.0 CFM	0.00 CFM	280 CFM	0.8	0 CFM	280 CFM	DOAS-6
TOILET	192	85 SF	50 CFM	0 CFM	0	0.0 CFM	0.00 CFM	70 CFM	0.8	0 CFM	70 CFM	DOAS-6
TOILET	201	41 SF	50 CFM	0 CFM	0	0.0 CFM	0.00 CFM	70 CFM	0.8	0 CFM	70 CFM	DOAS-6
TOILET	202	41 SF	50 CFM	0 CFM	0	0.0 CFM	0.00 CFM	70 CFM	0.8	0 CFM	70 CFM	DOAS-6
JAN.	203	60 SF	0 CFM	0 CFM	0	0.0 CFM	0.06 CFM	0 CFM	0.8	5 CFM	70 CFM	EF-1
DRY STORAGE	158D	573 SF	400 CFM	400 CFM	0	0.0 CFM	0.06 CFM	0 CFM	0.8	43 CFM	0 CFM	MAU-1
KITCHEN	169	1839 SF	3400 CFM	3400 CFM	10	7.5 CFM	0.12 CFM	1290 CFM	0.8	370 CFM	3470 CFM	MAU-1
KITCHEN HALLWAY	169A	353 SF	300 CFM	300 CFM	0	0.0 CFM	0.06 CFM	0 CFM	0.8	26 CFM	0 CFM	MAU-1
OFFICE	158C	110 SF	100 CFM	100 CFM	0	0.0 CFM	0.06 CFM	0 CFM	0.8	8 CFM	0 CFM	MAU-1
OFFICE	158A	98 SF	100 CFM	100 CFM	2	5.0 CFM	0.06 CFM	0 CFM	0.8	20 CFM	0 CFM	MAU-1
TOILET	158B	51 SF	50 CFM	0 CFM	0	0.0 CFM	0.00 CFM	70 CFM	0.8	0 CFM	70 CFM	MAU-1
TOILET	162	66 SF	50 CFM	0 CFM	0	0.0 CFM	0.00 CFM	70 CFM	0.8	0 CFM	70 CFM	RTU-1
TOILET	163	68 SF	50 CFM	0 CFM	0	0.0 CFM	0.00 CFM	70 CFM	0.8	0 CFM	70 CFM	RTU-1

GRAVITY ROOF INTAKE VENTILATOR SCHEDULE								
PLAN MARK	AIRFLOW (CFM)	EXTERNAL STATIC PRESSURE	APPLICATION	MOUNTING	DUCT CONNECTION SIZE (W" X D")	OVERALL HOOD SIZE (W" X L" X H")	MANUFACTURER MODEL	NOTES
GRI-1	400	0.13	INTAKE	ROOF	10" X 10"	18.75" X 18.75" X 10.25"	LOREN COOK GRAVITY INTAKE VENTILATOR 8 PR	ALL

1. INSTALL INTAKE VENTILATOR, **GRI-1** ON MANUFACTURER'S PROVIDED CURB CAP.

RADIANT HEATING PANEL SCHEDULE															
PLAN MARK	HEATING PERFORMANCE (BTUH / LF)	HW SUPPLY SIZE	FLOWRATE (GPM)	WATER PD / 100 FT OF 0.505 ID TUBE (FT HEAD)	MEAN WATER TEMP MWT (°F)	ΔT °F	NUMBER OF PASSES	DIMENSIONS (INCH)				MOUNTING / INSTALLATION	AREA SERVED	MANUFACTURER MODEL	NOTES
								LENGTH	WIDTH	THICKNESS	TUBE ID				
RP-1	430	3/4"	2.05	12.9	180	20	4	48	24	0.08	0.505	LAY-IN 2X4 ACT CEILING	REFER TO PLANS	AERO TECH RADIANT LINEAR EXTRUDED PANELS - MODEL AXO	ALL

- HEATING PERFORMANCE BASED ON PERIMETER RADIANT PANELS.
- PROVIDE WALL-MOUNTED THERMOSTATS, SEE PLANS FOR LOCATIONS AND PAIRING.
- REFER TO MANUFACTURER'S RECOMMENDATIONS FOR INSTALLATION REQUIREMENTS IN ARCHITECT'S CEILING TYPE.

VIBRATION ISOLATION SCHEDULE					
PLAN MARK	EQUIPMENT DESCRIPTION	BASE TYPE	ISOLATION TYPE	MINIMUM DEFLECTION	NOTES
DOAS	DEDICATED OUTSIDE AIR SYSTEM	A	3	2"	1, 2, 3
BP	INLINE CIRCULATING PUMPS	A	3	0.75"	1, 2
CONDENSER	CONDENSING UNITS	A	4	1.5"	1, 2

- SEE SPECIFICATION SECTION 15 240 FOR BASE TYPE AND ISOLATOR TYPE DESCRIPTIONS.
- TYPICAL FOR ALL UNITS OF THIS TYPE.
- FOR UNITS WITH FANS INTERNALLY ISOLATED WITH SPRING ISOLATORS, EXTERNAL ISOLATORS MAY BE OMITTED. INTERNAL FAN ISOLATION SHALL BE MINIMUM 2" DEFLECTION.
- PROVIDE ISOLATORS FOR THE FIRST THREE PIPE SUPPORTS.

CIRCULATING PUMP SCHEDULE										
PLAN MARK	FLOW RATE (GPM)	HEAD LOSS (FT. HEAD)	INLET SIZE (DIA.)	ELECTRICAL			MOUNT TYPE	MANUFACTURER / MODEL NO.	SYSTEM	NOTES
				HP	VOLTAGE	Ø				
BP-1	135.0	30.0	3"	1-1/2	208	3	IN-LINE	TACO CIRCULATING PUMP MODEL KV3006	BOILER CIRCULATOR	ALL
BP-2	135.0	30.0	3"	1-1/2	208	3	IN-LINE	TACO CIRCULATING PUMP MODEL KV3006	BOILER CIRCULATOR	ALL
BP-3	135.0	30.0	3"	1-1/2	208	3	IN-LINE	TACO CIRCULATING PUMP MODEL KV3006	BOILER CIRCULATOR	ALL

- BOILER PUMPS SHALL BE CAPABLE OF CIRCULATING 30% PROPYLENE GLYCOL / 70% WATER MIXTURE WORKING FLUID.
- PUMP SELECTIONS SHALL HAVE THE ABILITY FOR AT LEAST ONE (1) IMPELLER SIZE INCREASE.
- PUMPS SHALL BE PROVIDED WITH CHECK VALVE DOWN STREAM OF PUMP.

EXHAUST FAN SCHEDULE										
PLAN MARK	AIRFLOW (CFM)	STATIC PRESSURE	EXHAUST TYPE	ELECTRICAL			MOUNTING		MANUFACTURER MODEL	NOTES
				HP	AMPS	VOLTAGE	Ø			
EF-1	70	0.15	GENERAL	0.04	0.3	120	1	ROOF	LOREN COOK ROOF EXHAUST FAN MODEL 70C10DH	1 & 5
EF-2	3,400	0.20	INDUSTRIAL	1.25	11.0	208	1	ROOF	LOREN COOK ROOF INDUSTRIAL EF MODEL 225 VCRD-XP	2, 3, & 5
EF-3	180	0.15	GENERAL	0.06	0.4	120	1	CEILING	LOREN COOK CEILING EXHAUST FAN MODEL GC-148	1 & 5
KEF-1	1,010	0.73	TYPE I	0.5	6.3	115	1	ROOF	ECON-AIR ROOF KITCHEN EF MODEL EADU50H	4 & 5
KEF-2	1,010	0.73	TYPE I	0.5	6.3	115	1	ROOF	ECON-AIR ROOF KITCHEN EF MODEL EADU50H	4 & 5
KEF-3	1,05									

MIDDLE SCHOOL HVAC UPGRADE

1059 3RD AVE NW, WAUKON, IA 52172
ALLAMAKEE CSD

ISSUED FOR

BIDDING

DATE 02/20/2026

DESCRIPTION DATE

ADDENDUM 01 03-02-2026

DRAWN BY JCL

CHECKED BY JCL

PROJECT NO. 9166-10000

SHEET NAME

MECHANICAL SCHEDULES

M-604


DIRECT-FIRED MAKE-UP AIR UNIT SCHEDULE

PLAN MARK	SUPPLY FAN(S)					COOLING LOADS			COOLING AIR CONDITIONS		EFFICIENCY (IEER)	REFRIGERANT	HEATING		HEATING AIR CONDITIONS		FUEL - NATURAL GAS			HEAT EXCHANGER MATERIAL	MIN. EFFICIENCY	ELECTRICAL			DIMENSIONS (INCH)			WEIGHT (LBS.)	MANUFACTURER MODEL	NOTES	
	DESIGN AIRFLOW	ESP / TSP	DRIVE TYPE	MOTOR		SENSIBLE (MBH)	LATENT (MBH)	TOTAL (MBH)	EAT DB/WB	LAT DB/WB			INPUT (MBH)	OUTPUT (MBH)	EAT (DEG. F)	TEMP RISE (DEG. F)	AFUE	GAS SIZE (ø)	MIN.-MAX. INLET PRESSURE			HP	AMP	VOLTAGE	ø	LENGTH	WIDTH				HEIGHT
				QTY	HP																										
MAU-1	1800	0.5 / 0.6	DIRECT / VFD	1	1.5	--	--	--	--	--	--	160	148	-10	80	81%	1"	7"-14" W.C.	STAINLESS STEEL	81%	1.5	10	208	1	120	28	30	600	ECON-AIR MODEL A1-D.500-15D	1,2,3,5,6,7,8,9,10,11,12,13	
MAU-2	915	0.5 / 0.7	DIRECT / ECM	1	1	--	--	--	--	--	--	82	75	-10	80	81%	1"	7"-14" W.C.	STAINLESS STEEL	81%	1	6.9	208	1	84	22	22	400	ECON-AIR MODEL D76	1,2,4,5,6,7,8,9,10,11,12,13	
MAU-3	1800	0.5 / 0.6	DIRECT / VFD	1	1.5	--	--	--	--	--	--	162	149	-10	80	81%	1"	7"-14" W.C.	STAINLESS STEEL	81%	1.5	10	208	1	120	28	30	600	ECON-AIR MODEL A1-D.500-15D	1,2,3,5,6,7,8,9,10,11,12,13	

- NO COOLING PROVIDED IN KITCHEN HOOD MAKEUP AIR UNITS.
- ALL UNITS SHALL BE DOWN DISCHARGE.
- SUPPLY BLOWER TO BE PREMIUM EFFICIENCY, WITH MANUFACTURER PROVIDE VFD.
- SUPPLY BLOWER TO BE FORWARD CURVE CENTRIFUGAL BLOWER WITH ECM MOTOR.
- PROVIDE HI/LOW GAS PRESSURE SWITCHES.
- PROVIDE HIGH GAS PRESSURE REGULATOR.
- PROVIDE HIGH TEMPERATURE LIMIT SWITCH.
- PROVIDE METAL MESH FILTER ON INTAKE.
- PROVIDE WITH MOTORIZED INTAKE DAMPER THAT CLOSES WHEN KITCHEN HOOD IS NOT ENERGIZED.
- PROVIDE CLOGGED FILTER SWITCH.
- PROVIDE FACTORY WIRED 115V CONVENIENCE OUTLET, 5 MINUTE TDR OFF.
- PROVIDE UNIT MOUNTED DISCONNECT SWITCH.
- MOUNT ROOFTOP UNIT ON 18" ROOF CURB.



NOT FOR CONSTRUCTION

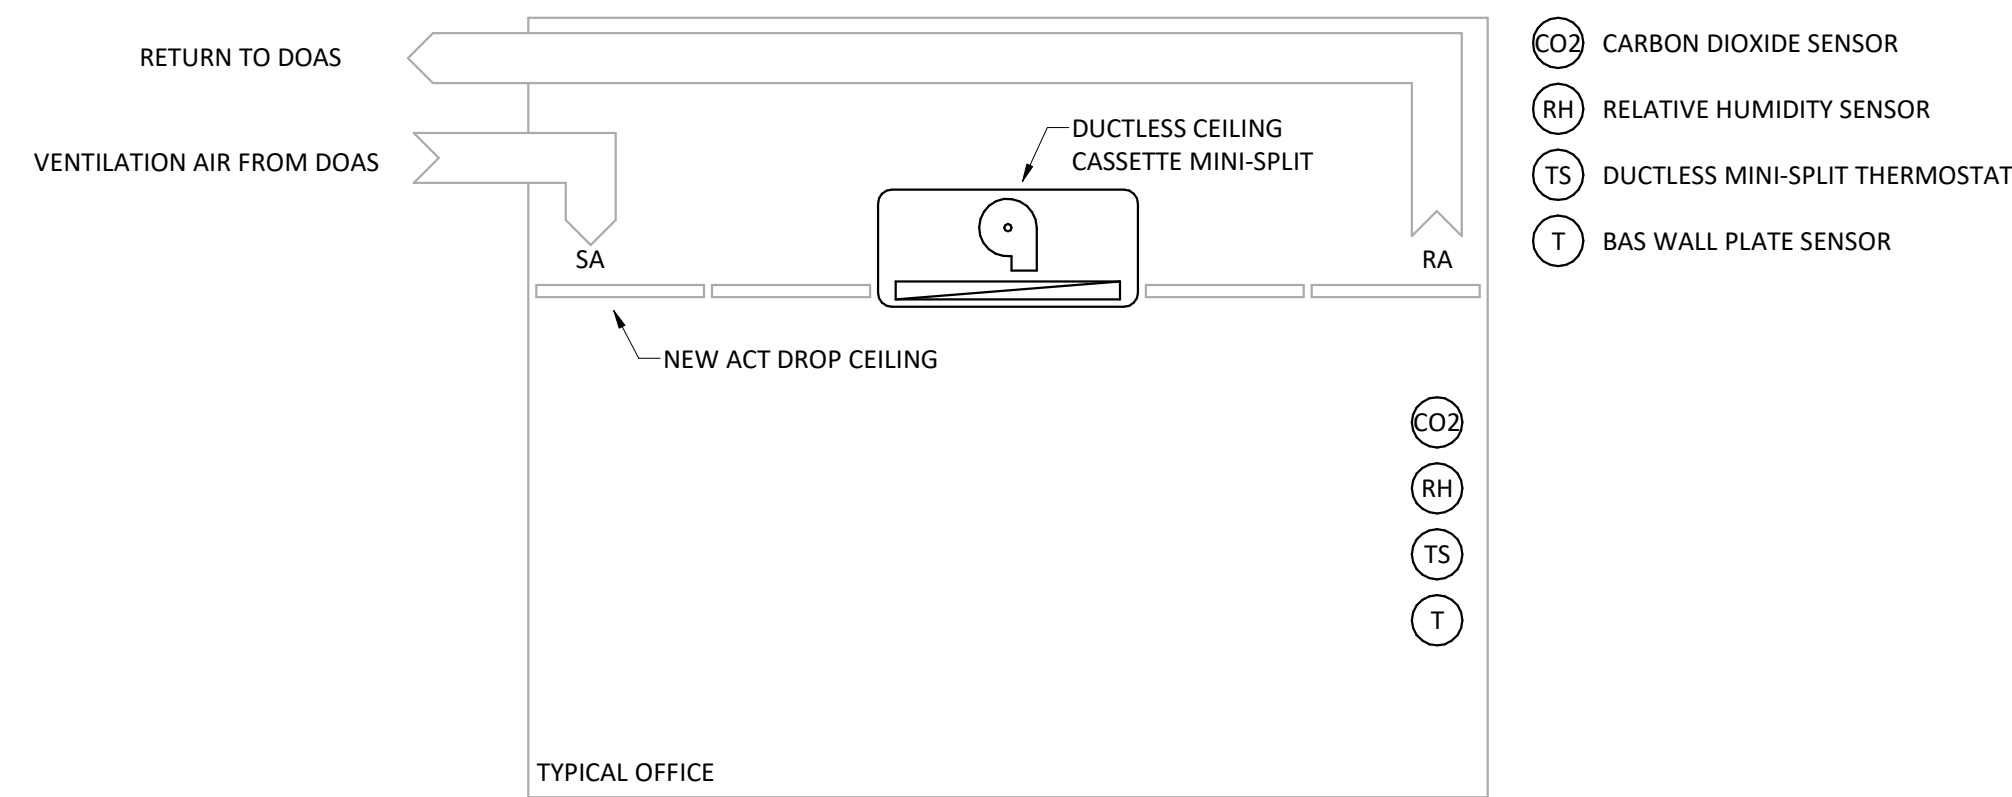


MULTI-ZONE MINI-SPLIT HEAT PUMP CONTROL SEQUENCE

NOT TO SCALE

SEQUENCE OF OPERATION

- EACH SPACE SHALL HAVE A 3-IN-1 TEMPERATURE, HUMIDITY, AND CO2 SENSOR.
- TERMINAL UNITS SHALL CONSIST OF A DUCTLESS MINI-SPLIT HEAT PUMP THAT CONTROLS TEMPERATURE.
- WHERE MULTIPLE INDOOR UNITS ARE CONNECTED TO A COMMON OUTDOOR UNIT, ALL INDOOR UNITS SHALL OPERATE IN EITHER HEATING MODE OR COOLING MODE TOGETHER. THE OUTDOOR UNIT SHALL SWITCH AL UNITS BETWEEN HEATING MODE AND COOLING MODE.
- EACH INDOOR UNIT VENTILATOR SHALL BE PROVIDED WITH AN EXPANSION VALVE TO CONTROL REFRIGERANT FLOW THROUGH THE INDOOR UNIT, AND A THERMOSTAT TO CONTROL HEATING OR COOLING OUTPUT.
- THE OUTDOOR UNIT SHALL SWITCH BETWEEN HEATING MODE AND COOLING MODE BASED ON ZONE TEMPERATURE OFFSET. IF THE SYSTEM IS IN COOLING MODE, AND THE SPACE TEMPERATURE FOR ANY OF THE CONNECTED ZONES FALLS BELOW SET POINT MINUS (-) 5F, THE SYSTEM SHALL SWITCH OVER TO HEATING MODE. CONVERSELY, IN THE HEATING MODE, IF ANY SPACE RISES ABOVE SET POINT PLUS (+) 5F, THE SYSTEM SHALL SWITCH INTO THE COOLING MODE.
- EACH UNIT SHALL BE PROVIDED WITH AN AUXILIARY HEAT RELAY. IN THE EVENT THAT THE INDOOR UNIT CANNOT MAINTAIN SPACE TEMPERATURE, AN AUXILIARY HEAT RELAY SHALL SEND A SIGNAL TO THE RADIANT CEILING PANELS AND OPEN THE 2-WAY CONTROL VALVE TO PROVIDE SUPPLEMENTAL PERIMETER HEAT.
- SPACE RELATIVE HUMIDITY SHALL BE CONTROLLED BY THE DOAS UNIT. IN THE EVENT THAT THE DOAS UNIT FAILS TO MAINTAIN SPACE RELATIVE HUMIDITY AND THE SPACE HUMIDITY SET POINT RISES ABOVE SET POINT PLUS (+) 4%RH (ADJ), THE DUCTLESS MINI-SPLIT UNIT VENTILATOR SHALL GO INTO DEHUMIDIFICATION MODE TO MAINTAIN SPACE RELATIVE HUMIDITY SET POINT.

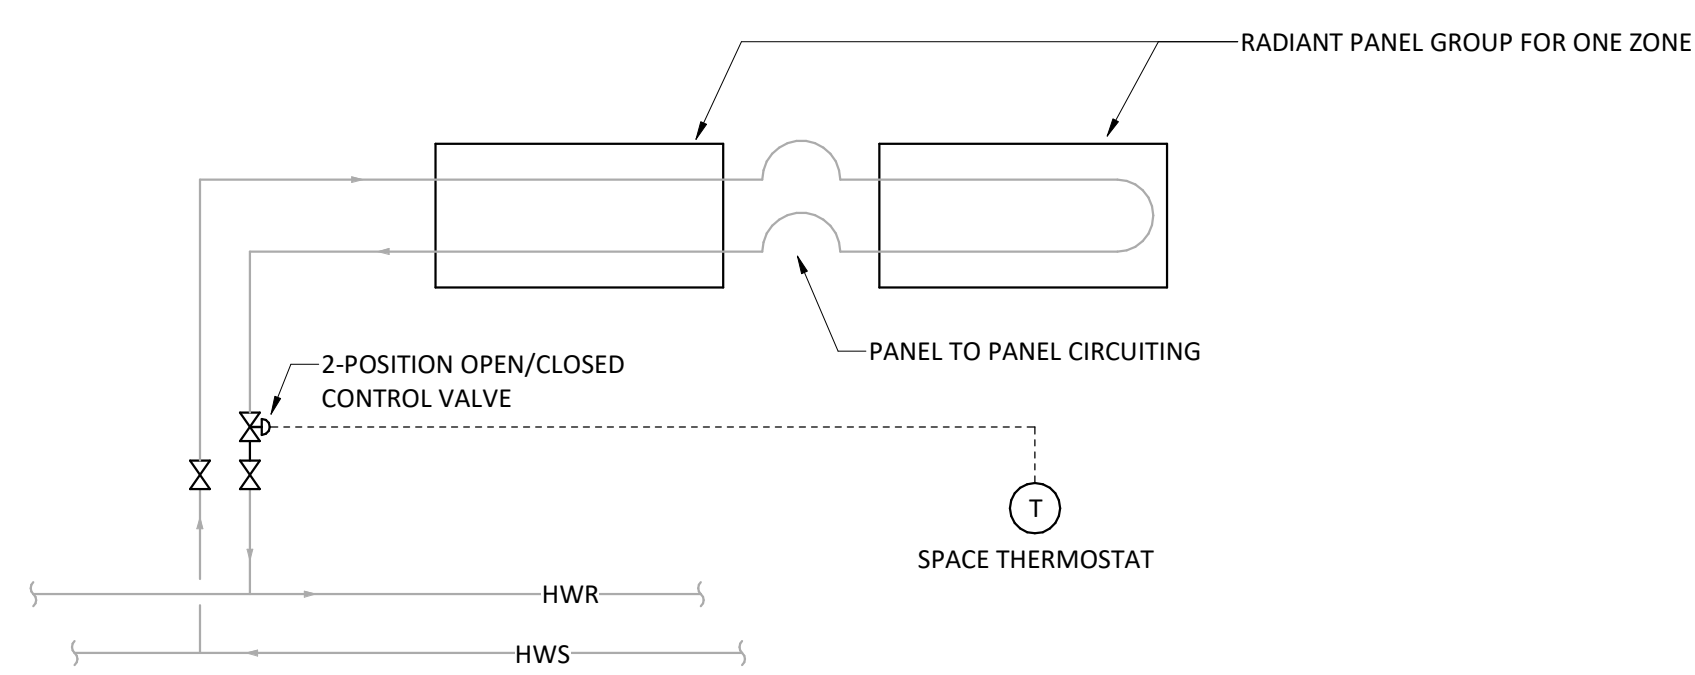


RADIANT HEATING PANELS

NOT TO SCALE

SEQUENCE OF OPERATION

- RADIANT HEATING PANELS SHALL PROVIDE SUPPLEMENTARY HEATING TO ROOMS OR ZONES AS INDICATED ON THE PLANS.
- PROVIDE A THERMOSTAT CONTROLLER IN THE ROOM TO MODULATE THE HOT WATER RETURN CONTROL VALVE OPEN/CLOSED TO MAINTAIN SPACE THERMOSTAT SET POINT. IF SPACE TEMPERATURE SET POINT FALLS BELOW SET POINT MINUS 2F (ADJ), THE CONTROL VALVE SHALL OPEN. IF THE SPACE SET POINT RISES SET POINT PLUS 2F, THE CONTROL VALVE SHALL CLOSE. THE BUILDING AUTOMATION SYSTEM (BAS) SHALL MONITOR THE SPACE TEMPERATURE IN SPACES THAT ALSO HAVE A DUCTLESS MINI-SPLIT HEAT PUMP SYSTEM, THE SET POINT OF THE RADIANT HEATING PANEL SHALL BE 2°F LOWER THAN THE DUCTLESS MINI-SPLIT HEATING THERMOSTAT SET POINT.
- THE CONTROL VALVE SHALL BE 2-POSITION OPEN/CLOSED.
- CONTROL VALVE OPENING AND CLOSING SPEED SHALL BE 'RELATIVELY' SLOW TO PREVENT WATER HAMMER AND RADIANT PANEL NOISE. DESIGN PROFESSIONAL AND/OR OWNER SHALL BE SOLE JUDGES OF SATISFACTORY VALVE SPEED.
- THERMOSTAT SHALL NOT BE LOCATED AT A WALL THAT IS EXPOSED TO THE OUTSIDE ATMOSPHERE.
- ALL SET POINTS SHALL BE ADJUSTABLE.

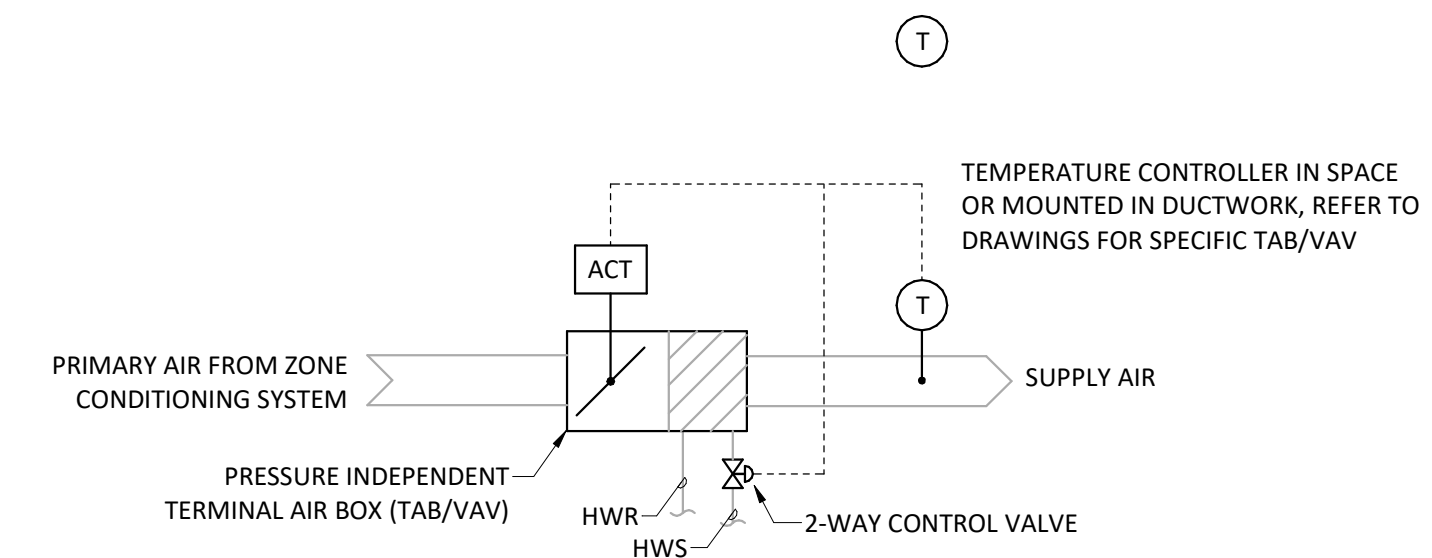


TERMINAL AIR BOX (TAB) / VARIABLE AIR VOLUME (VAV) BOX CONTROL DIAGRAM

NOT TO SCALE

SEQUENCE OF OPERATION

- VARIABLE FLOW TERMINAL AIR BOXES SHALL PROVIDE COOLING, HEATING AND VENTILATION AIR TO SPACES TO THE CONNECTED ZONES BY VARYING THE AIRFLOW TO AND FROM THE ROOM AND MODULATING THE HEATING COIL TWO-WAY CONTROL VALVE TO MAINTAIN THE TEMPERATURE SET POINT OR BY PROVIDING CONSTANT DEHUMIDIFICATION FLOW.
- MODULATE THE TERMINAL AIR BOX FROM MAXIMUM SCHEDULED AIR FLOW TO MINIMUM SCHEDULED AIR FLOW IN RESPONSE TO MECHANICAL COOLING MODE. THE HEATING HOT WATER CONTROL VALVE SHALL MODULATE OPEN AND CLOSED TO MAINTAIN THE TEMPERATURE CONTROLLER SET POINT. THE REVERSE SEQUENCE SHALL OCCUR UPON A RISE ABOVE SET POINT.
- THE BUILDING AUTOMATION SYSTEM (BAS) SHALL CONTROL THE ACTUAL SET POINT OF THE VENTILATION ZONE SERVED BY THE TAB/VAV. THE OCCUPIED/UNOCCUPIED MODE SHALL BE SCHEDULED THROUGH THE BAS SYSTEM.
- PROVIDE A TEMPERATURE BULB IN THE TAB/VAV BOX DISCHARGE FOR INDICATION OF THE BOX PERFORMANCE TO THE BAS AND CONTROL SET POINT.
- THE HOT WATER HEATING CONTROL VALVES SHALL BE CLOSED IF THE SUPPLY TEMPERATURE IS BELOW 100°F (ADJUSTABLE).
- TAB/VAV BOX DISCHARGE AIR TEMPERATURE SHALL BE CONTROLLED TO MATCH THE FOLLOWING TEMPERATURES:
 - SUMMER - AS SCHEDULED IN TAB/VAV SCHEDULE.
 - WINTER - AS SCHEDULED IN TAB/VAV SCHEDULE.

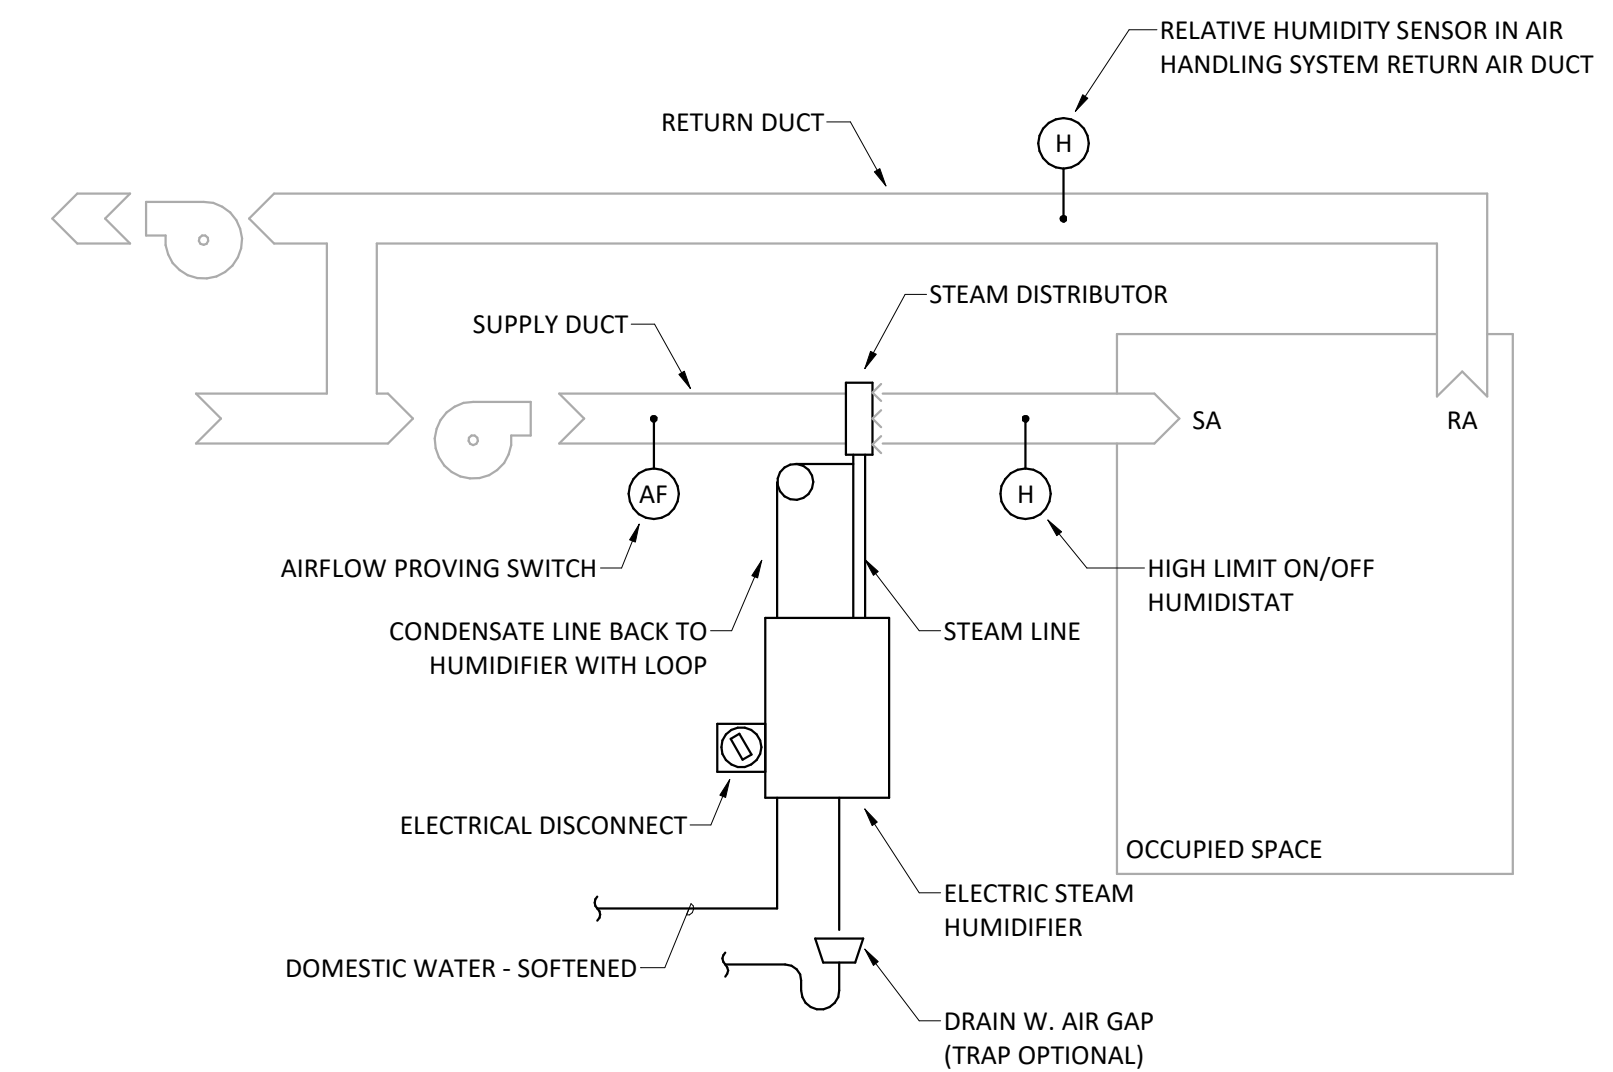

HUMIDIFICATION SYSTEM - ALTERNATE #2

SEQUENCE OF OPERATION

- THE HUMIDITY SHALL BE CONTROLLED BASED ON RETURN AIR RELATIVE HUMIDITY FOR EACH AIR HANDLING SYSTEM (RTU, DOAS). TO PREVENT CONDENSATION, THE RETURN AIR RELATIVE HUMIDITY SET POINT SHALL BE BASED ON OUTSIDE AIR TEMPERATURE RESET.
 - OUTSIDE AMBIENT TEMPERATURE = -20F, RH SET POINT SHALL BE 15% (ADJ)
 - OUTSIDE AMBIENT TEMPERATURE = 20F, RH SET POINT SHALL BE 35% (ADJ)
- UPON A CALL FOR HUMIDITY AND PROOF OF AIRFLOW FROM AIR HANDLING SYSTEM, THE ELECTRIC HUMIDIFIER SHALL MODULATE THE STEAM SUPPLY TO THE DUCT TO MAINTAIN RETURN RELATIVE HUMIDITY SET POINT.
- HUMIDIFIER SHALL BE LOCKED OUT WHEN AIR HANDLING SYSTEM IS IN COOLING MODE, OR IF SUPPLY FAN IS DE-ENERGIZED.
- PROVIDE A HIGH HUMIDITY ALARM IF THE RETURN AIR RELATIVE HUMIDITY EXCEEDS SET POINT +5%RH (ADJ).
- HUMIDIFIER SHALL BE DE-ENERGIZED IF THE WATER LEVEL IN THE BOILER FALLS BELOW MINIMUM SAFE LEVELS AS DETERMINED BY THE MANUFACTURER.
- ALL SET POINTS SHALL BE ADJUSTABLE.


ISSUED FOR

BIDDING


DATE	DESCRIPTION	DATE
02/20/2026		
ADDENDUM 01		03-02-2026

DRAWN BY	JJR
CHECKED BY	JCL
PROJECT NO.	9166-10000
SHEET NAME	


HVAC CONTROLS

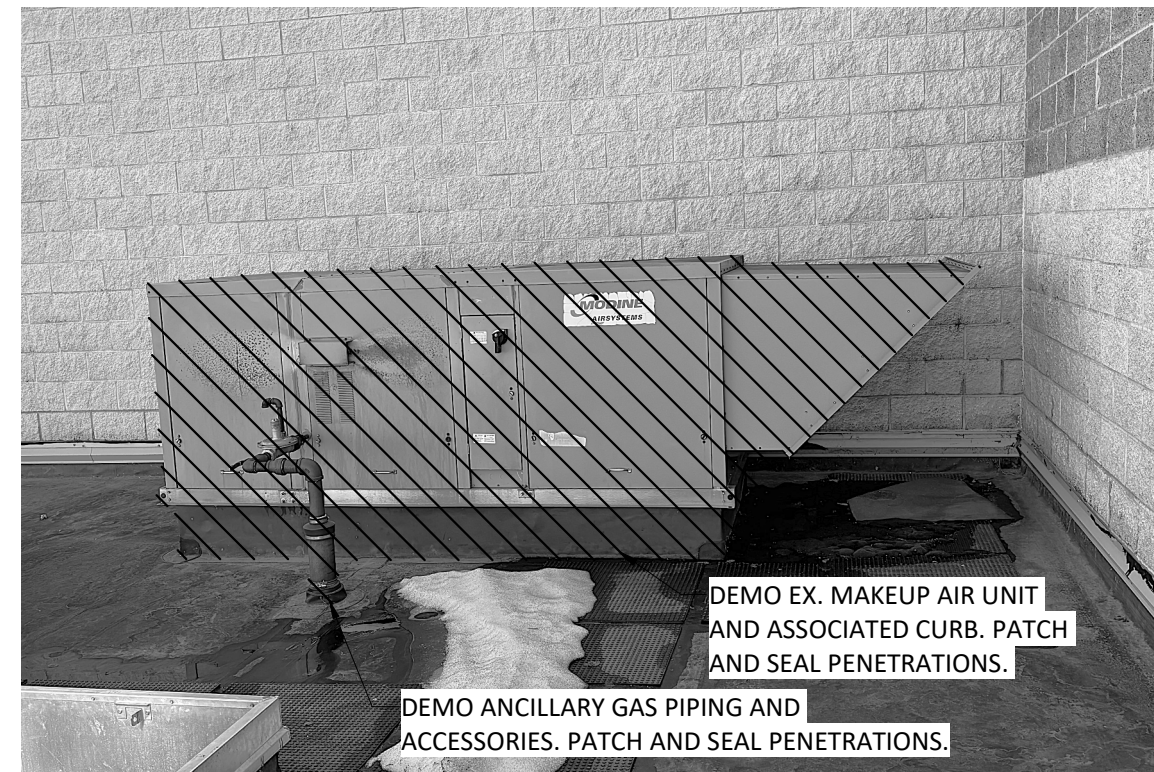

EX. MAKEUP AIR UNIT
NTS ME101

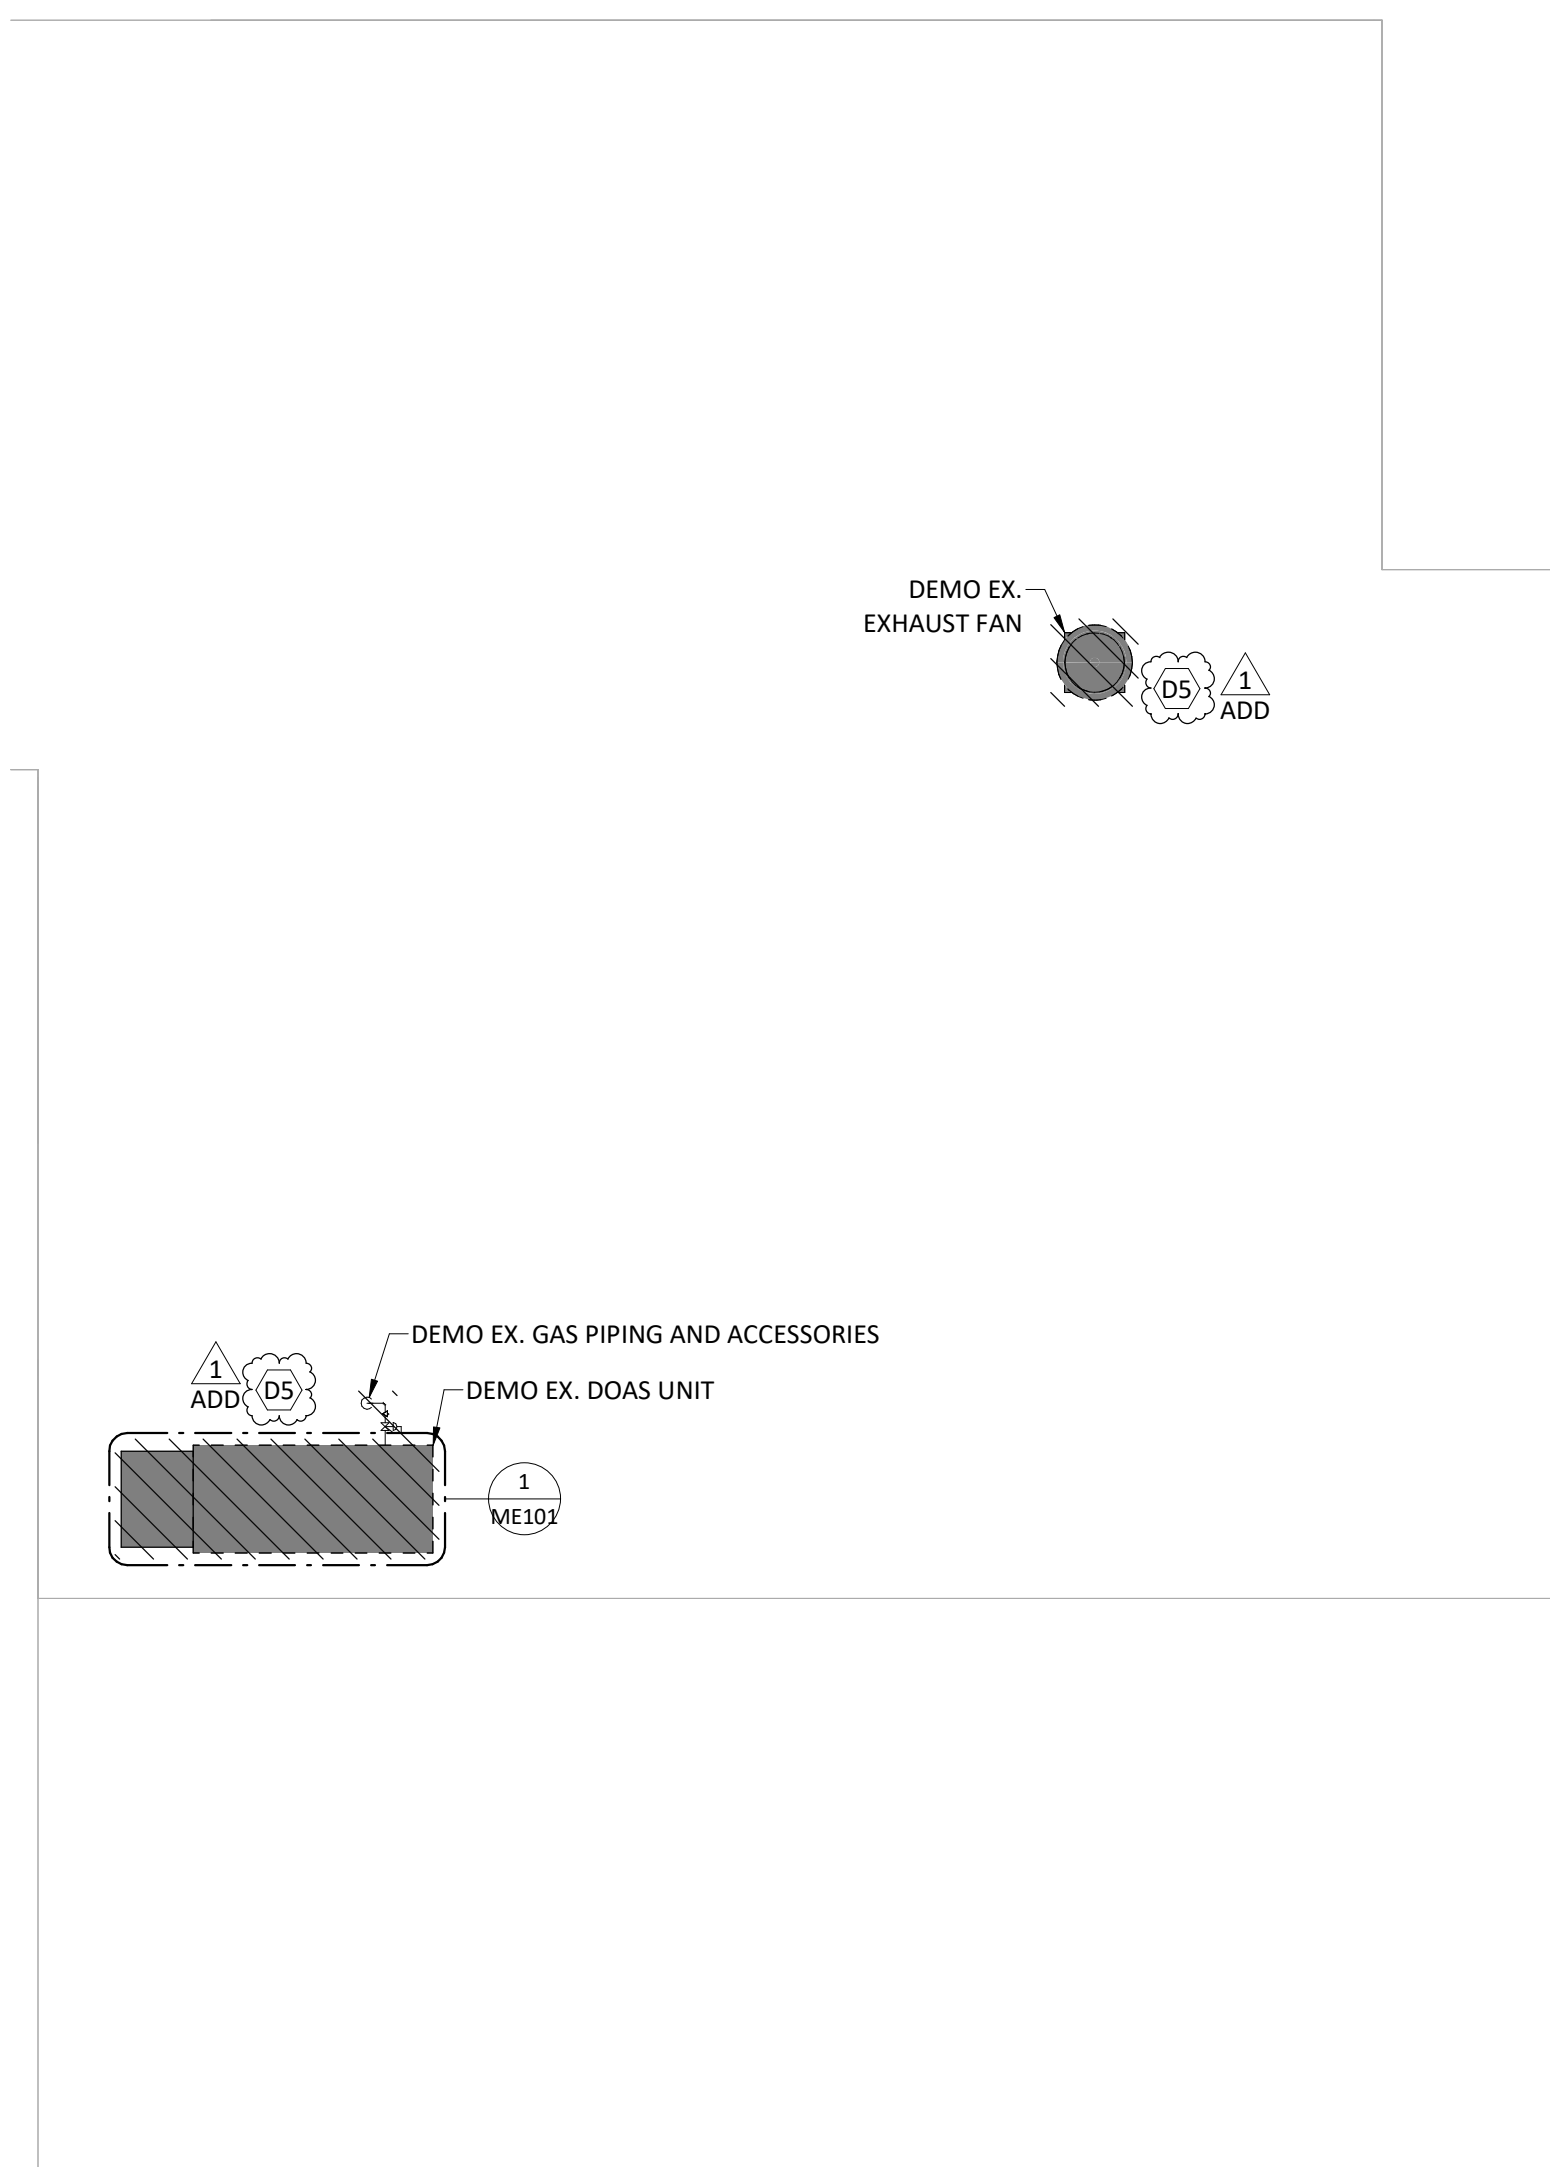

DEMO MECHANICAL & ELECTRICAL ROOF PLAN - HIGH SCHOOL
1/8" = 1'-0"

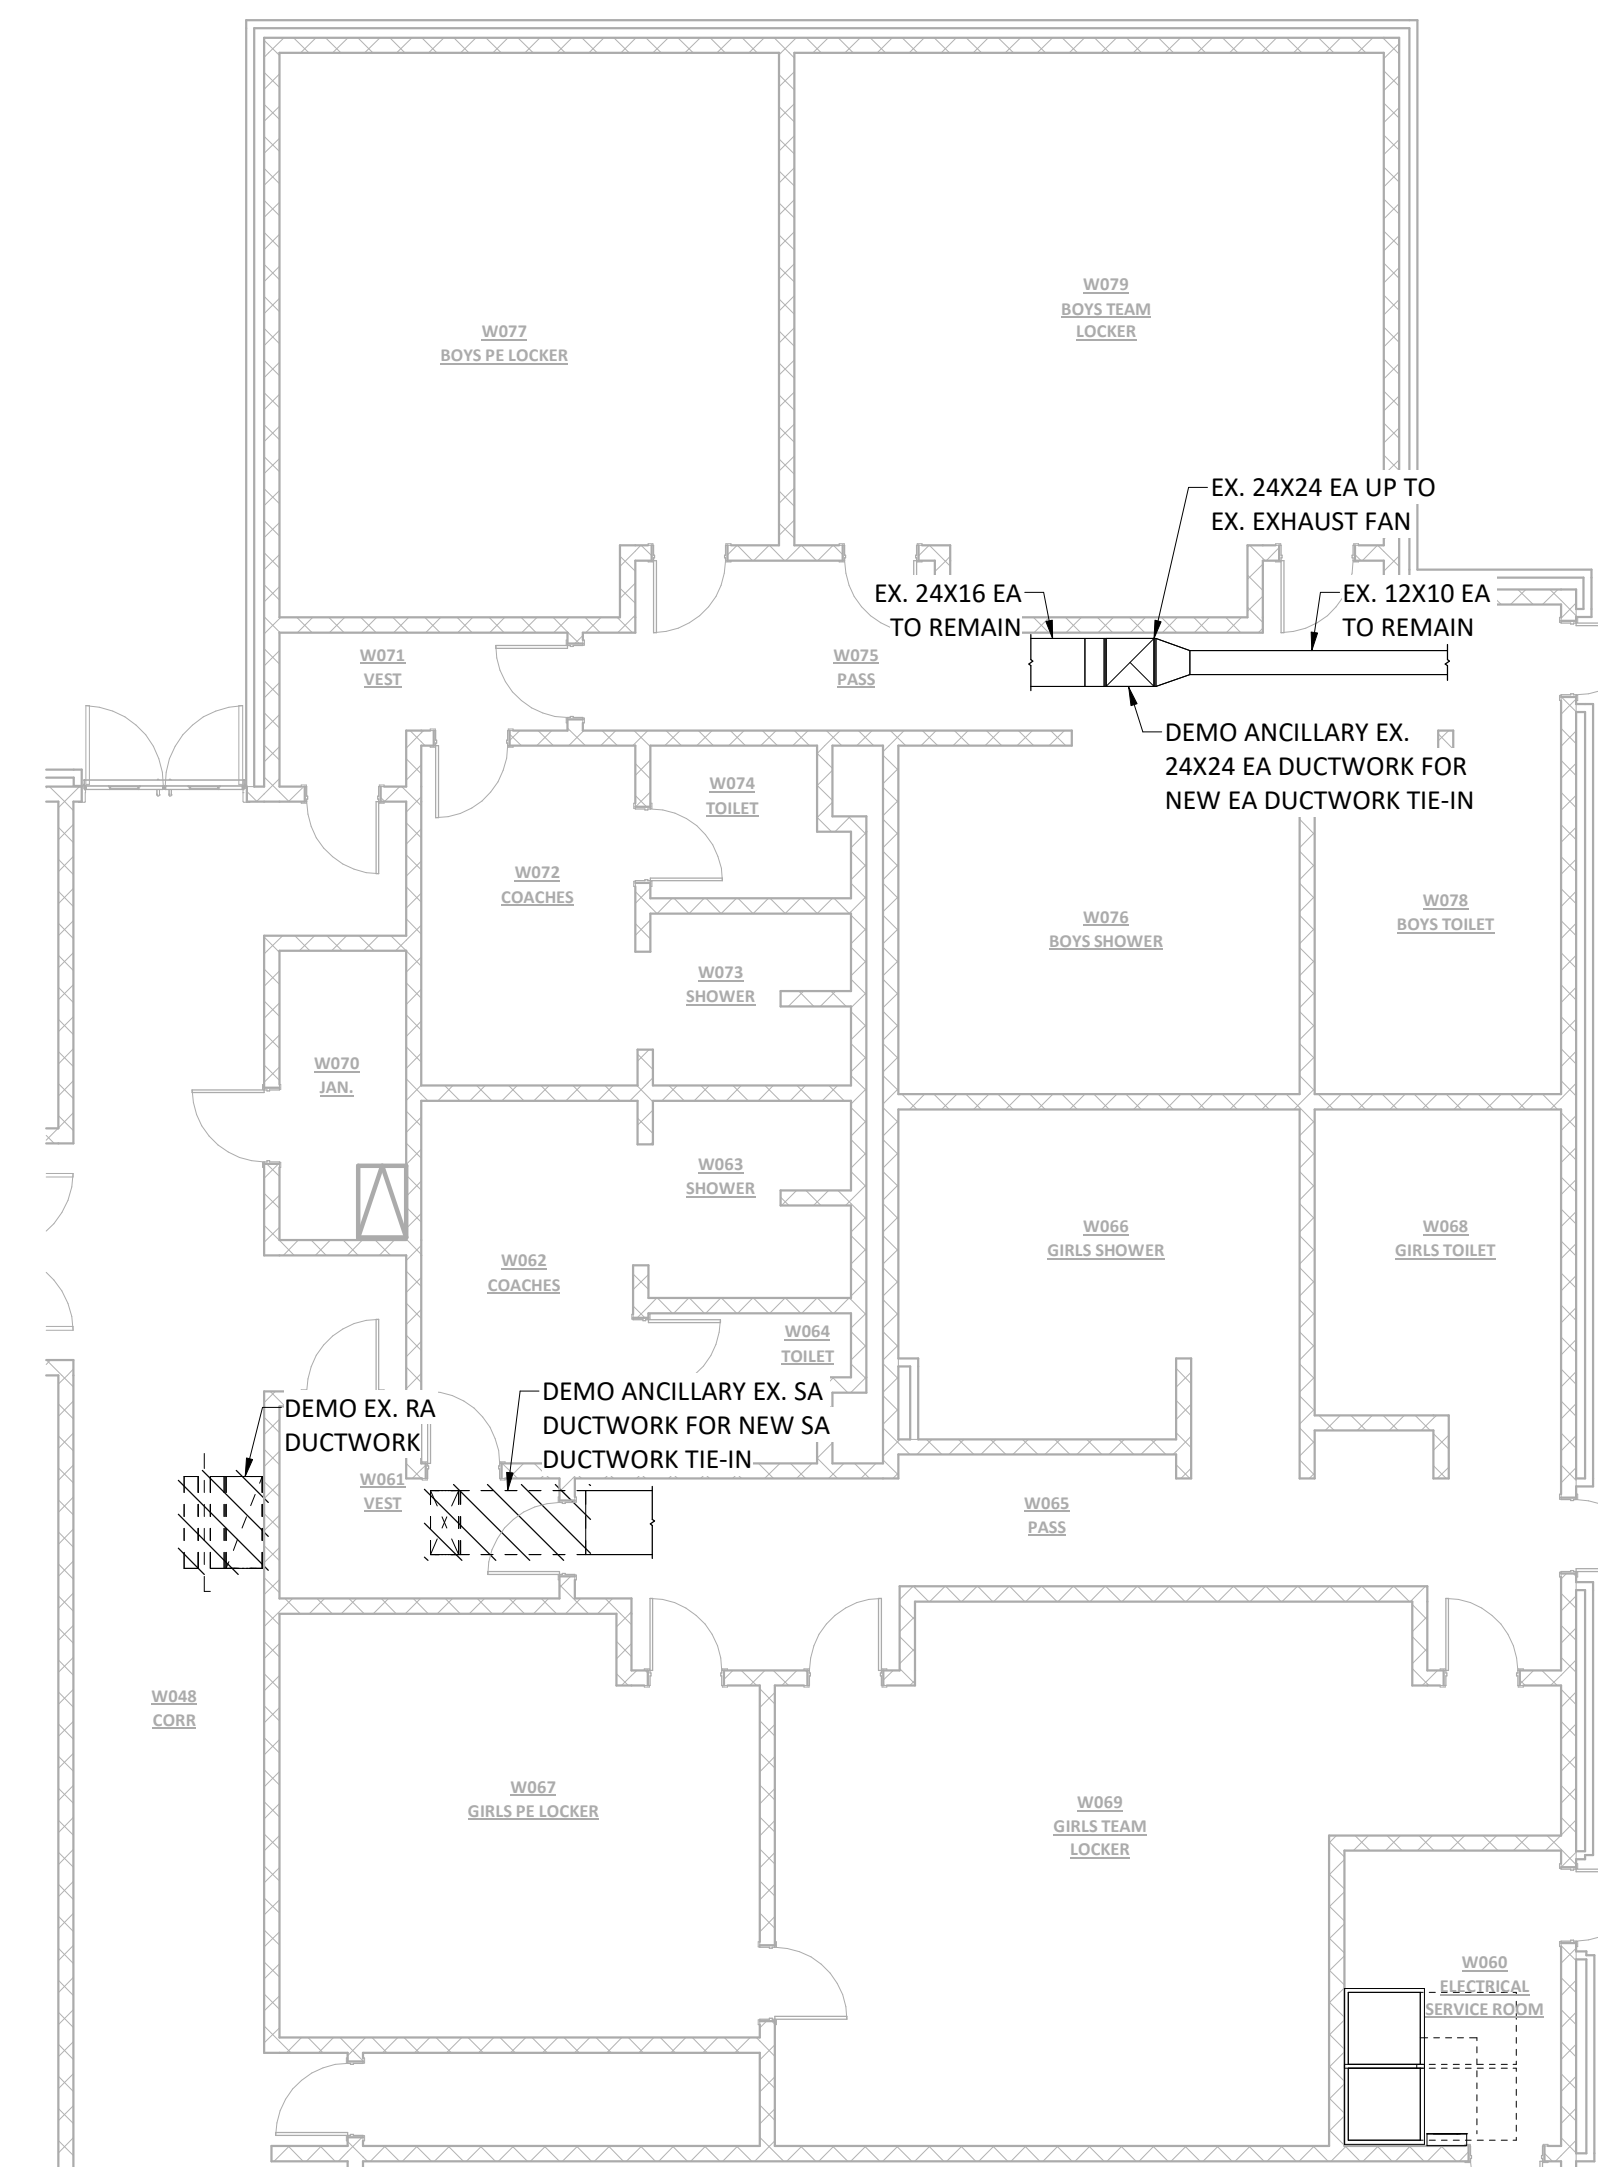

DEMO MECHANICAL & ELECTRICAL PLAN - HIGH SCHOOL
1/8" = 1'-0"

GENERAL DEMO NOTES:

- VERIFY ALL SITE CONDITIONS PRIOR TO STARTING WORK.
- EQUIPMENT SPECIFIED TO BE DEMOLISHED SHALL HAVE THE EQUIPMENT'S ASSOCIATED COMPONENTS REMOVED AND TERMINATED BACK TO THE RESPECTIVE SOURCE WITHOUT DISRUPTING EXISTING SYSTEMS SPECIFIED TO REMAIN. ASSOCIATED EQUIPMENT COMPONENTS TO BE DEMOLISHED INCLUDE BUT ARE NOT LIMITED TO:
 - DUCTWORK (SA/RA/EA/OA)
 - HOT WATER SUPPLY AND RETURN PIPING, FITTINGS, AND ACCESSORIES BACK TO HW PIPING HEADERS
 - ELECTRICAL COMPONENTS
 - THERMOSTAT AND CONTROLS
- ALL PENETRATIONS FOR DUCTWORK, PIPING, ELECTRICAL AND OTHER UTILITIES SPECIFIED TO BE DEMOLISHED SHALL BE PATCHED AND PAINTED TO MATCH EXISTING CONDITIONS.
- ALL EXISTING DUCTWORK AND ASSOCIATED DIFFUSERS, REGISTERS, AND GRILLES BEING REUSED SHALL BE INSPECTED AND CLEANED.

ELECTRICAL DEMO NOTES:

- THE ELECTRICAL CONTRACTOR SHALL BE RESPONSIBLE FOR EXAMINING THE PREMISES AND VERIFYING ALL EXISTING CONDITIONS UNDER WHICH THE WORK IS TO BE PERFORMED. THE DRAWINGS ARE GENERALLY DIAGRAMMATIC IN NATURE. THE CONTRACTOR SHALL COORDINATE AND ADJUST THE WORK AS REQUIRED TO ENSURE PROPER OPERATION OF ALL INSTALLED EQUIPMENT AND SHALL COORDINATE WITH ALL OTHER TRADES.
- REMOVE ALL EXISTING WIRING DEVICES, WIRING, CONDUIT, AND RELATED MATERIALS AS NOTED OR INDICATED WITHIN DEMOLITION AREAS. NOT ALL ITEMS MAY BE SHOWN. MODIFY AND REWORK EXISTING CIRCUITRY AS REQUIRED TO MAINTAIN CONTINUITY THROUGH AFFECTED AREAS.
- REMOVED OR DAMAGED CONDUIT, WIRING, AND FITTINGS SHALL NOT BE REUSED OR RELOCATED FOR NEW INSTALLATIONS.
- PROVIDE COMPLETE AS-BUILT DRAWINGS AND NEW TYPED PANELBOARD DIRECTORIES IDENTIFYING CIRCUIT NUMBERS AND DESCRIPTIONS.
- WORK INCLUDED FOR EXISTING EQUIPMENT NOTED TO BE REMOVED SHALL INCLUDE:
 - SALVAGING OR DISPOSING OF ALL EQUIPMENT AS DIRECTED BY OWNER OR OWNER'S REPRESENTATIVE.
 - REMOVAL OF FEEDER FROM EQUIPMENT TO POINT OF FEED.
 - REMOVAL OR RE-CIRCUITING OF ALL BRANCH CIRCUITING AS NOTED ON PLANS.
 - REMOVAL OF ALL FITTINGS, SUPPORTS, BRACKETS, ETC.
 - PATCHING OF WALLS, FLOORS AND CEILINGS.
 - REMOVAL OF FEEDER CONDUIT IF FOUND TO BE UNSALVAGEABLE BY ENGINEER OR OWNER'S REPRESENTATIVE.
- EXISTING EQUIPMENT NOT SHOWN ON DRAWINGS IS INTENDED TO REMAIN UNLESS OTHERWISE NOTED.
- THE ELECTRICAL CONTRACTOR SHALL BE RESPONSIBLE FOR DISCONNECTING AND REMOVING ALL ELECTRICAL CONNECTIONS AND EQUIPMENT REQUIRED FOR THE INSTALLATION OF NEW EQUIPMENT PROVIDED BY THE MECHANICAL CONTRACTOR. THE ELECTRICAL CONTRACTOR SHALL COORDINATE WITH THE MECHANICAL CONTRACTOR TO CONFIRM AND AGREE UPON THIS SCOPE OF WORK PRIOR TO BID SUBMISSION.

ELECTRICAL DEMO KEYED NOTES

MECHANICAL EQUIPMENT TO BE DEMOED (DIV 15). DIV 16 TO REMOVE ALL ASSOCIATED WIRING, CONDUIT, BOXES AND DISCONNECTS BACK TO SOURCE. IF UNIT IS BEING REPLACED, AND EXISTING CONDUIT IS IN GOOD CONDITION AND SIZED APPROPRIATELY, EXISTING CONDUIT MAY BE RE-USED FOR NEW CONDUCTORS TO PROPOSED EQUIPMENT.

ISSUED FOR

BIDDING

DATE 02/20/2026

DESCRIPTION DATE

ADDENDUM 01 03-02-2026

DRAWN BY JJR

CHECKED BY JCL

PROJECT NO. 9166-10000

SHEET NAME

DEMO MECHANICAL & ELECTRICAL PLANS - HIGH SCHOOL

ME101


NOT FOR CONSTRUCTION



PROVIDE NEW 20A/1P BREAKER FOR UH-1


PROVIDE NEW 20A/1P BREAKER FOR UH-2

ELEMENTARY STAGE PANEL
2
NTS ME103

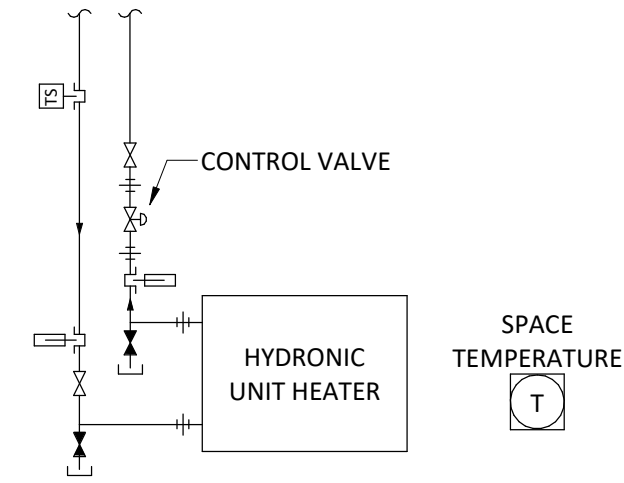

UNIT HEATER SEQUENCE OF OPERATION:

- A. GENERAL:
 1. REFER TO THE OCCUPANCY AND SET POINT SCHEDULE FOR A DESCRIPTION OF ALL OCCUPANCY MODES AND SET POINTS.
 2. EACH SPACE SERVED SHALL BE PROVIDED WITH A TEMPERATURE SENSOR.
- B. GAS UNIT HEATERS:
 1. THE GAS UNIT HEATER SHALL BE ON WHENEVER THERE IS A CALL FOR HEATING.

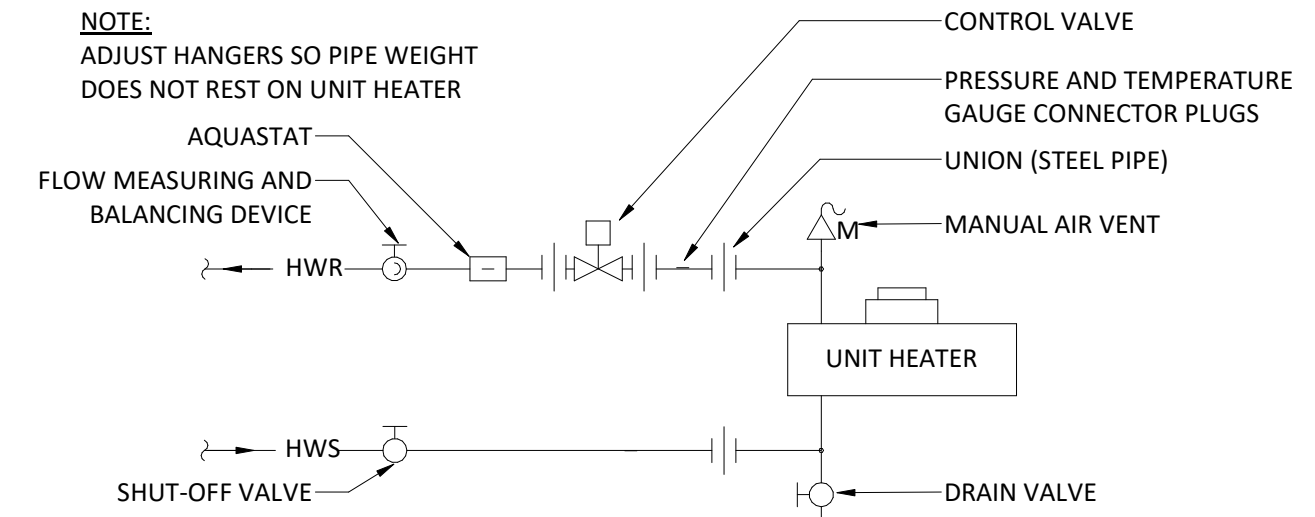


HOT WATER UNIT HEATER PIPING DETAIL
1
NTS ME103

EAST ELEMENTARY MOTOR AND EQUIPMENT SCHEDULE														
EQUIP TAG	NOTES: EQUIPMENT TAGS NOTED AS ## & ## ARE WIRED TO SAME CIRCUIT. AMPACITY SHOWN IS TOTAL CIRCUIT AMPS.										STARTER/DISCONNECT E-FURNISHED BY ELECTRICAL CONTRACTOR M-FURNISHED BY MECHANICAL CONTRACTOR			
	DESCRIPTION	AMP	VOLTAGE	# OF POLES	WIRE SIZE	CONDUIT	PANEL/MCC	MOCBP	DISC	SW AMPS	FUSE AMPS	NEMA RATING	NOTES	REMARKS
UH-1	UNIT HEATER	7.2 A	120 V	1	1-#12, 1-#12, 1-#12	3/4"	E. ELEM STAGE	15 A	M					
UH-2	UNIT HEATER	7.2 A	120 V	1	1-#12, 1-#12, 1-#12	3/4"	E. ELEM STAGE	15 A	M					

HOT WATER UNIT HEATER SCHEDULE - ALTERNATE #4																
PLAN MARK	HEATING CAPACITY (BTU/HR)	AIRFLOW (CFM)	CONNECTION SIZE	FLOWRATE (GPM)	WATER PD (FT. HEAD)	EWT (°F)	TEMP. DROP (Δ°F)	ELECTRICAL			DIMENSIONS (INCHES)			AREA SERVED	MANUFACTURER MODEL	NOTES
								HP	VOLTAGE	Ø	WIDTH	DEPTH	HEIGHT			
UH-1	105,891	2,900	1-1/2"Ø	14.9	0.79	180°F	20°F	1/3	120	1	24-5/8	13-3/4	29	GYM	TRANE HYDRONIC UNIT HEATER MODEL S-204	ALL
UH-2	105,891	2,900	1-1/2"Ø	14.9	0.79	180°F	20°F	1/3	120	1	24-5/8	13-3/4	29	GYM	TRANE HYDRONIC UNIT HEATER MODEL S-204	ALL

1. PROVIDE WALL MOUNT PROGRAMMABLE THERMOSTAT.
2. PROVIDE UNIT HEATERS WITH FACTORY WIRED DISCONNECT SWITCH.
3. REFER TO MANUFACTURER'S RECOMMENDATIONS FOR MOUNTING HEIGHT AND INSTALLATION REQUIREMENTS.

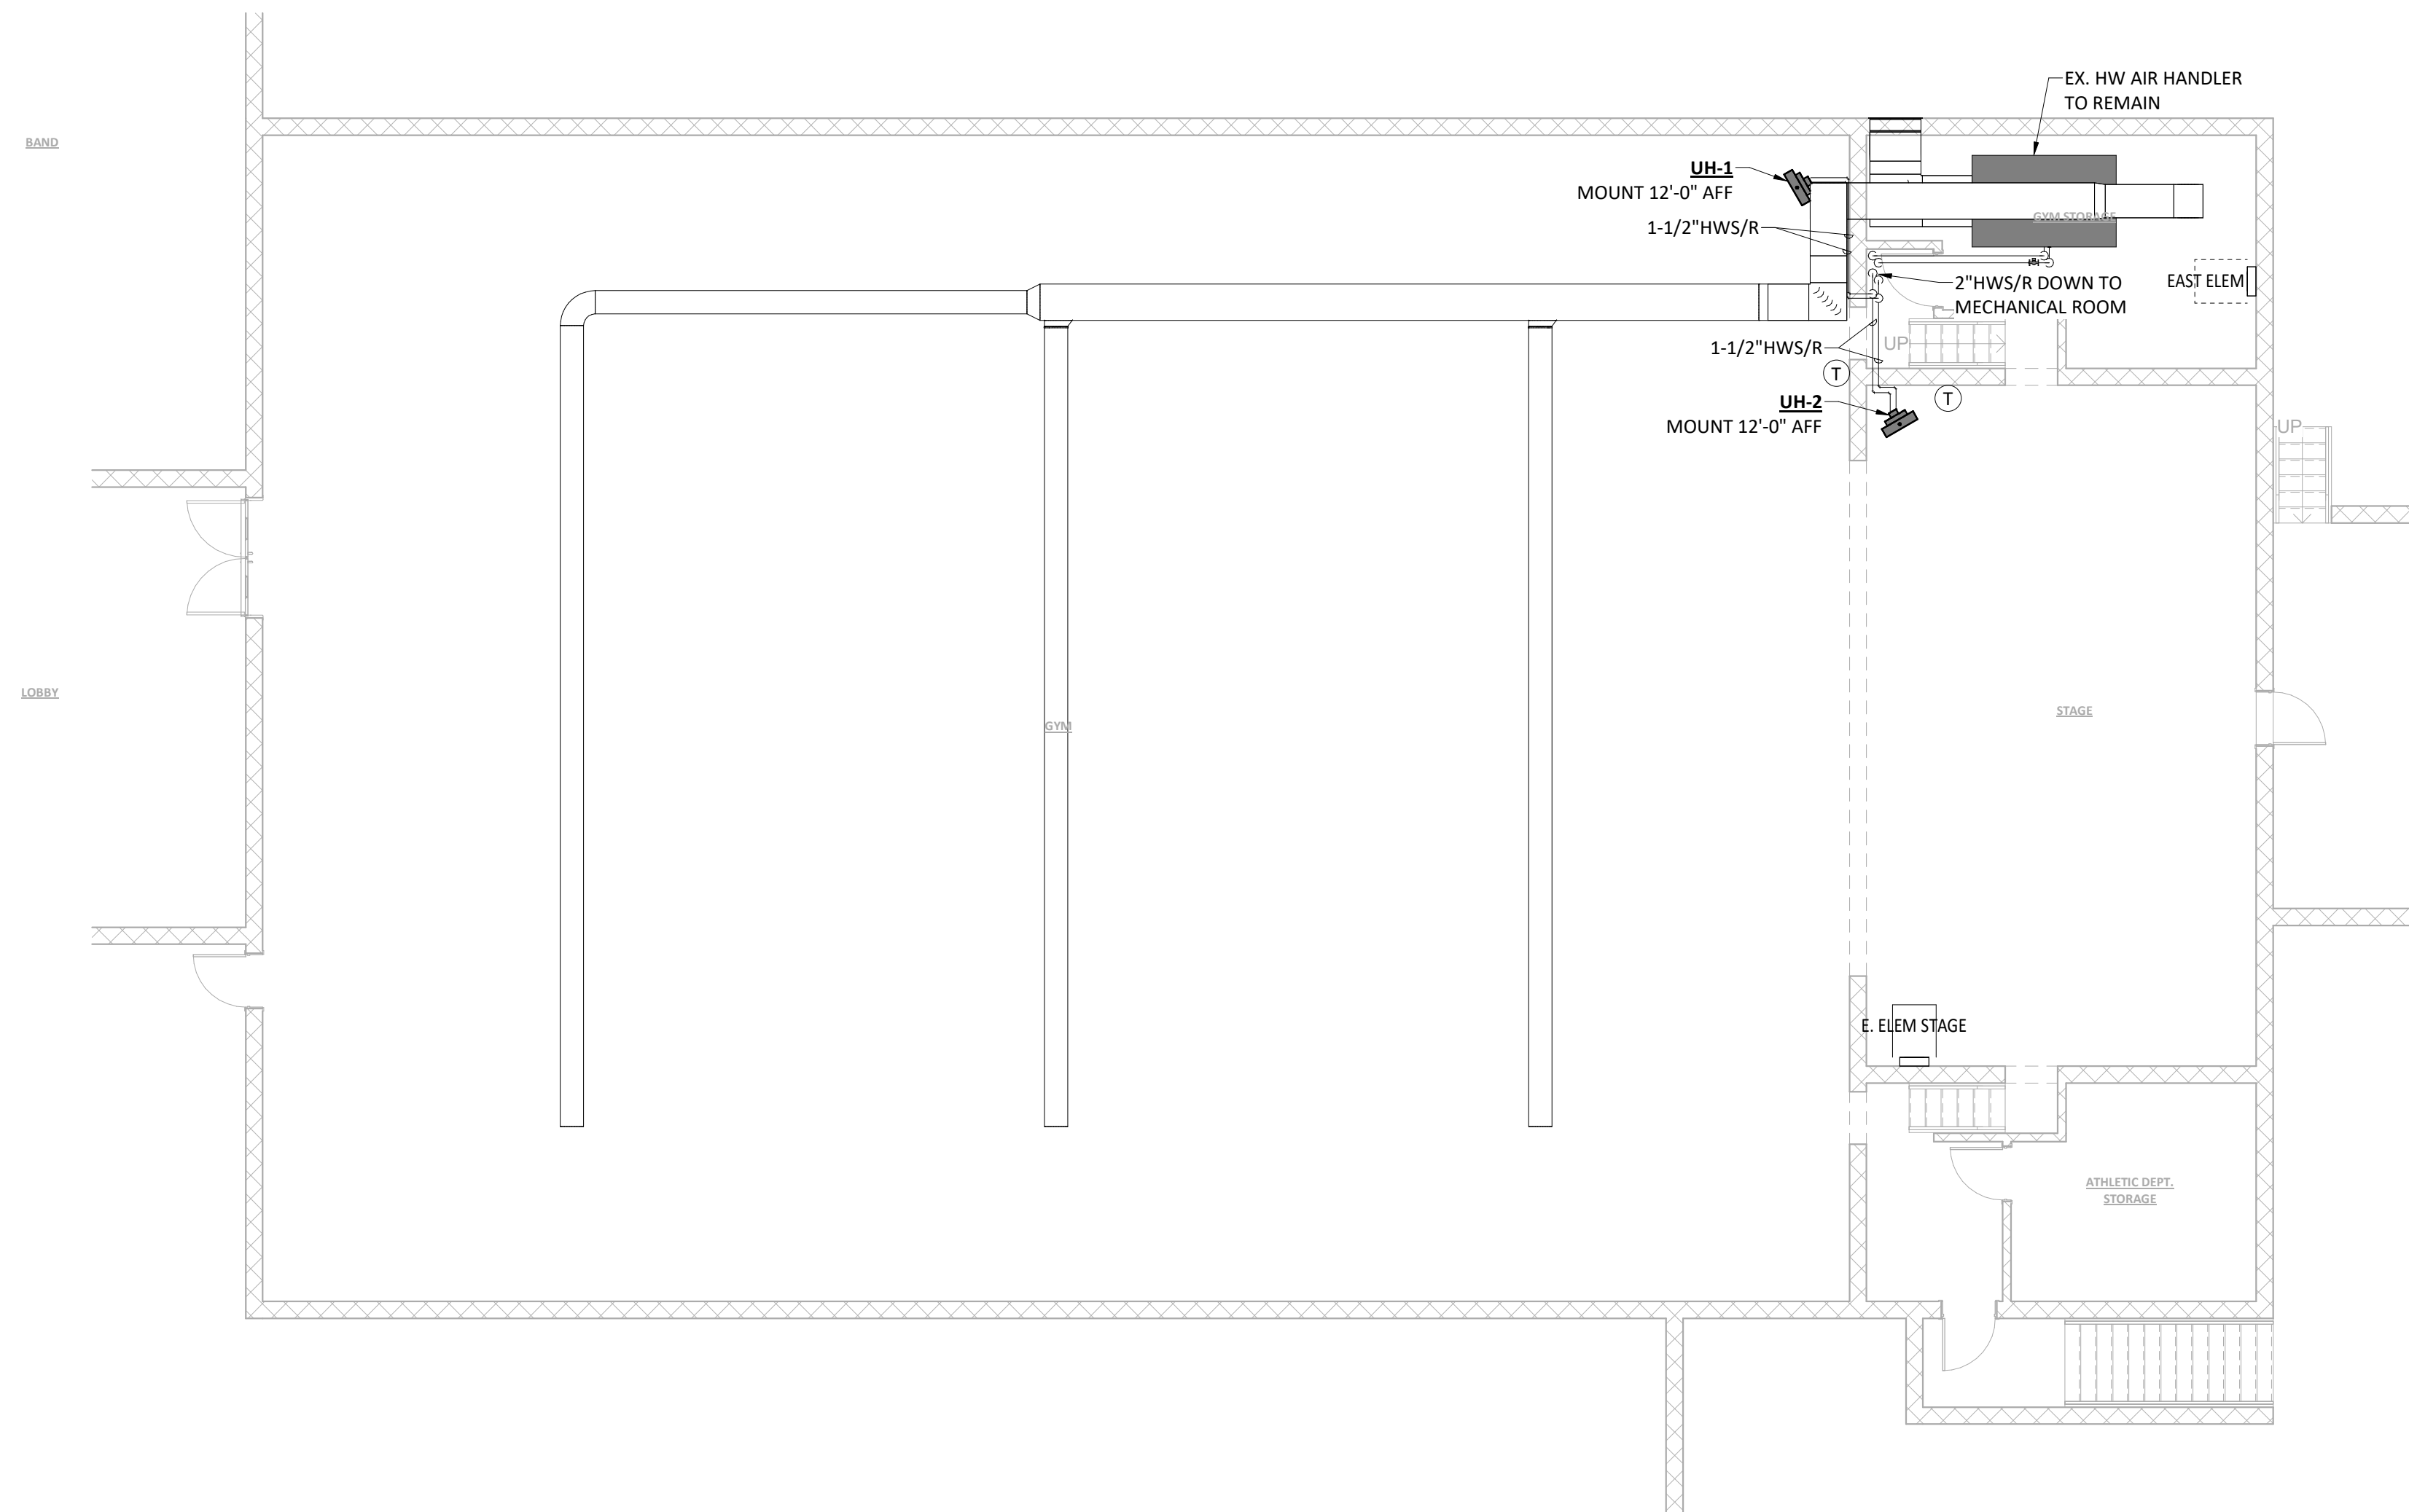

MECHANICAL & ELECTRICAL PLAN - EAST ELEMENTARY
1/8" = 1'-0" N

ISSUED FOR

BIDDING



DATE	02/20/2026
DESCRIPTION	DATE
ADDENDUM 01	03-02-2026

DRAWN BY	JJR
CHECKED BY	JCL
PROJECT NO.	9166-10000
SHEET NAME	

MECHANICAL & ELECTRICAL PLAN - EAST ELEMENTARY

NOT FOR CONSTRUCTION

REFER TO SPECIFICATION SECTION 01100 SUMMARY, COVER PAGE AND ENLARGED PLANS FOR SCOPE OF WORK FOR ALTERNATES

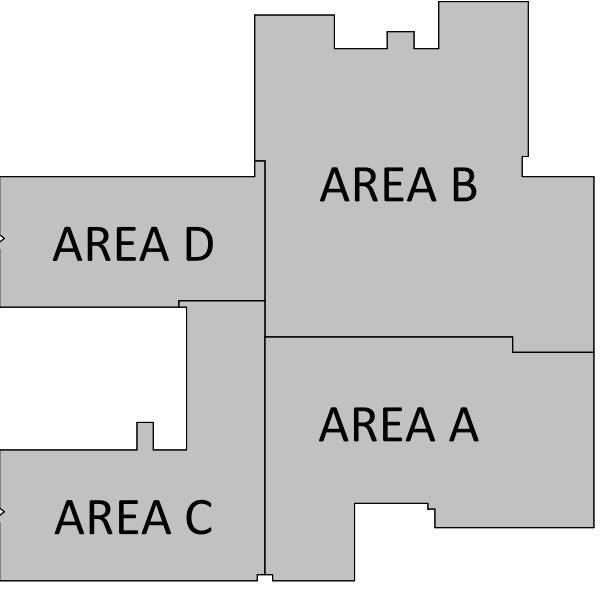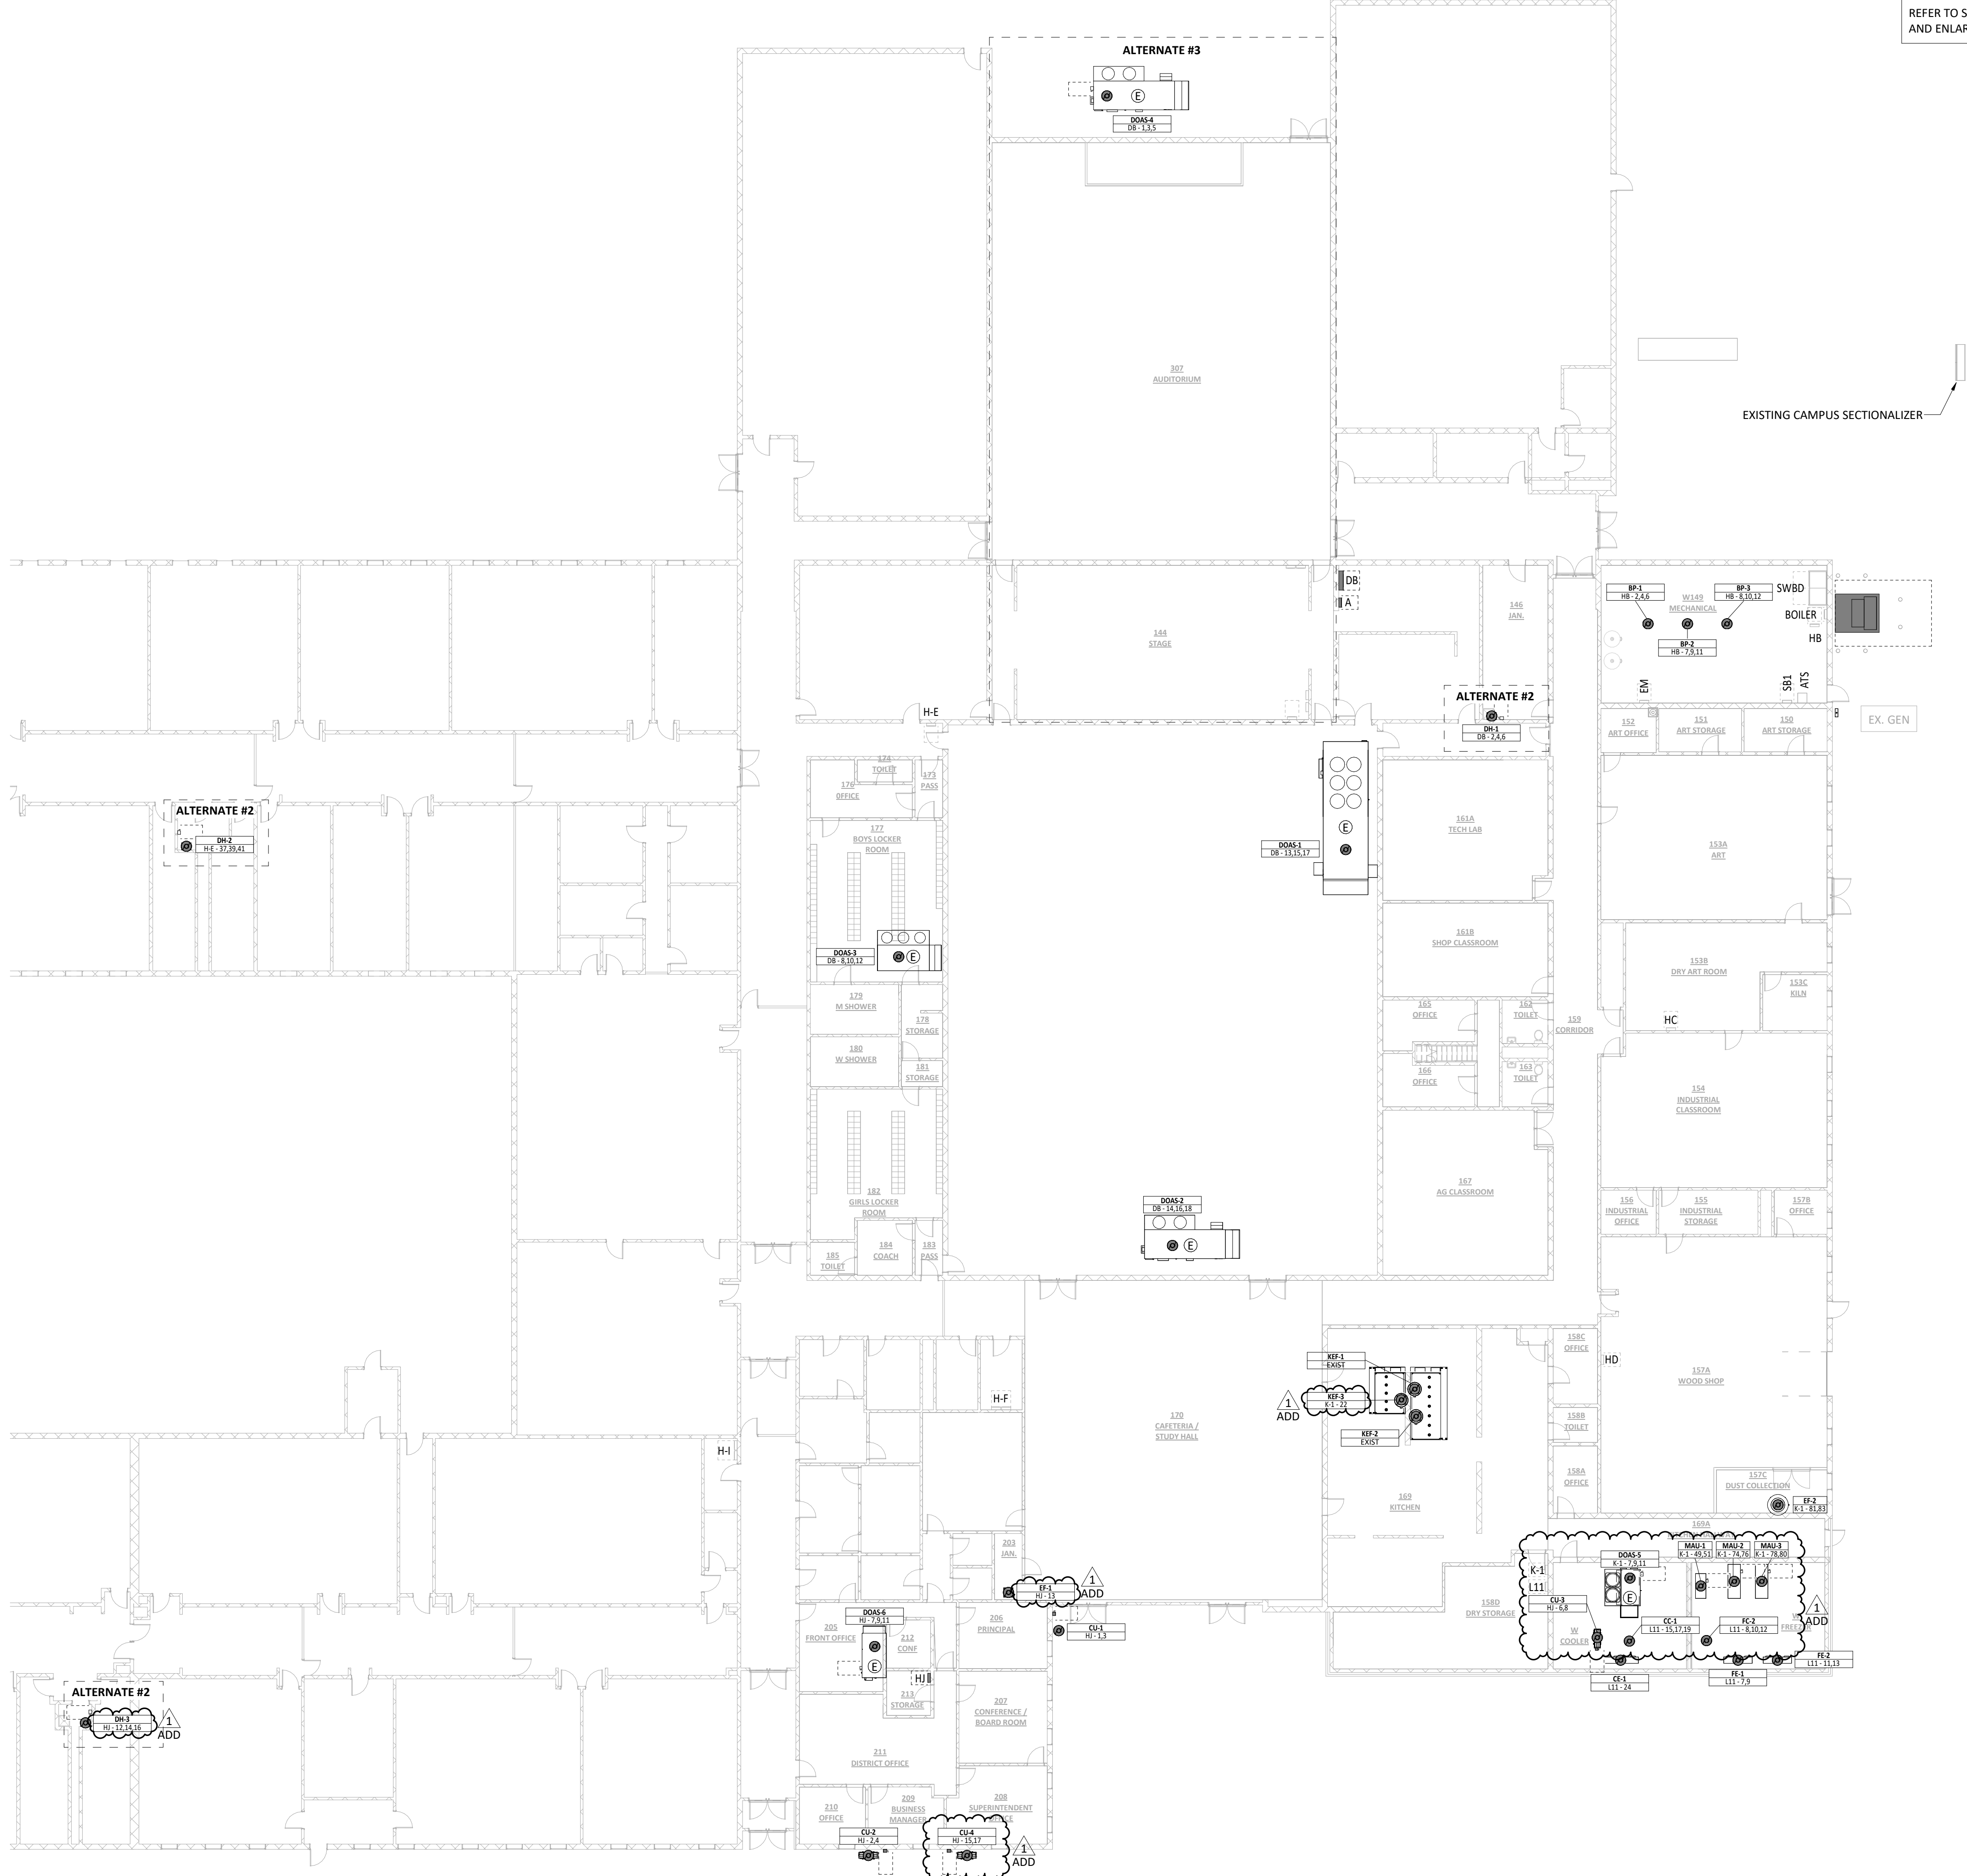

MIDDLE SCHOOL BUILDING KEY PLAN


ELECTRICAL PLAN - OVERALL
1/16" = 1'-0" E-101

ISSUED FOR

BIDDING	
DATE	DESCRIPTION
02/20/2026	
03-02-2026	ADDENDUM 01

DRAWN BY	DMS
CHECKED BY	KDM
PROJECT NO.	9166-10000
SHEET NAME	ELECTRICAL PLAN - OVERALL

NOT FOR CONSTRUCTION

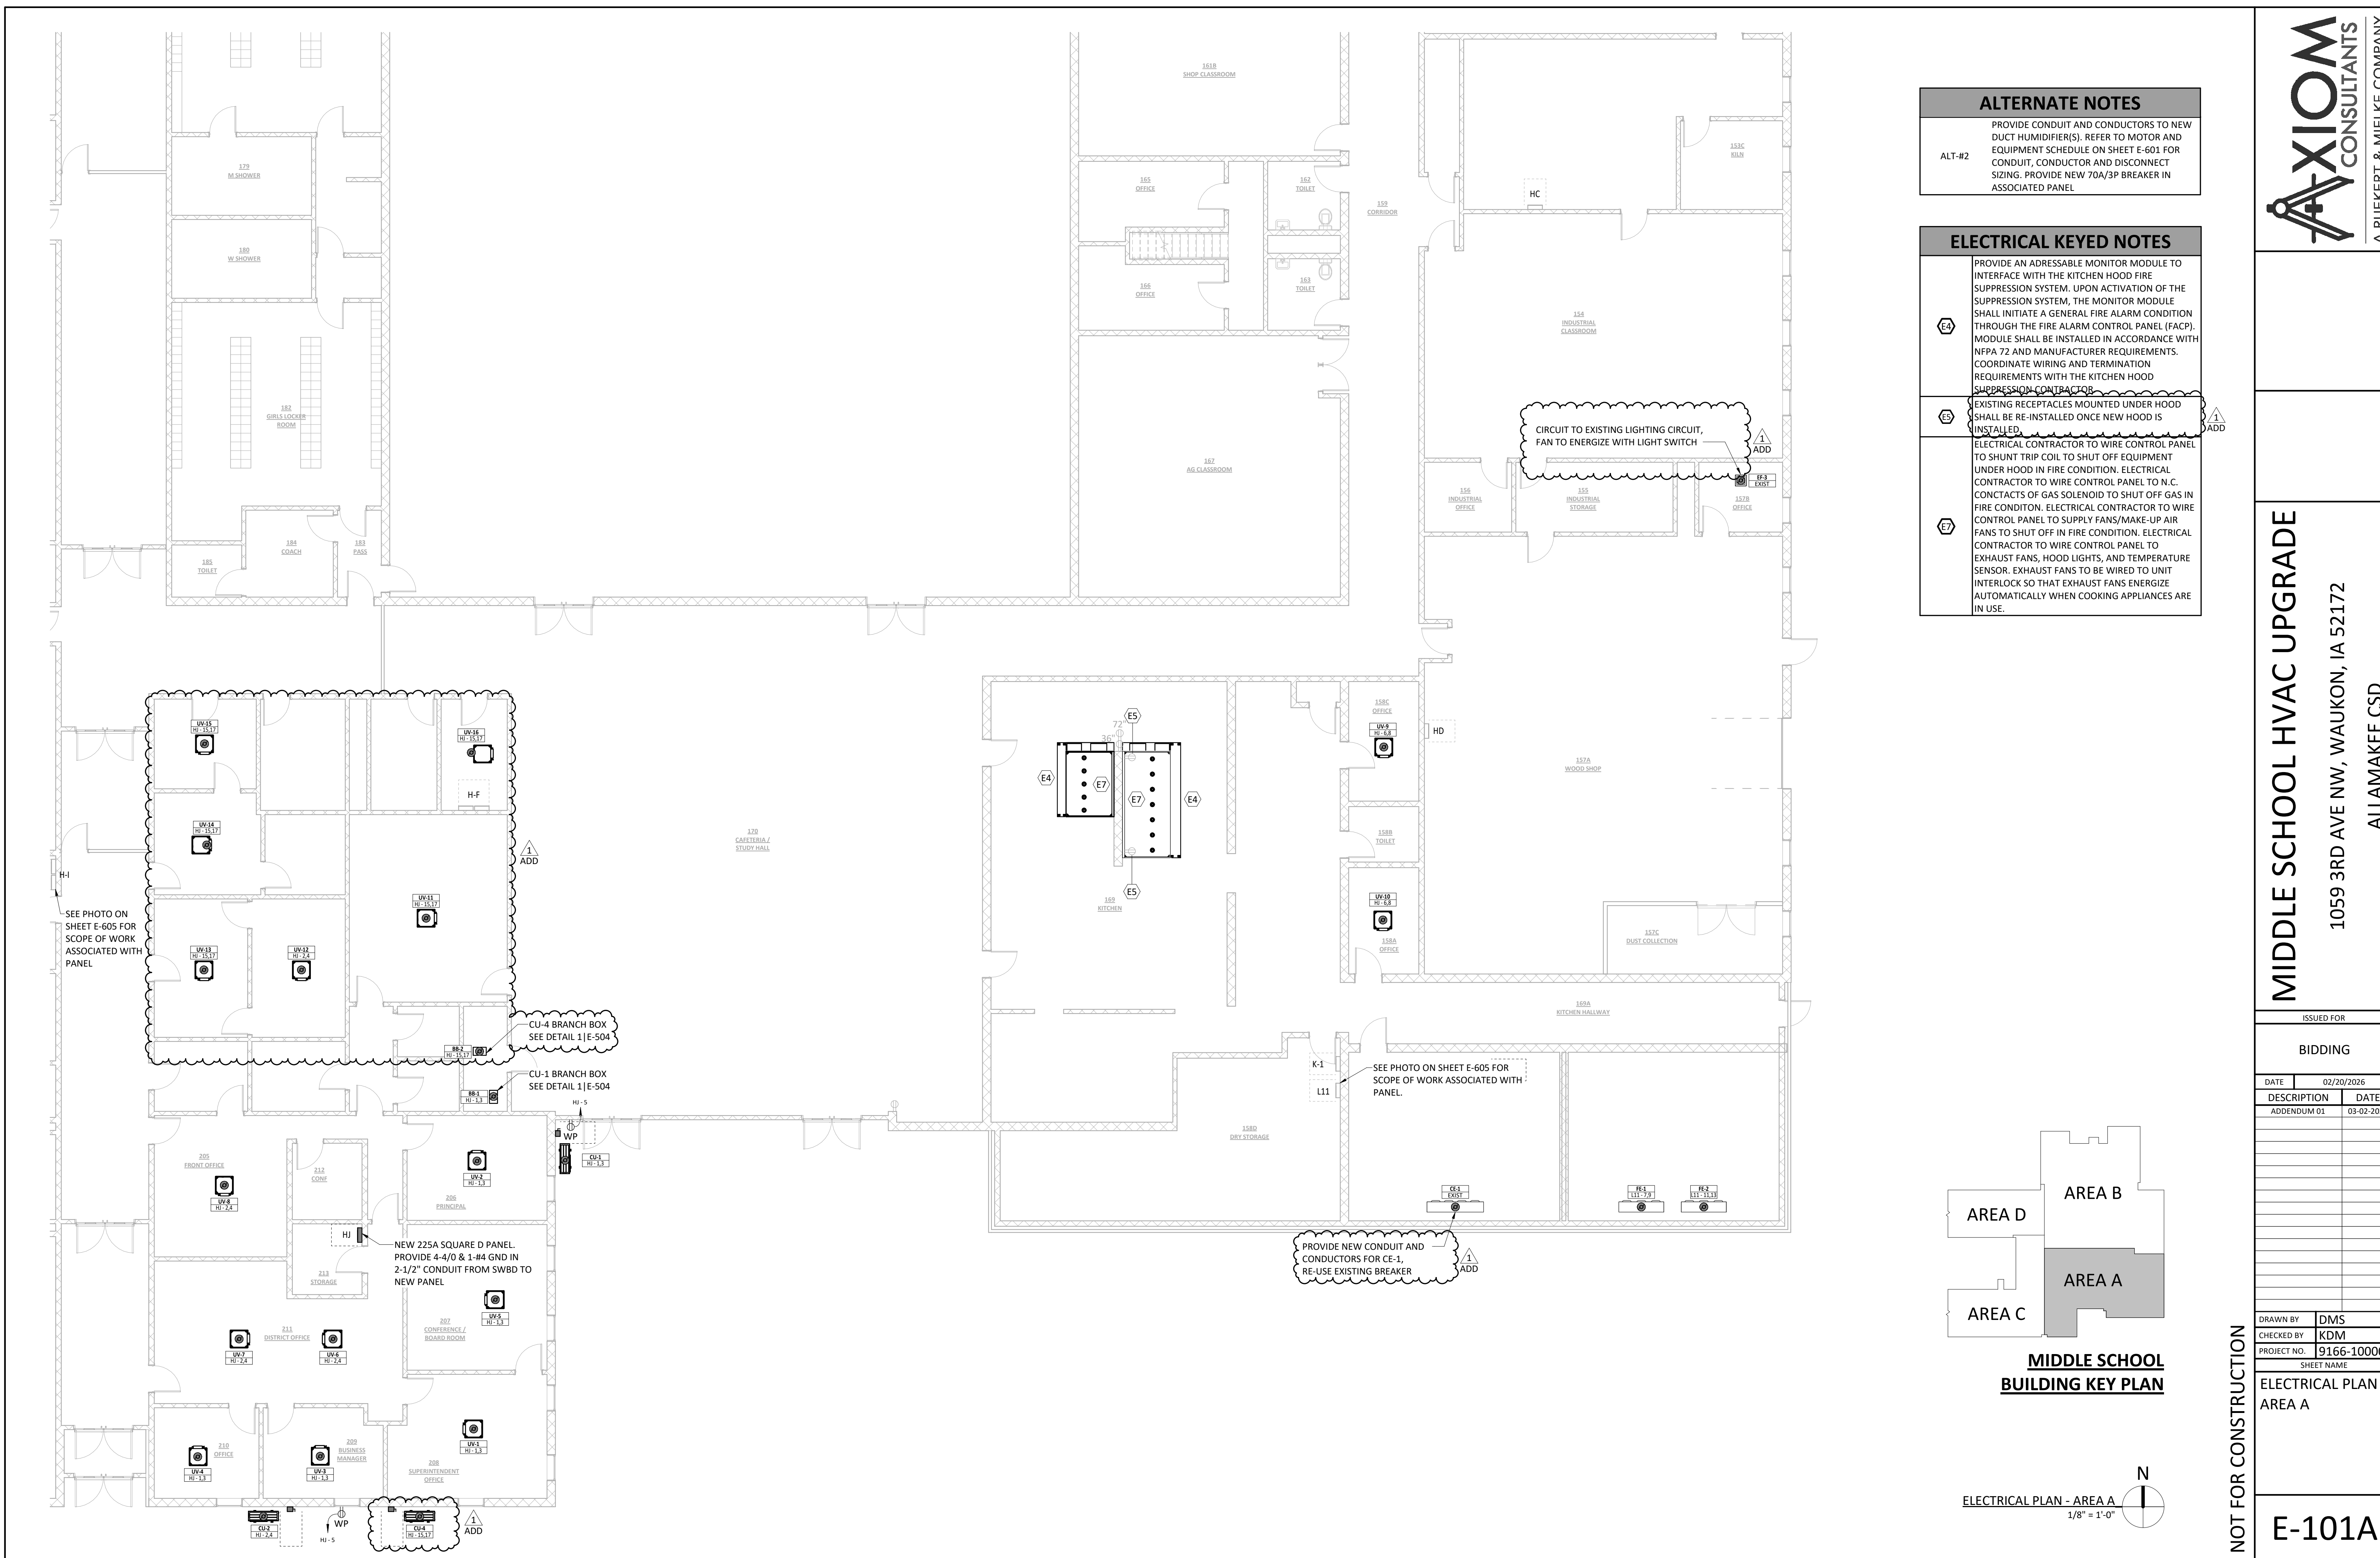

ALTERNATE NOTES


PROVIDE CONDUIT AND CONDUCTORS TO NEW DUCT HUMIDIFIER(S). REFER TO MOTOR AND EQUIPMENT SCHEDULE ON SHEET E-601 FOR CONDUIT, CONDUCTOR AND DISCONNECT SIZING. PROVIDE NEW 70A/3P BREAKER IN ASSOCIATED PANEL

ELECTRICAL KEYED NOTES

PROVIDE AN ADDRESSABLE MONITOR MODULE TO INTERFACE WITH THE KITCHEN HOOD FIRE SUPPRESSION SYSTEM. UPON ACTIVATION OF THE SUPPRESSION SYSTEM, THE MONITOR MODULE SHALL INITIATE A GENERAL FIRE ALARM CONDITION THROUGH THE FIRE ALARM CONTROL PANEL (FACP). MODULE SHALL BE INSTALLED IN ACCORDANCE WITH NFPA 72 AND MANUFACTURER REQUIREMENTS. COORDINATE WIRING AND TERMINATION REQUIREMENTS WITH THE KITCHEN HOOD SUPPRESSION CONTRACTOR

EXISTING RECEPTACLES MOUNTED UNDER HOOD SHALL BE RE-INSTALLED ONCE NEW HOOD IS INSTALLED

ELECTRICAL CONTRACTOR TO WIRE CONTROL PANEL TO SHUNT TRIP COIL TO SHUT OFF EQUIPMENT UNDER HOOD IN FIRE CONDITION. ELECTRICAL CONTRACTOR TO WIRE CONTROL PANEL TO N.C. CONTACTS OF GAS SOLENOID TO SHUT OFF GAS IN FIRE CONDITION. ELECTRICAL CONTRACTOR TO WIRE CONTROL PANEL TO SUPPLY FANS/MAKE-UP AIR FANS TO SHUT OFF IN FIRE CONDITION. ELECTRICAL CONTRACTOR TO WIRE CONTROL PANEL TO EXHAUST FANS, HOOD LIGHTS, AND TEMPERATURE SENSOR. EXHAUST FANS TO BE WIRED TO UNIT INTERLOCK SO THAT EXHAUST FANS ENERGIZE AUTOMATICALLY WHEN COOKING APPLIANCES ARE IN USE.

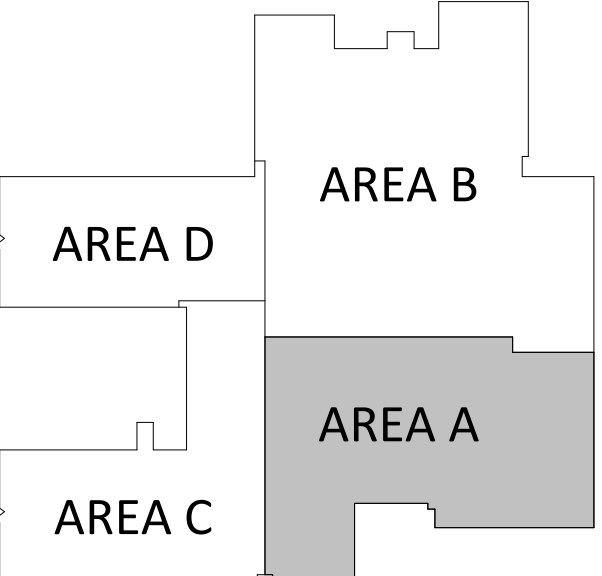

MIDDLE SCHOOL BUILDING KEY PLAN


ELECTRICAL PLAN - AREA A
1/8" = 1'-0"

ISSUED FOR	
BIDDING	
DATE	02/20/2026
DESCRIPTION	DATE
ADDENDUM 01	03-02-2026

DRAWN BY	DMS
CHECKED BY	KDM
PROJECT NO.	9166-10000
SHEET NAME	

ELECTRICAL PLAN - AREA A

NOT FOR CONSTRUCTION

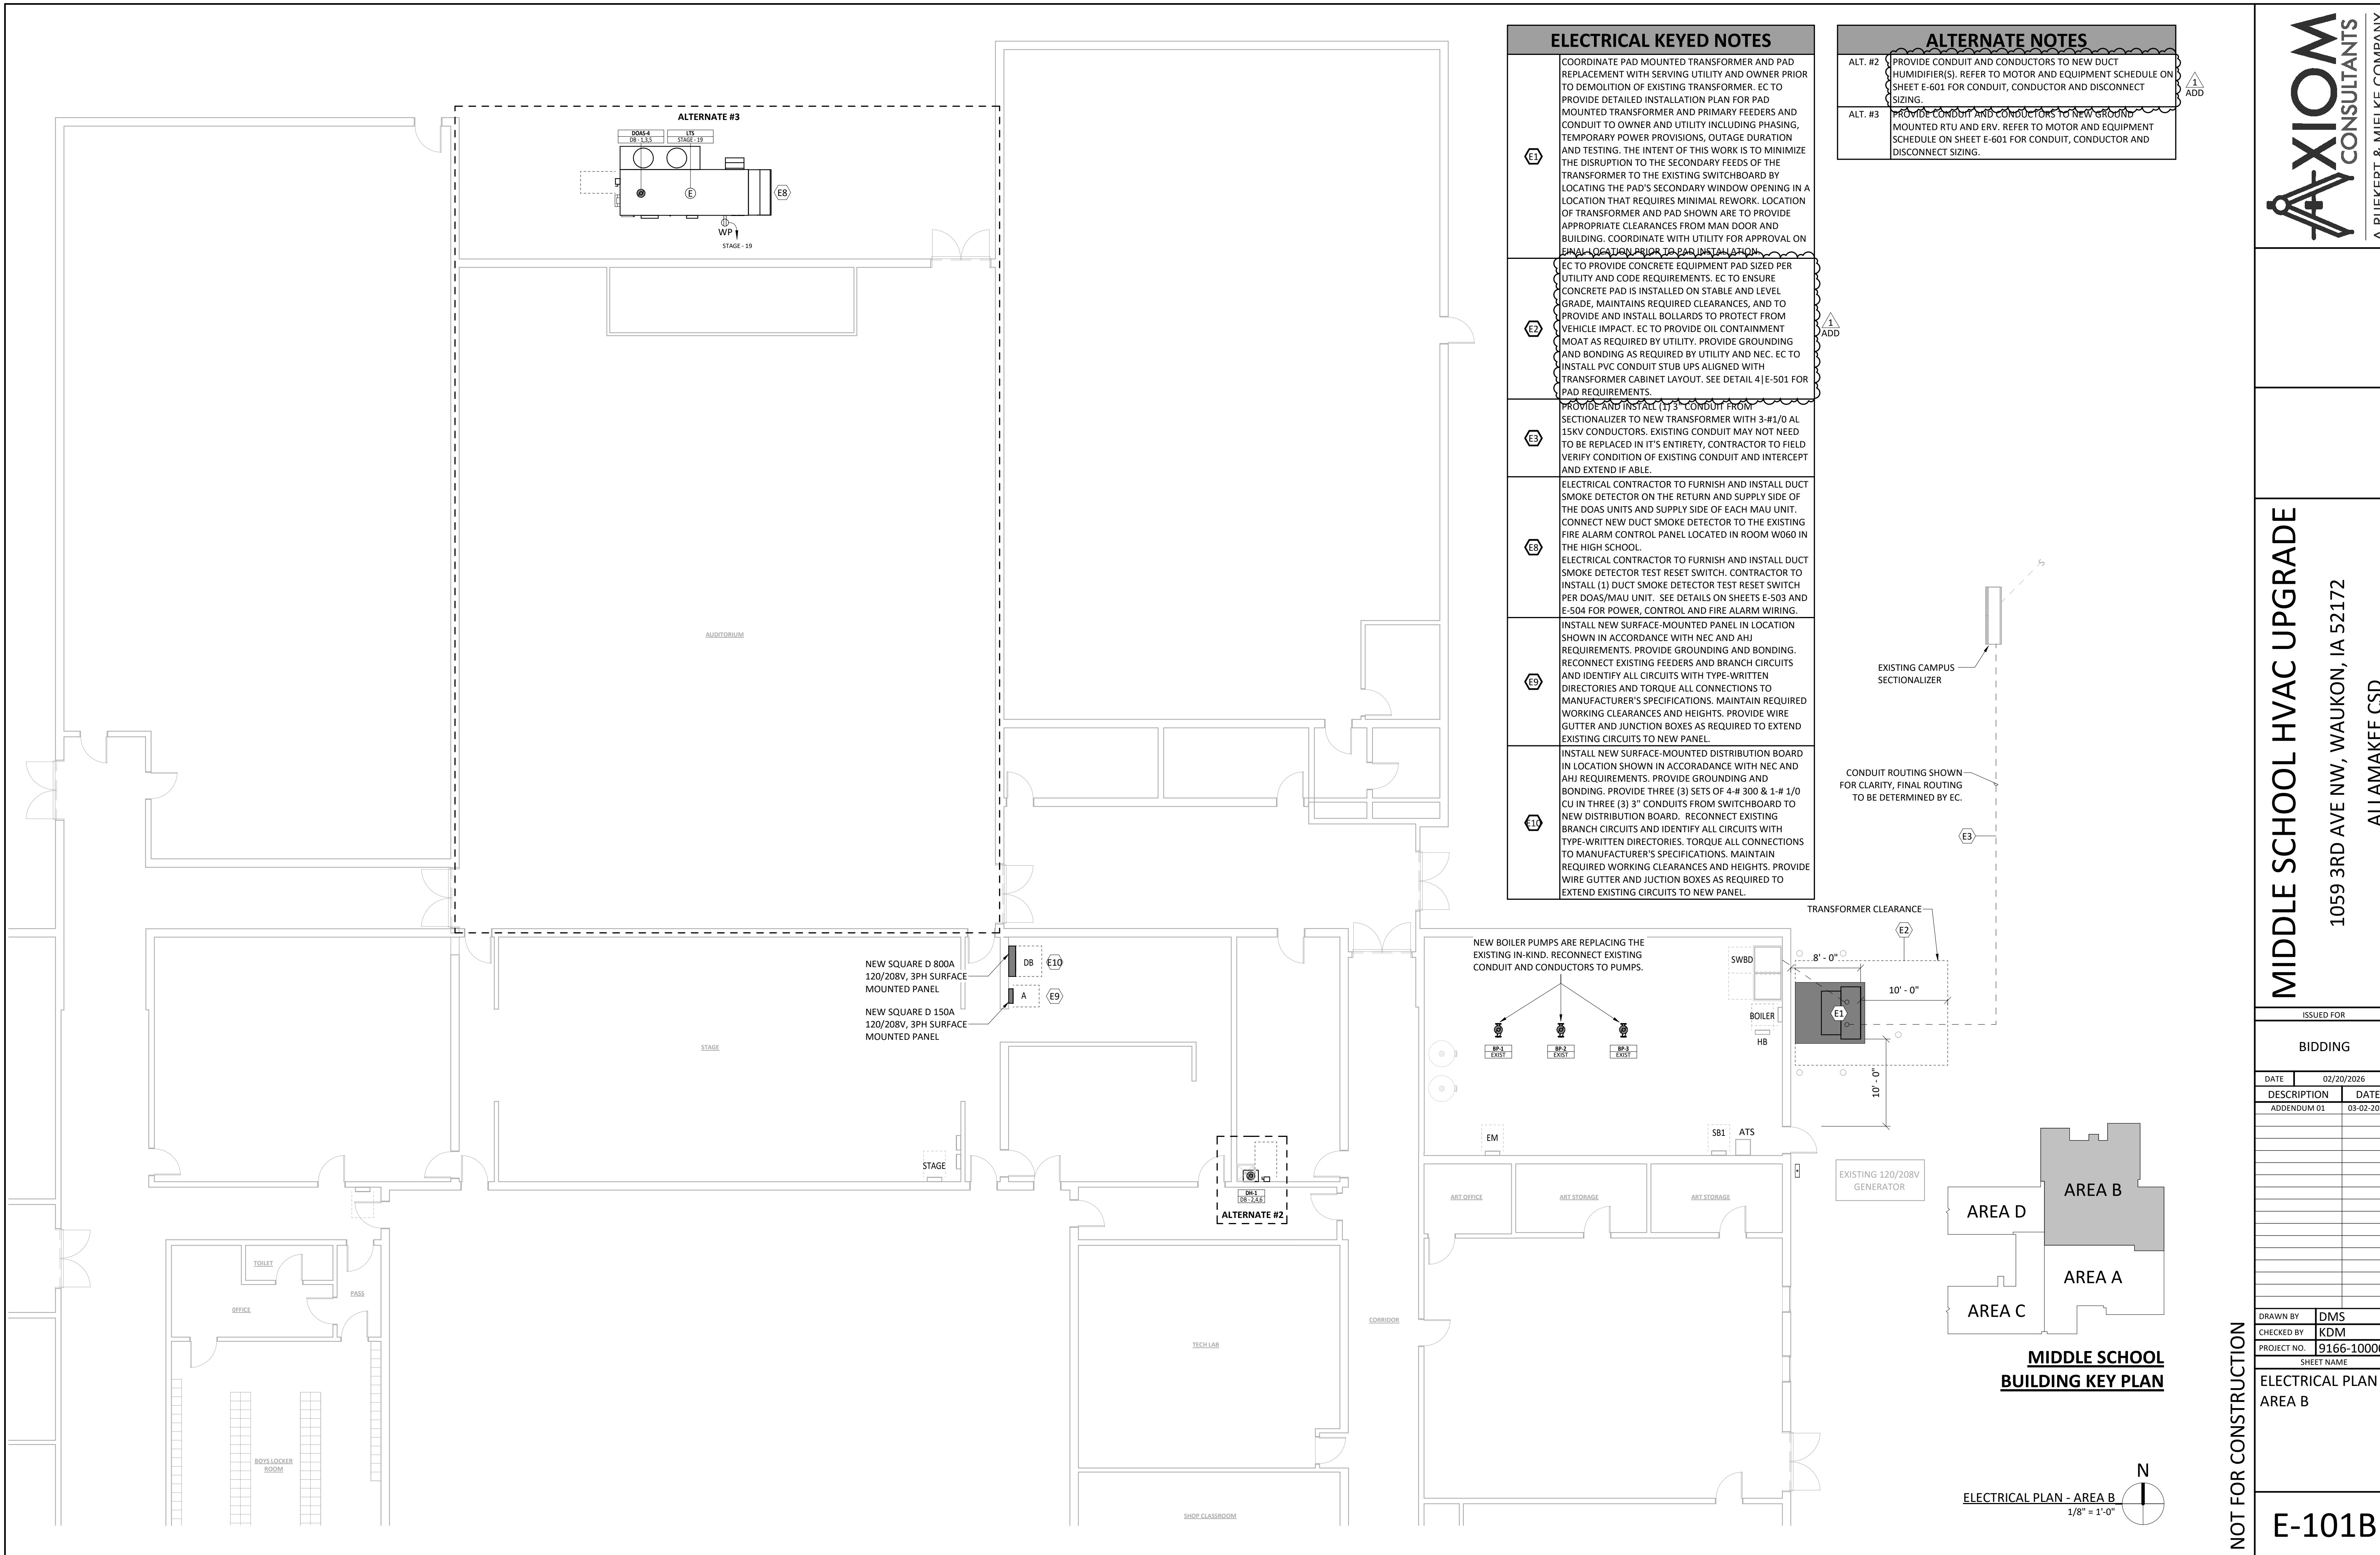


ELECTRICAL KEYED NOTES

- E1 COORDINATE PAD MOUNTED TRANSFORMER AND PAD REPLACEMENT WITH SERVING UTILITY AND OWNER PRIOR TO DEMOLITION OF EXISTING TRANSFORMER. EC TO PROVIDE DETAILED INSTALLATION PLAN FOR PAD MOUNTED TRANSFORMER AND PRIMARY FEEDERS AND CONDUIT TO OWNER AND UTILITY INCLUDING PHASING, TEMPORARY POWER PROVISIONS, OUTAGE DURATION AND TESTING. THE INTENT OF THIS WORK IS TO MINIMIZE THE DISRUPTION TO THE SECONDARY FEEDS OF THE TRANSFORMER TO THE EXISTING SWITCHBOARD BY LOCATING THE PAD'S SECONDARY WINDOW OPENING IN A LOCATION THAT REQUIRES MINIMAL REWORK. LOCATION OF TRANSFORMER AND PAD SHOWN ARE TO PROVIDE APPROPRIATE CLEARANCES FROM MAN DOOR AND BUILDING. COORDINATE WITH UTILITY FOR APPROVAL ON FINAL LOCATION PRIOR TO PAD INSTALLATION.
- E2 EC TO PROVIDE CONCRETE EQUIPMENT PAD SIZED PER UTILITY AND CODE REQUIREMENTS. EC TO ENSURE CONCRETE PAD IS INSTALLED ON STABLE AND LEVEL GRADE, MAINTAINS REQUIRED CLEARANCES, AND TO PROVIDE AND INSTALL BOLLARDS TO PROTECT FROM VEHICLE IMPACT. EC TO PROVIDE OIL CONTAINMENT MOAT AS REQUIRED BY UTILITY. PROVIDE GROUNDING AND BONDING AS REQUIRED BY UTILITY AND NEC. EC TO INSTALL PVC CONDUIT STUB UPS ALIGNED WITH TRANSFORMER CABINET LAYOUT. SEE DETAIL 4|E-501 FOR PAD REQUIREMENTS.
- E3 PROVIDE AND INSTALL (1) 3" CONDUIT FROM SECTIONALIZER TO NEW TRANSFORMER WITH 3-#1/0 AL 15KV CONDUCTORS. EXISTING CONDUIT MAY NOT NEED TO BE REPLACED IN IT'S ENTIRETY, CONTRACTOR TO FIELD VERIFY CONDITION OF EXISTING CONDUIT AND INTERCEPT AND EXTEND IF ABLE.
- E8 ELECTRICAL CONTRACTOR TO FURNISH AND INSTALL DUCT SMOKE DETECTOR ON THE RETURN AND SUPPLY SIDE OF THE DOAS UNITS AND SUPPLY SIDE OF EACH MAU UNIT. CONNECT NEW DUCT SMOKE DETECTOR TO THE EXISTING FIRE ALARM CONTROL PANEL LOCATED IN ROOM W060 IN THE HIGH SCHOOL.
- E9 ELECTRICAL CONTRACTOR TO FURNISH AND INSTALL DUCT SMOKE DETECTOR TEST RESET SWITCH. CONTRACTOR TO INSTALL (1) DUCT SMOKE DETECTOR TEST RESET SWITCH PER DOAS/MAU UNIT. SEE DETAILS ON SHEETS E-503 AND E-504 FOR POWER, CONTROL AND FIRE ALARM WIRING.
- E10 INSTALL NEW SURFACE-MOUNTED PANEL IN LOCATION SHOWN IN ACCORDANCE WITH NEC AND AHJ REQUIREMENTS. PROVIDE GROUNDING AND BONDING. RECONNECT EXISTING FEEDERS AND BRANCH CIRCUITS AND IDENTIFY ALL CIRCUITS WITH TYPE-WRITTEN DIRECTORIES AND TORQUE ALL CONNECTIONS TO MANUFACTURER'S SPECIFICATIONS. MAINTAIN REQUIRED WORKING CLEARANCES AND HEIGHTS. PROVIDE WIRE GUTTER AND JUNCTION BOXES AS REQUIRED TO EXTEND EXISTING CIRCUITS TO NEW PANEL.
- E11 INSTALL NEW SURFACE-MOUNTED DISTRIBUTION BOARD IN LOCATION SHOWN IN ACCORDANCE WITH NEC AND AHJ REQUIREMENTS. PROVIDE GROUNDING AND BONDING. PROVIDE THREE (3) SETS OF 4-# 300 & 1-# 1/0 CU IN THREE (3) 3" CONDUITS FROM SWITCHBOARD TO NEW DISTRIBUTION BOARD. RECONNECT EXISTING BRANCH CIRCUITS AND IDENTIFY ALL CIRCUITS WITH TYPE-WRITTEN DIRECTORIES. TORQUE ALL CONNECTIONS TO MANUFACTURER'S SPECIFICATIONS. MAINTAIN REQUIRED WORKING CLEARANCES AND HEIGHTS. PROVIDE WIRE GUTTER AND JUNCTION BOXES AS REQUIRED TO EXTEND EXISTING CIRCUITS TO NEW PANEL.

ALTERNATE NOTES



- ALT. #2 PROVIDE CONDUIT AND CONDUCTORS TO NEW DUCT HUMIDIFIER(S). REFER TO MOTOR AND EQUIPMENT SCHEDULE ON SHEET E-601 FOR CONDUIT, CONDUCTOR AND DISCONNECT SIZING.
- ALT. #3 PROVIDE CONDUIT AND CONDUCTORS TO NEW GROUND MOUNTED RTU AND ERV. REFER TO MOTOR AND EQUIPMENT SCHEDULE ON SHEET E-601 FOR CONDUIT, CONDUCTOR AND DISCONNECT SIZING.

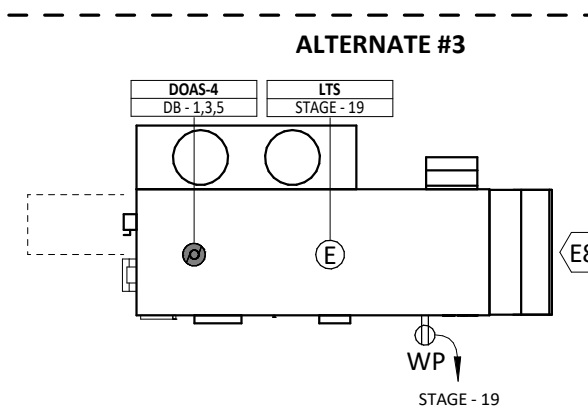

NEW SQUARE D 900A
120/208V, 3PH SURFACE
MOUNTED PANEL

NEW SQUARE D 150A
120/208V, 3PH SURFACE
MOUNTED PANEL

NEW BOILER PUMPS ARE REPLACING THE
EXISTING IN-KIND. RECONNECT EXISTING
CONDUIT AND CONDUCTORS TO PUMPS.

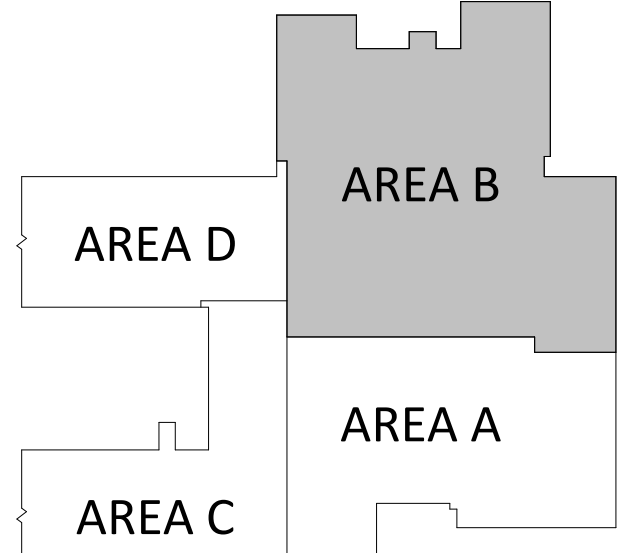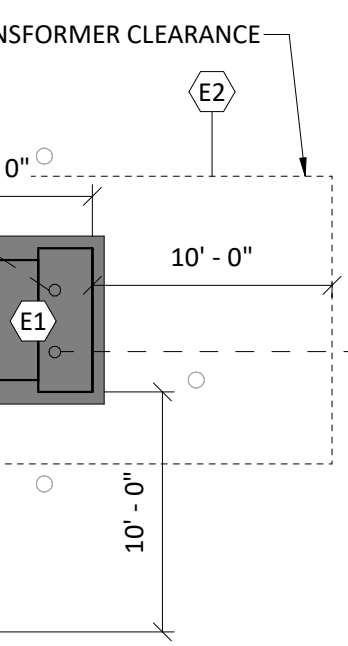


**MIDDLE SCHOOL
BUILDING KEY PLAN**

ELECTRICAL PLAN - AREA B
1/8" = 1'-0"

NOT FOR CONSTRUCTION

ISSUED FOR	
BIDDING	
DATE	02/20/2026
DESCRIPTION	DATE
ADDENDUM 01	03-02-2026
DRAWN BY: DMS	
CHECKED BY: KDM	
PROJECT NO.: 9166-10000	
SHEET NAME	
ELECTRICAL PLAN - AREA B	
E-101B	

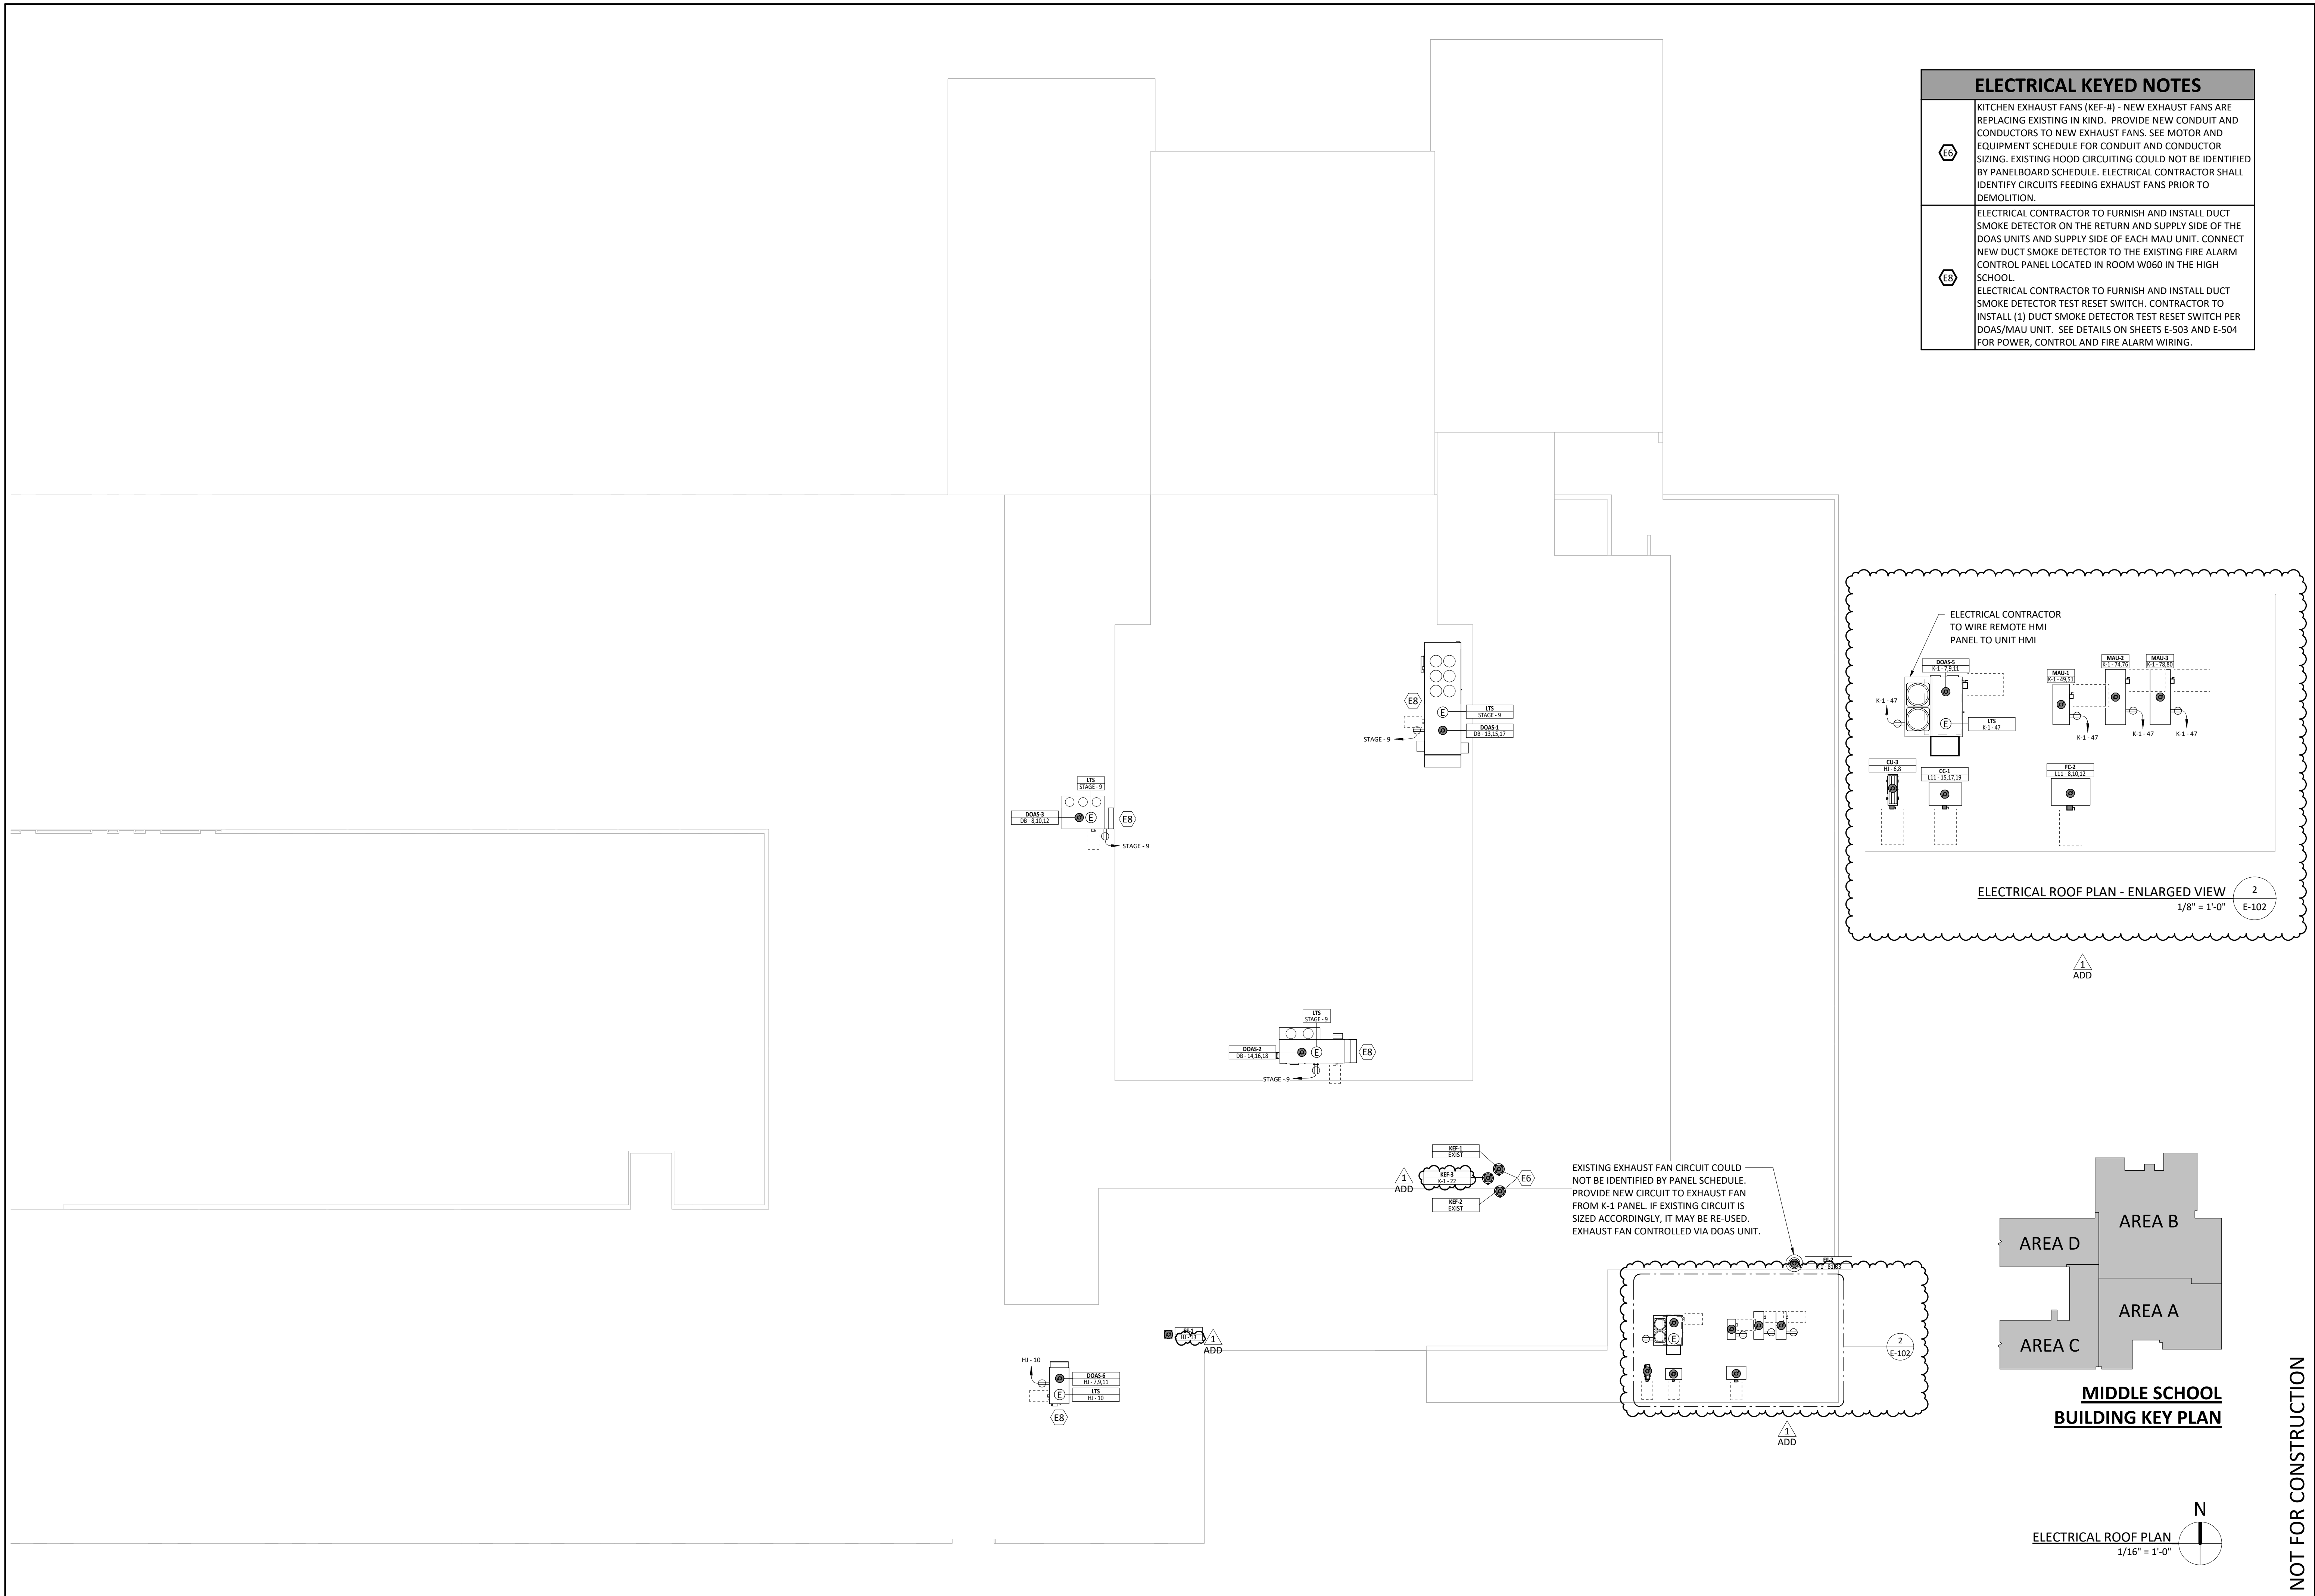


ELECTRICAL KEYED NOTES

EG KITCHEN EXHAUST FANS (KEF-#) - NEW EXHAUST FANS ARE REPLACING EXISTING IN KIND. PROVIDE NEW CONDUIT AND CONDUCTORS TO NEW EXHAUST FANS. SEE MOTOR AND EQUIPMENT SCHEDULE FOR CONDUIT AND CONDUCTOR SIZING. EXISTING HOOD CIRCUITING COULD NOT BE IDENTIFIED BY PANELBOARD SCHEDULE. ELECTRICAL CONTRACTOR SHALL IDENTIFY CIRCUITS FEEDING EXHAUST FANS PRIOR TO DEMOLITION.


EG ELECTRICAL CONTRACTOR TO FURNISH AND INSTALL DUCT SMOKE DETECTOR ON THE RETURN AND SUPPLY SIDE OF THE DOAS UNITS AND SUPPLY SIDE OF EACH MAU UNIT. CONNECT NEW DUCT SMOKE DETECTOR TO THE EXISTING FIRE ALARM CONTROL PANEL LOCATED IN ROOM W060 IN THE HIGH SCHOOL.

EG ELECTRICAL CONTRACTOR TO FURNISH AND INSTALL DUCT SMOKE DETECTOR TEST RESET SWITCH. CONTRACTOR TO INSTALL (1) DUCT SMOKE DETECTOR TEST RESET SWITCH PER DOAS/MAU UNIT. SEE DETAILS ON SHEETS E-503 AND E-504 FOR POWER, CONTROL AND FIRE ALARM WIRING.

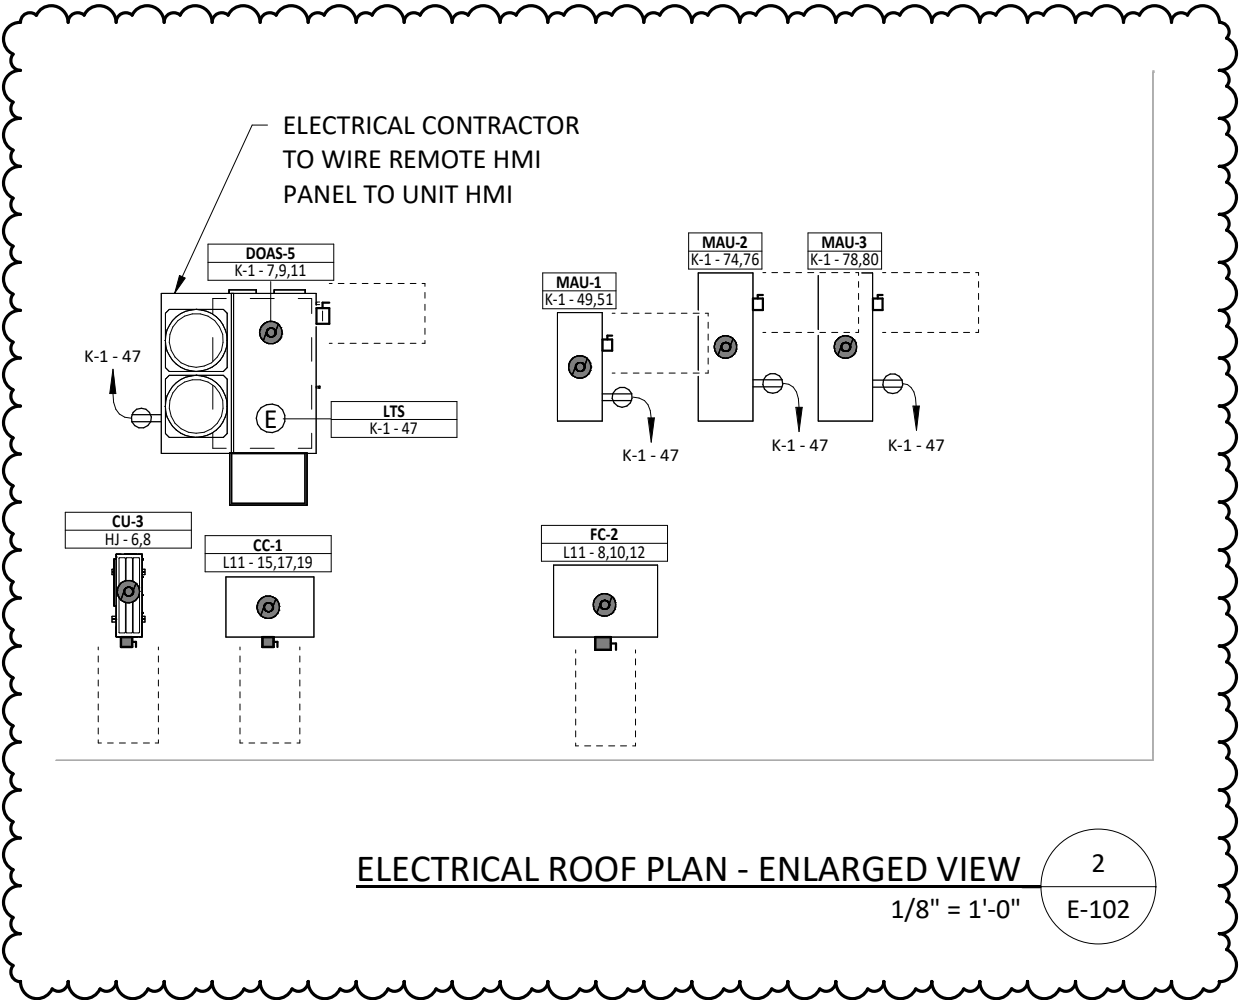

ADD **EXIST** **EG**

EXISTING EXHAUST FAN CIRCUIT COULD NOT BE IDENTIFIED BY PANEL SCHEDULE. PROVIDE NEW CIRCUIT TO EXHAUST FAN FROM K-1 PANEL. IF EXISTING CIRCUIT IS SIZED ACCORDINGLY, IT MAY BE RE-USED. EXHAUST FAN CONTROLLED VIA DOAS UNIT.

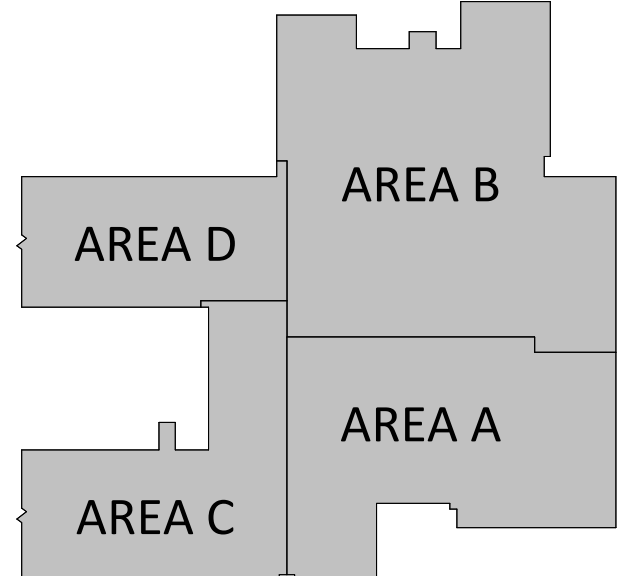

ELECTRICAL ROOF PLAN
1/16" = 1'-0"

ISSUED FOR



BIDDING

DATE	DESCRIPTION	DATE
02/20/2026		
03-02-2026	ADDENDUM 01	

DRAWN BY	SMF
CHECKED BY	KDM
PROJECT NO.	9166-10000
SHEET NAME	ELECTRICAL ROOF PLAN


NOT FOR CONSTRUCTION

REFER TO SPECIFICATION SECTION 01100 SUMMARY, COVER PAGE
AND ENLARGED PLANS FOR SCOPE OF WORK FOR ALTERNATES

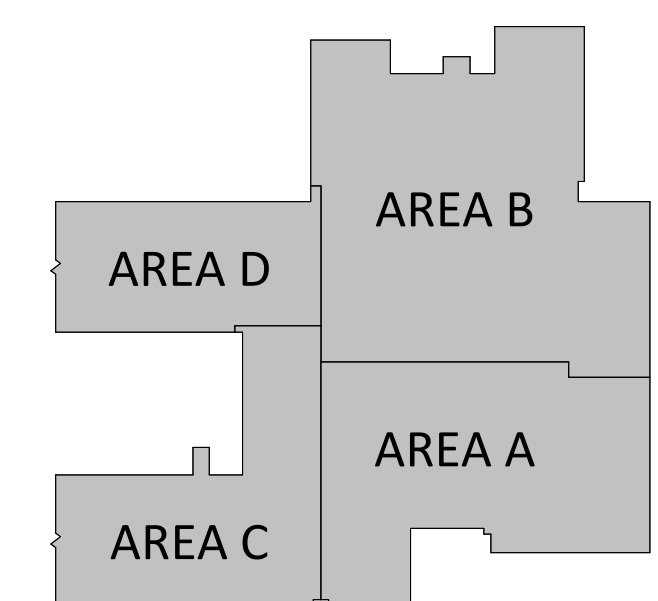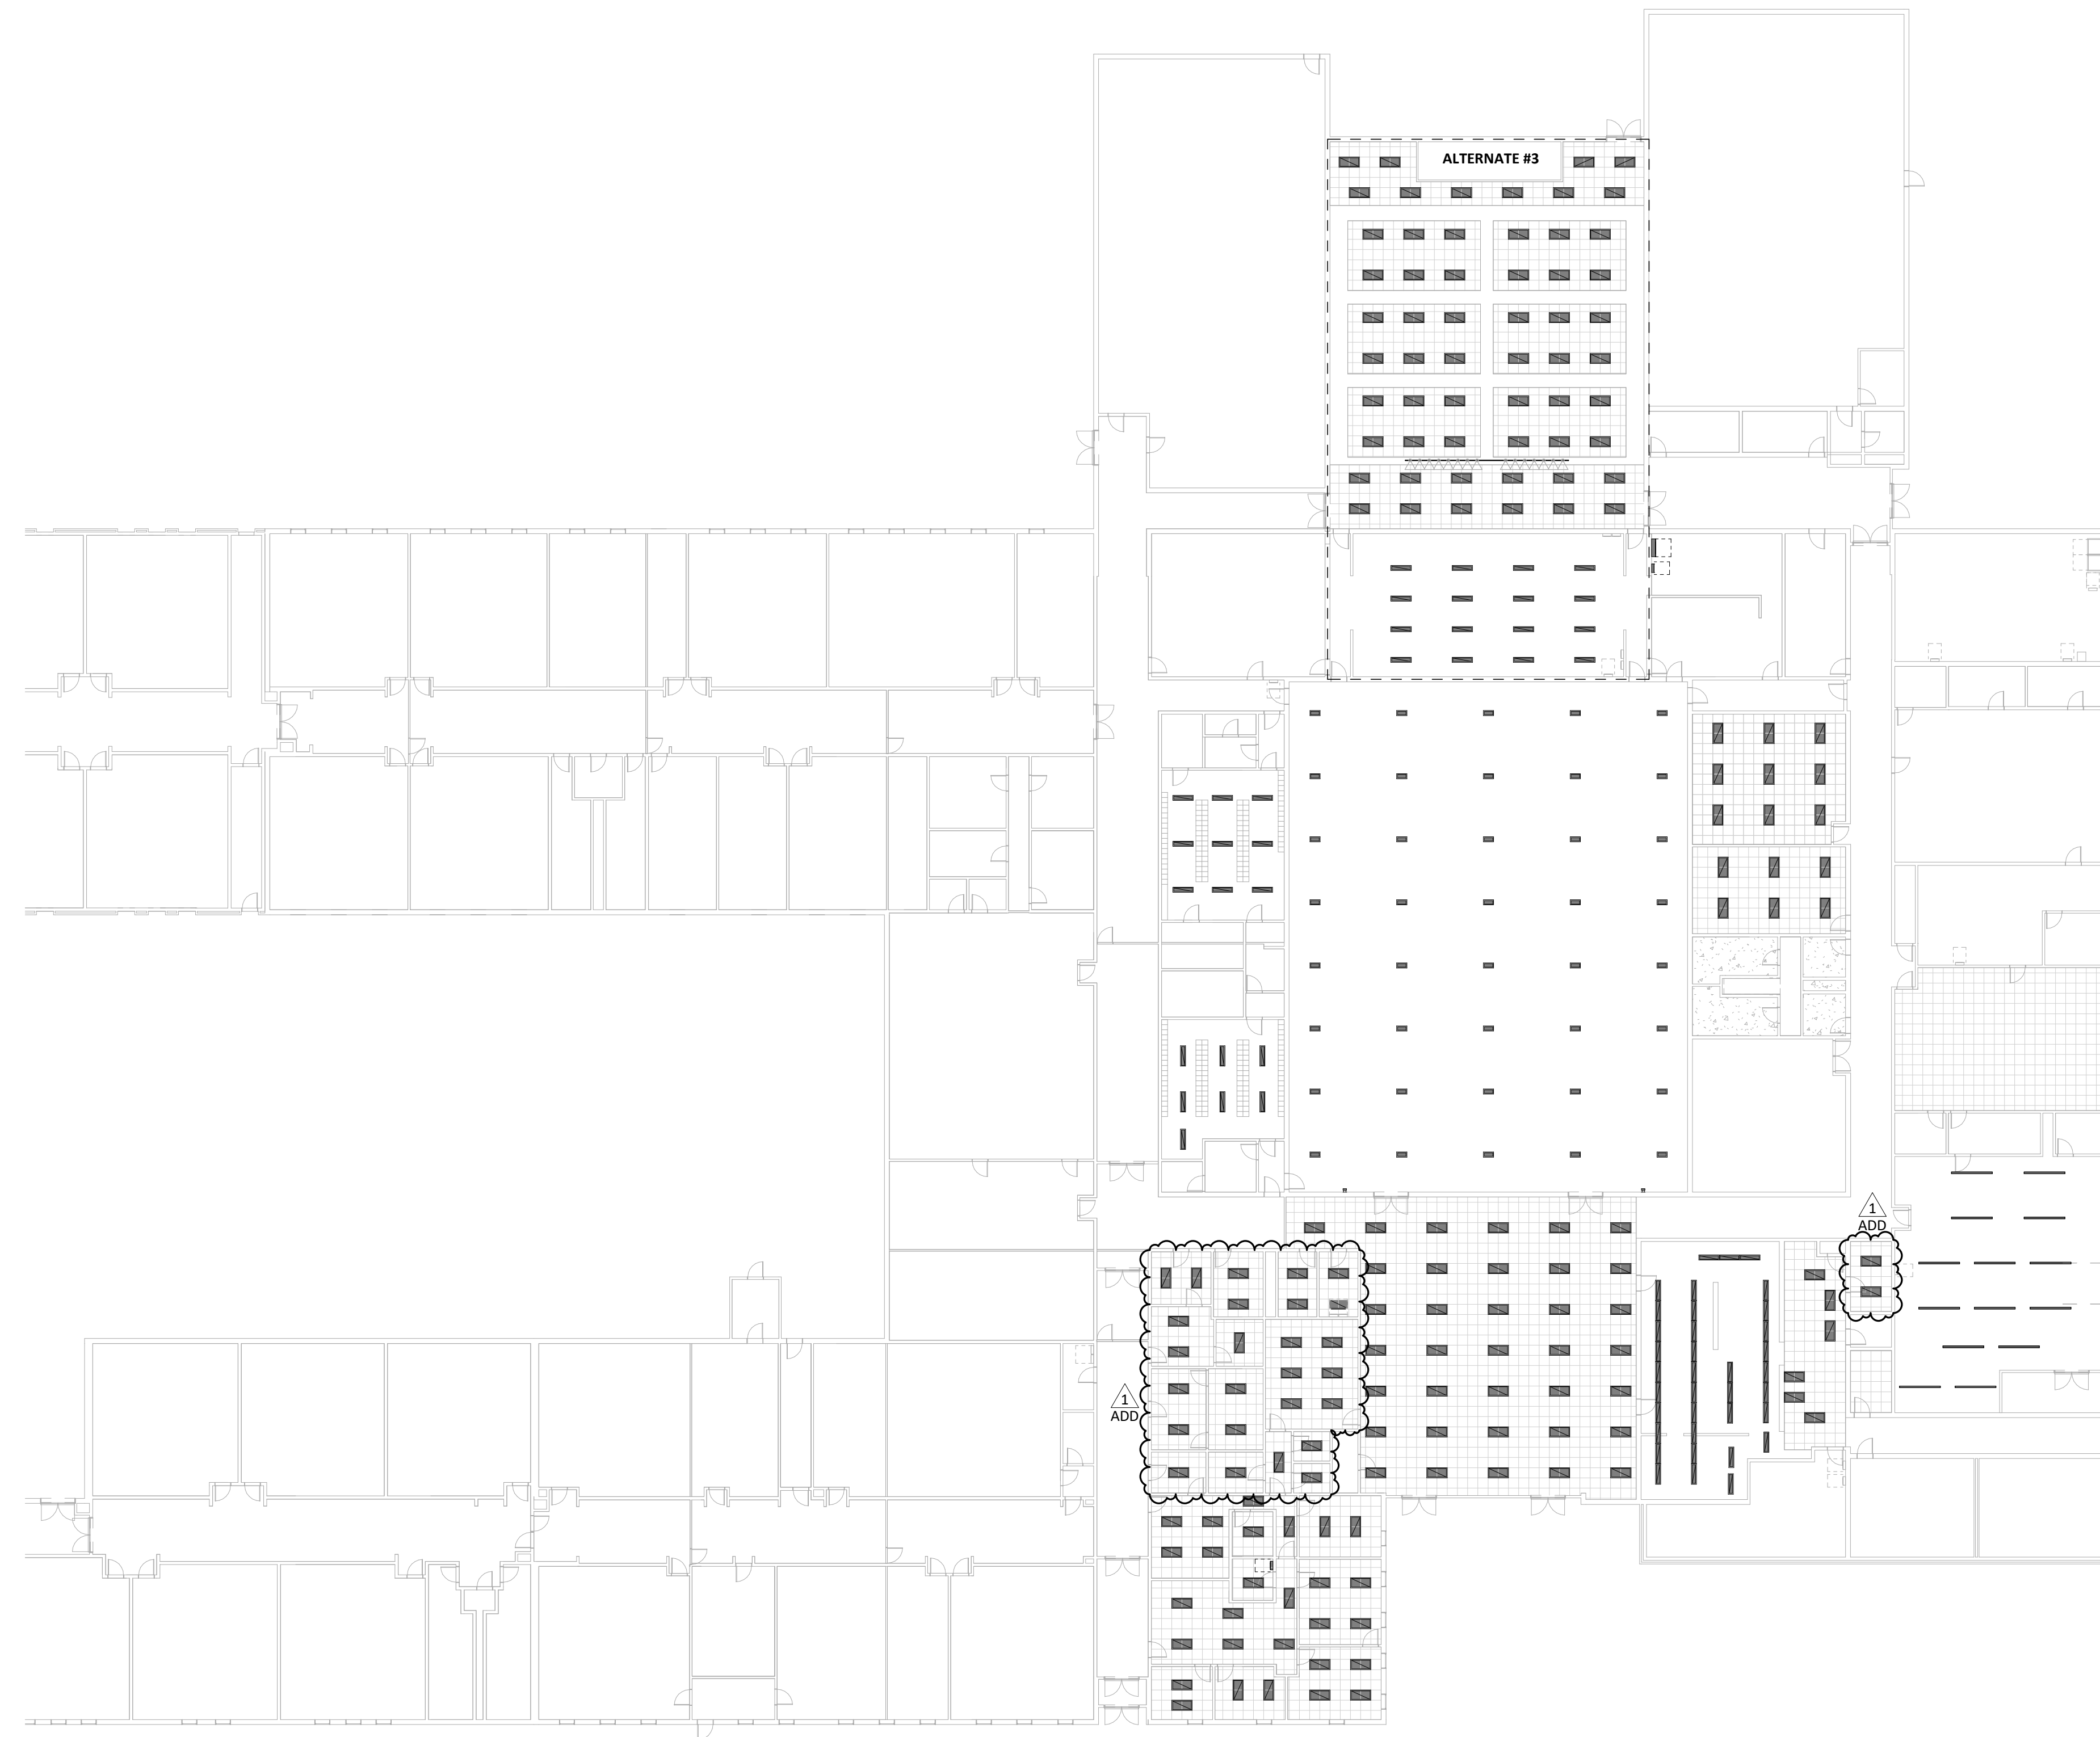

**MIDDLE SCHOOL
BUILDING KEY PLAN**

LIGHTING PLAN - OVERALL
3/64" = 1'-0"

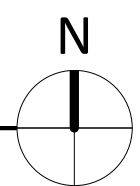

MIDDLE SCHOOL HVAC UPGRADE

1059 3RD AVE NW, WAUKON, IA 52172

ALLAMAKEE CSD

ISSUED FOR
BIDDING

DATE	02/20/2026
DESCRIPTION	DATE
ADDENDUM 01	03-02-2026


DRAWN BY	SMF
CHECKED BY	KDM
PROJECT NO.	9166-10000
SHEET NAME	

LIGHTING PLAN -
OVERALL

NOT FOR CONSTRUCTION



REFLECTED CEILING PLAN NOTES	
1	CONTRACTOR SHALL REMOVE ALL CEILING MOUNTED DEVICES AND STORE FOR RE-INSTALLATION ONCE CEILING WORK IS COMPLETED. THIS INCLUDES LIGHTING, FIRE ALARM, WIRELESS ACCESS POINTS AND OTHER CEILING MOUNTED DEVICES. THESE DEVICES ARE DENOTED WITH "R-R", ALL DEVICES MAY NOT BE SHOWN. EXTEND WIRING AND CONDUIT TO DEVICES AS REQUIRED FOR OPERATION. CONTRACTOR SHALL FAMILIARIZE THEMSELVES WITH THE BUILDING PRIOR TO BIDDING TO EVALUATE THE NUMBER AND TYPES OF DEVICES TO BE RE-INSTALLED. WHERE NEW SPEAKERS ARE SHOWN, PROVIDE AND INSTALL NEW SPEAKERS AND TIE INTO EXISTING SPEAKER WIRING. ONCE NEW CEILING HAS BEEN INSTALLED, RE-INSTALL DEVICES IN NEW CEILING.
2	PROVIDE NEW CONTROLS IN ALL ROOMS PROVIDED WITH NEW LIGHTING. PROVIDE CONTROL WIRING, SENSORS, SWITCHES, ROOM CONTROLLERS, POWER PACKS AND CONDUIT AS REQUIRED FOR OPERATION.
3	EXISTING CEILING MOUNTED SPEAKER TO BE DEMOED IN CAFETERIA AND ADMIN AREA. NEW SPEAKERS SHALL BE A 2X2 DROP IN CEILING SPEAKER, 70V, PLENUM RATED. CONFIRM EXISTING SPEAKER VOLTAGE AND TAP SETTINGS PRIOR TO ORDERING. BASIS OF DESIGN: LEGRAND CG41509
4	GYMNASIUM LIGHTING IS CONTROLLED THROUGH AN EXISTING MIGHT RELAY PANEL. PRIOR TO ORDERING OCCUPANCY SENSORS, CONFIRM SENSORS WILL INTEGRATE WITH EXISTING CONTROL PANEL.
5	ELECTRICAL CONTRACTOR TO FURNISH AND INSTALL NEW SMOKE DETECTOR COMPATIBLE WITH THE EXISTING "NOTIFIER" FIRE ALARM SYSTEM. CONNECT NEW SMOKE DETECTORS TO THE EXISTING FIRE ALARM CONTROL PANEL. FIRE ALARM CONTROL PANEL LOCATED IN ROOM W060.
6	ELECTRICAL CONTRACTOR TO FURNISH AND INSTALL NEW BEAM DETECTORS IN GYMNASIUM. PROVIDE DETECTORS THAT ARE COMPATIBLE WITH EXISTING "NOTIFIER" FIRE ALARM SYSTEM. CONNECT NEW BEAM DETECTORS TO THE EXISTING FIRE ALARM CONTROL PANEL. CONTROL PANEL LOCATED IN ROOM W060 IN HIGH SCHOOL.
7	ALL PLATES SHALL BE STAINLESS STEEL. PROVIDE DUAL GANG PLATES WHERE REQUIRED

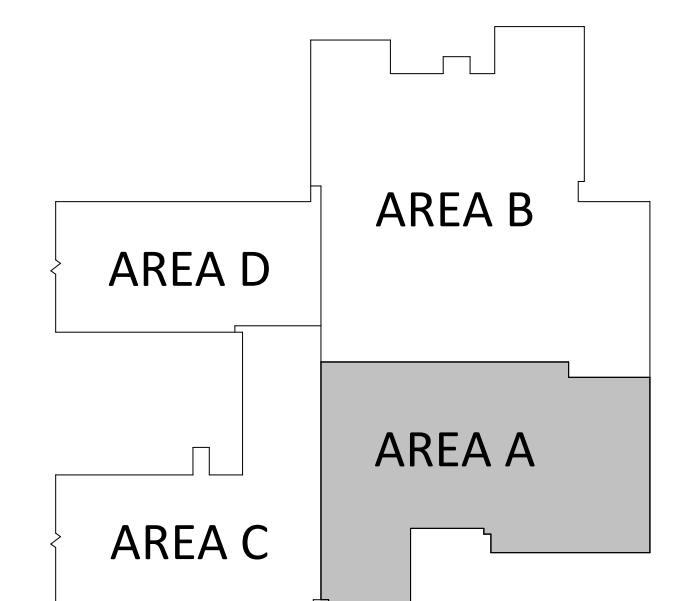

MIDDLE SCHOOL BUILDING KEY PLAN


LIGHTING PLAN - AREA A
1/8" = 1'-0"

ISSUED FOR	BIDDING
DATE	02/20/2026
DESCRIPTION	DATE
ADDENDUM 01	03-02-2026

DRAWN BY	SMF
CHECKED BY	KDM
PROJECT NO.	9166-10000
SHEET NAME	

LIGHTING PLAN - AREA A


NOT FOR CONSTRUCTION

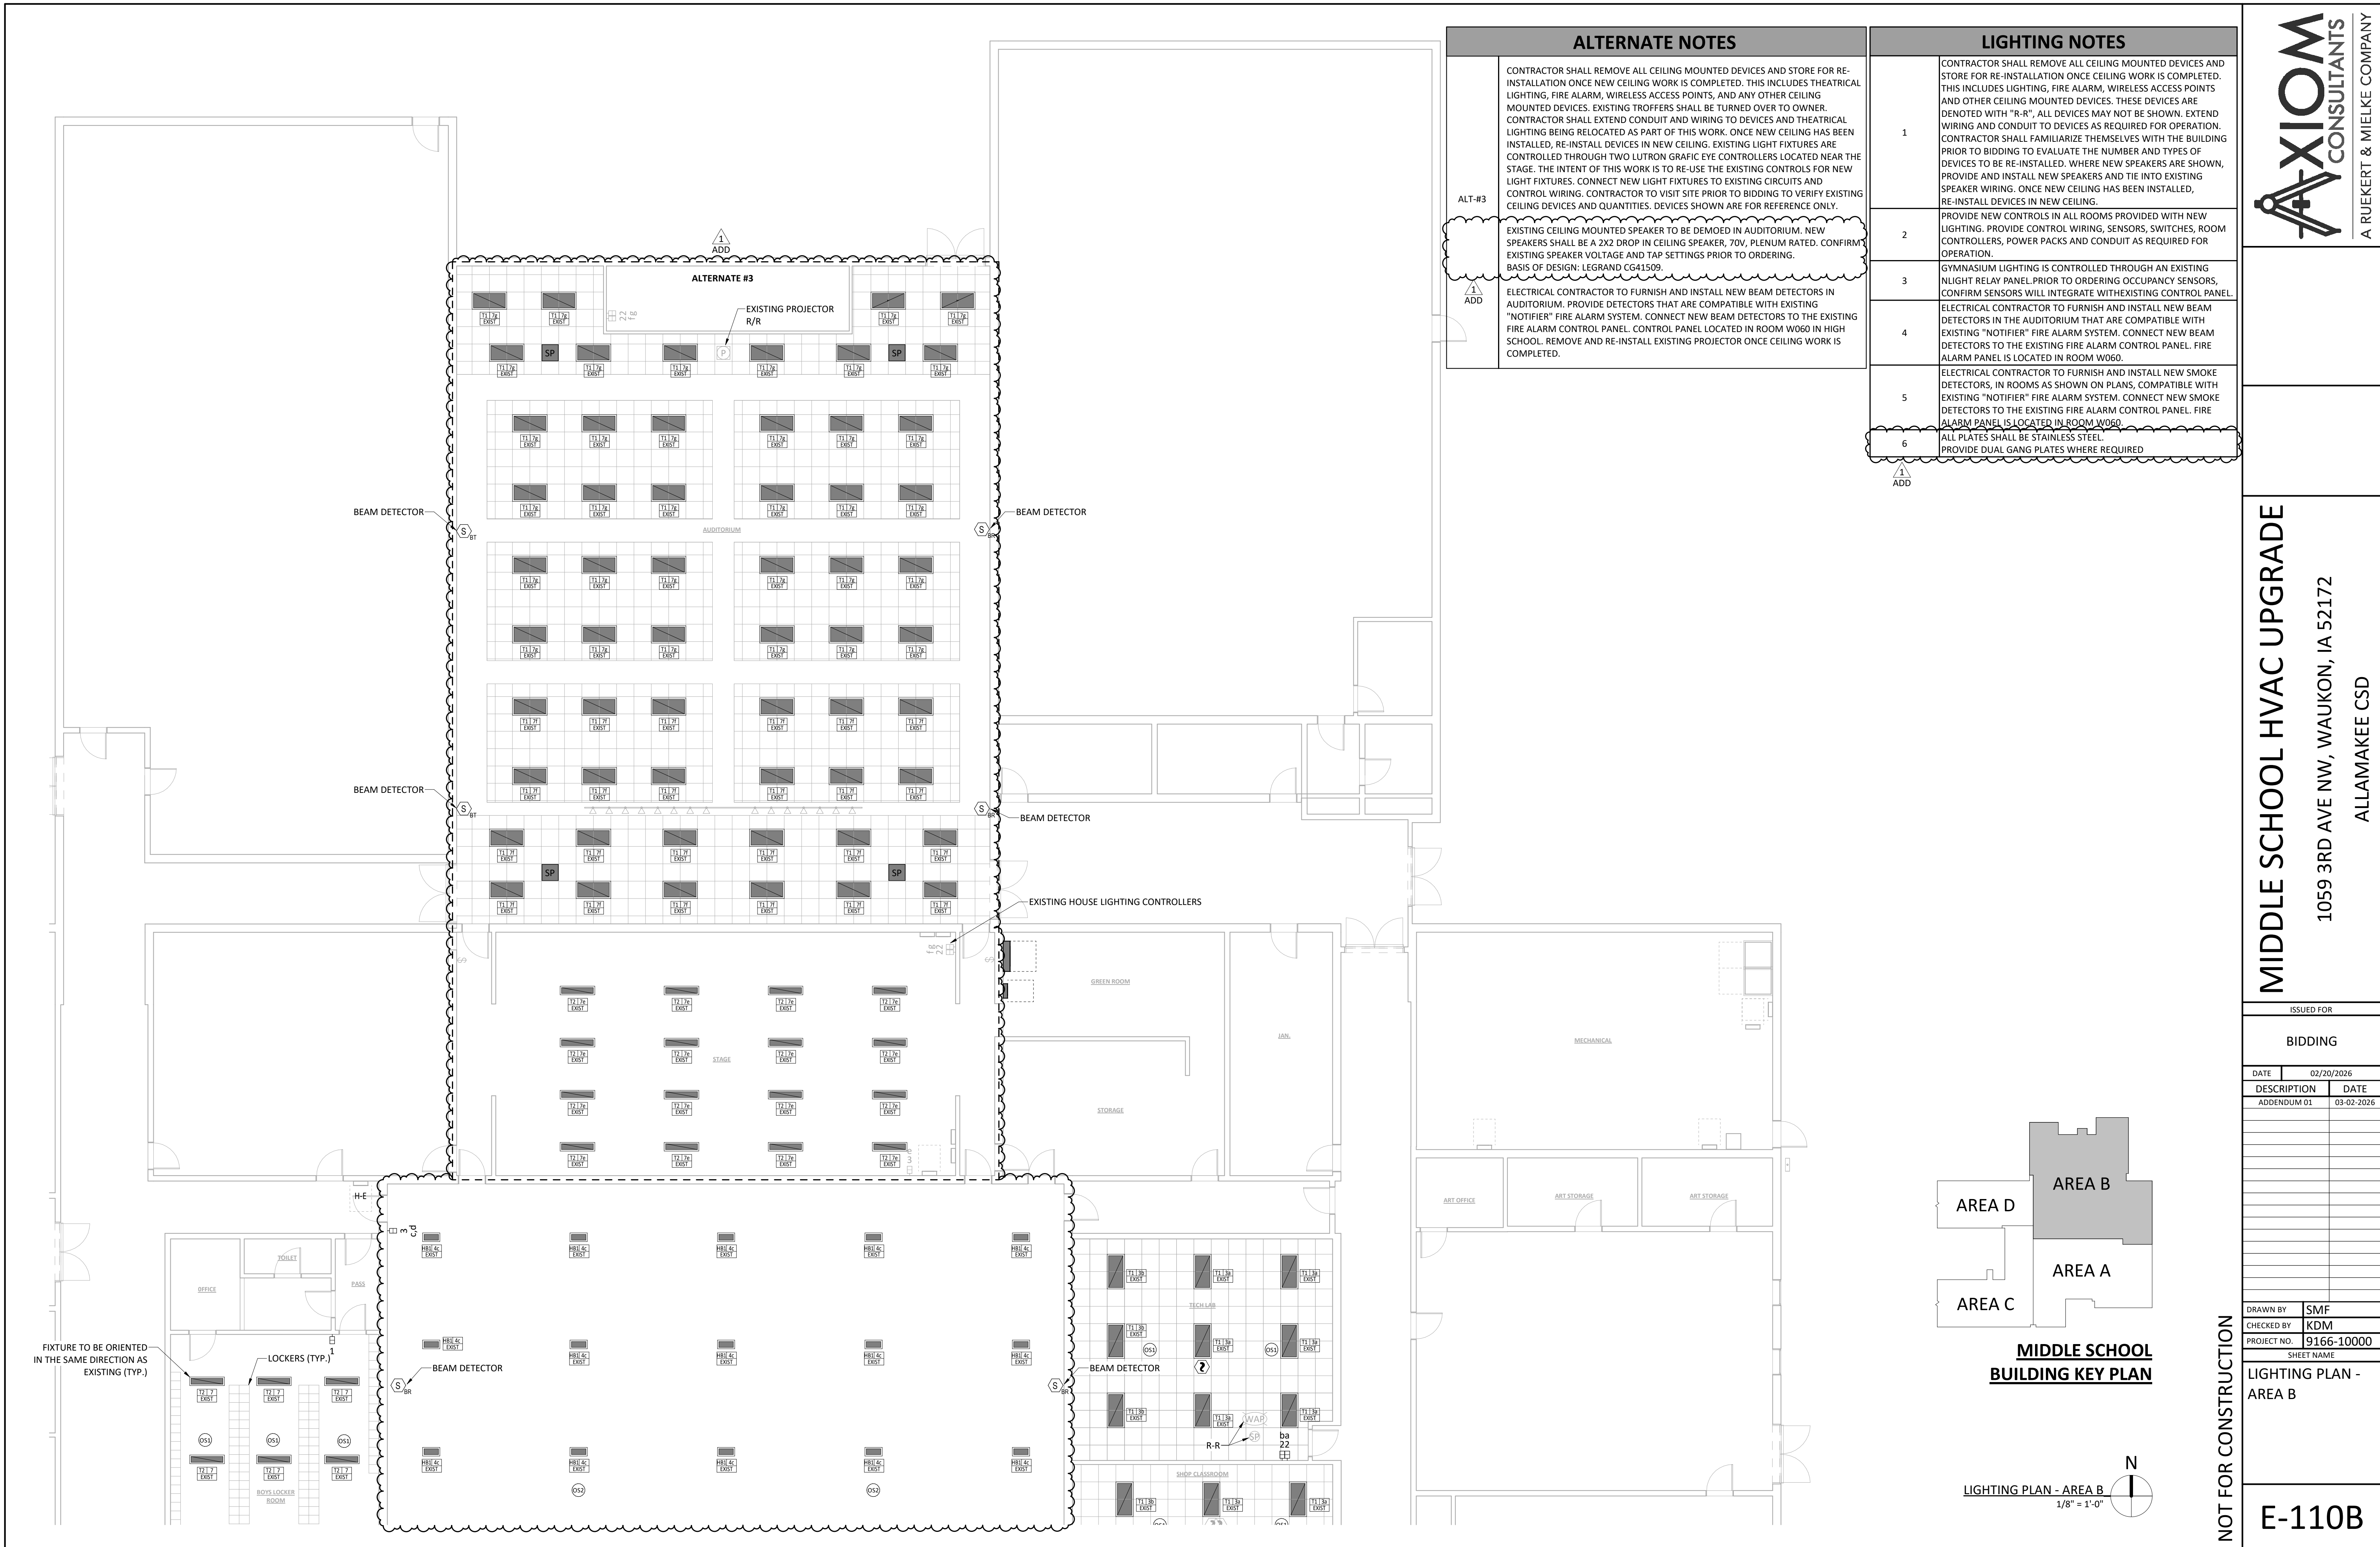

ALTERNATE NOTES	
ALT-#3	CONTRACTOR SHALL REMOVE ALL CEILING MOUNTED DEVICES AND STORE FOR RE-INSTALLATION ONCE NEW CEILING WORK IS COMPLETED. THIS INCLUDES THEATRICAL LIGHTING, FIRE ALARM, WIRELESS ACCESS POINTS, AND ANY OTHER CEILING MOUNTED DEVICES. EXISTING TROFFERS SHALL BE TURNED OVER TO OWNER. CONTRACTOR SHALL EXTEND CONDUIT AND WIRING TO DEVICES AND THEATRICAL LIGHTING BEING RELOCATED AS PART OF THIS WORK. ONCE NEW CEILING HAS BEEN INSTALLED, RE-INSTALL DEVICES IN NEW CEILING. EXISTING LIGHT FIXTURES ARE CONTROLLED THROUGH TWO LUTRON GRAFIC EYE CONTROLLERS LOCATED NEAR THE STAGE. THE INTENT OF THIS WORK IS TO RE-USE THE EXISTING CONTROLS FOR NEW LIGHT FIXTURES. CONNECT NEW LIGHT FIXTURES TO EXISTING CIRCUITS AND CONTROL WIRING. CONTRACTOR TO VISIT SITE PRIOR TO BIDDING TO VERIFY EXISTING CEILING DEVICES AND QUANTITIES. DEVICES SHOWN ARE FOR REFERENCE ONLY.
ADD	EXISTING CEILING MOUNTED SPEAKER TO BE DEMOED IN AUDITORIUM. NEW SPEAKERS SHALL BE A 2X2 DROP IN CEILING SPEAKER, 70V, PLENUM RATED. CONFIRM EXISTING SPEAKER VOLTAGE AND TAP SETTINGS PRIOR TO ORDERING. BASIS OF DESIGN: LEGRAND CG41509.
ADD	ELECTRICAL CONTRACTOR TO FURNISH AND INSTALL NEW BEAM DETECTORS IN AUDITORIUM. PROVIDE DETECTORS THAT ARE COMPATIBLE WITH EXISTING "NOTIFIER" FIRE ALARM SYSTEM. CONNECT NEW BEAM DETECTORS TO THE EXISTING FIRE ALARM CONTROL PANEL. CONTROL PANEL LOCATED IN ROOM W060 IN HIGH SCHOOL. REMOVE AND RE-INSTALL EXISTING PROJECTOR ONCE CEILING WORK IS COMPLETED.

LIGHTING NOTES	
1	CONTRACTOR SHALL REMOVE ALL CEILING MOUNTED DEVICES AND STORE FOR RE-INSTALLATION ONCE CEILING WORK IS COMPLETED. THIS INCLUDES LIGHTING, FIRE ALARM, WIRELESS ACCESS POINTS AND OTHER CEILING MOUNTED DEVICES. THESE DEVICES ARE DENOTED WITH "R-R", ALL DEVICES MAY NOT BE SHOWN. EXTEND WIRING AND CONDUIT TO DEVICES AS REQUIRED FOR OPERATION. CONTRACTOR SHALL FAMILIARIZE THEMSELVES WITH THE BUILDING PRIOR TO BIDDING TO EVALUATE THE NUMBER AND TYPES OF DEVICES TO BE RE-INSTALLED. WHERE NEW SPEAKERS ARE SHOWN, PROVIDE AND INSTALL NEW SPEAKERS AND TIE INTO EXISTING SPEAKER WIRING. ONCE NEW CEILING HAS BEEN INSTALLED, RE-INSTALL DEVICES IN NEW CEILING.
2	PROVIDE NEW CONTROLS IN ALL ROOMS PROVIDED WITH NEW LIGHTING. PROVIDE CONTROL WIRING, SENSORS, SWITCHES, ROOM CONTROLLERS, POWER PACKS AND CONDUIT AS REQUIRED FOR OPERATION.
3	GYMNASIUM LIGHTING IS CONTROLLED THROUGH AN EXISTING NIGHT RELAY PANEL PRIOR TO ORDERING OCCUPANCY SENSORS, CONFIRM SENSORS WILL INTEGRATE WITH EXISTING CONTROL PANEL.
4	ELECTRICAL CONTRACTOR TO FURNISH AND INSTALL NEW BEAM DETECTORS IN THE AUDITORIUM THAT ARE COMPATIBLE WITH EXISTING "NOTIFIER" FIRE ALARM SYSTEM. CONNECT NEW BEAM DETECTORS TO THE EXISTING FIRE ALARM CONTROL PANEL. FIRE ALARM PANEL IS LOCATED IN ROOM W060.
5	ELECTRICAL CONTRACTOR TO FURNISH AND INSTALL NEW SMOKE DETECTORS, IN ROOMS AS SHOWN ON PLANS, COMPATIBLE WITH EXISTING "NOTIFIER" FIRE ALARM SYSTEM. CONNECT NEW SMOKE DETECTORS TO THE EXISTING FIRE ALARM CONTROL PANEL. FIRE ALARM PANEL IS LOCATED IN ROOM W060.
6	ALL PLATES SHALL BE STAINLESS STEEL. PROVIDE DIAL GANG PLATES WHERE REQUIRED.

ISSUED FOR	
BIDDING	
DATE	02/20/2026
DESCRIPTION	
ADDENDUM 01	03-02-2026

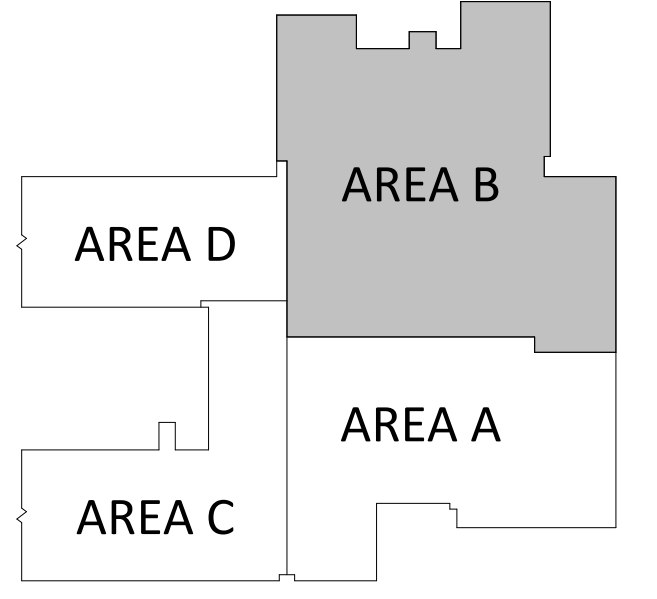

MIDDLE SCHOOL BUILDING KEY PLAN

LIGHTING PLAN - AREA B
1/8" = 1'-0"

NOT FOR CONSTRUCTION

DRAWN BY	SMF
CHECKED BY	KDM
PROJECT NO.	9166-10000
SHEET NAME	LIGHTING PLAN - AREA B

NOT FOR CONSTRUCTION

MOTOR AND EQUIPMENT SCHEDULE

NOTES: EQUIPMENT TAGS NOTED AS ## & ## ARE WIRED TO SAME CIRCUIT. AMPACITY SHOWN IS TOTAL CIRCUIT AMPS.

STARTER/DISCONNECT
E-FURNISHED BY ELECTRICAL CONTRACTOR
M-FURNISHED BY MECHANICAL CONTRACTOR

EQUIP TAG	DESCRIPTION	AMP	VOLTAGE	# OF POLES	WIRE SIZE	CONDUIT	PANEL	MCA	MOC	DISC	SW AMPS	FUSE AMPS	NEMA RATING	NOTES	REMARKS
BP-1	BOILER PUMP	6.9 A	208 V	3	3-#12, 1-#12	3/4"	HB	8.6 A	15 A	N/A					WITHIN SIGHT
BP-2	BOILER PUMP	6.9 A	208 V	3	3-#12, 1-#12	3/4"	HB	8.6 A	15 A	N/A					WITHIN SIGHT
BP-3	BOILER PUMP	6.9 A	208 V	3	3-#12, 1-#12	3/4"	HB	8.6 A	15 A	N/A					WITHIN SIGHT
CC-1	COOLER CONDENSER	14.3 A	208 V	3	3-#10, 1-#10	3/4"	L11	20 A	25 A	E	30A	NF	3R		
CE-1	COOLER EVAPORATOR	14.4 A	120 V	1	1-#12, 1-#12, 1-#12	3/4"	L11	15.5 A	20 A	E	30A	NF	3R		
CU-1 / BB-1 / UV-#	CONDENSING UNIT / UNIT VENTILLATORS	47.5 A	208 V	2	2-#4, 1-#8	1 1/4"	HJ	59.4 A	70 A	E	60A	NF	3R	4	
CU-2 / UV-#	CONDENSING UNIT / UNIT VENTILLATORS	37.2 A	208 V	2	2-#8, 1-#10	1"	HJ	46.4 A	50 A	E	60A	NF	3R	4	
CU-3 / UV-#	CONDENSING UNIT / UNIT VENTILLATORS	36.6 A	208 V	2	2-#8, 1-#10	1"	HJ	45.7 A	50 A	E	60A	NF	3R	4	
CU-4 / BB-2 / UV-#	CONDENSING UNIT / UNIT VENTILLATORS	48.0 A	208 V	2	2-#4, 1-#8	1 1/4"	HJ	60 A	70 A	E	60A	NF	3R	4	
DH-1	DUCT HUMIDIFIER	52.0 A	208 V	3	3-#4, 1-#8	1 1/4"	DB	65 A	70 A	M				2	
DH-2	DUCT HUMIDIFIER	52.0 A	208 V	3	3-#4, 1-#8	1 1/4"	H-E	65 A	70 A	M				2	
DH-3	DUCT HUMIDIFIER	52.0 A	208 V	3	3-#4, 1-#8	1 1/4"	HJ	65 A	70 A	M				2	
DOAS-1	DEDICATED OUTSIDE AIR SYSTEM	258.0 A	208 V	3	3-#350 KCMIL, 1-#4	3"	DB	268.1 A	300 A	M				1	
DOAS-2	DEDICATED OUTSIDE AIR SYSTEM	101.6 A	208 V	3	3-#1, 1-#6	2"	DB	109 A	125 A	M				1	
DOAS-3	DEDICATED OUTSIDE AIR SYSTEM	91.1 A	208 V	3	3-#1, 1-#6	2"	DB	107.7 A	125 A	M				1	
DOAS-4	DEDICATED OUTSIDE AIR SYSTEM	105.5 A	208 V	3	3-#1, 1-#6	2"	DB	112.9 A	125 A	M				1, 3	
DOAS-5	DEDICATED OUTSIDE AIR SYSTEM	49.5 A	208 V	3	3-#4, 1-#8	1 1/4"	K-1	61.9 A	70 A	M				1	
DOAS-6	DEDICATED OUTSIDE AIR SYSTEM	33.6 A	208 V	3	3-#8, 1-#10	1"	HJ	41 A	50 A	M				1	
EF-1	EXHAUST FAN	0.3 A	120 V	1	1-#12, 1-#12, 1-#12	3/4"	HJ	0.4 A	15 A	N/A					CONTROLLED VIA SWITCH
EF-2	EXHAUST FAN	7.0 A	208 V	2	2-#10, 1-#10	3/4"	K-1	8.8 A	30 A	N/A					ENERGIZED VIA RTU
EF-3	EXHAUST FAN	0.4 A	120 V	1	1-#12, 1-#12, 1-#12	3/4"	HD	0.5 A	20 A	N/A					CONTROLLED VIA SWITCH
FC-2	FREEZER CONDENSER	26.7 A	208 V	3	3-#8, 1-#10	1"	L11	32.7 A	50 A	E	60A	NF	3R		
FE-1	FREEZER EVAPORATOR	13.7 A	208 V	2	2-#12, 1-#12	3/4"	L11	13.7 A	20 A	E	30A	NF	1		TOGGLE TYPE
FE-2	FREEZER EVAPORATOR	13.7 A	208 V	2	2-#12, 1-#12	3/4"	L11	13.7 A	20 A	E	30A	NF	1		TOGGLE TYPE
KEF-3	KITCHEN EXHAUST FAN	8.7 A	120 V	1	1-#12, 1-#12, 1-#12	3/4"	K-1	10.9 A	20 A	M					
MAU-1	MAKE-UP AIR FAN	10.0 A	208 V	2	2-#12, 1-#12	3/4"	K-1	12.5 A	20 A	M					
MAU-2	MAKE-UP AIR FAN	6.9 A	208 V	2	2-#12, 1-#12	3/4"	K-1	8.63 A	20 A	M					
MAU-3	MAKE-UP AIR FAN	10.0 A	208 V	2	2-#12, 1-#12	3/4"	K-1	12.5 A	20 A	M					

- NOTES:
- UNIT PROVIDED WITH UV LAMP AND CONVENIENCE RECEPTACLE. PROVIDE 20A/1P CIRCUIT TO UNIT FOR UV AND RECEPTACLE.
 - EQUIPMENT INCLUDED UNDER ALTERNATE #2.
 - EQUIPMENT INCLUDED UNDER ALTERNATE #3.
 - ELECTRICAL CONTRACTOR TO WIRE CONDENSATE PUMPS FOR EACH UNIT VENTILATOR (UV).

ELECTRICAL KEYED NOTES - MASTER

- E1 COORDINATE PAD MOUNTED TRANSFORMER AND PAD REPLACEMENT WITH SERVING UTILITY AND OWNER PRIOR TO DEMOLITION OF EXISTING TRANSFORMER. EC TO PROVIDE DETAILED INSTALLATION PLAN FOR PAD MOUNTED TRANSFORMER AND PRIMARY FEEDERS AND CONDUIT TO OWNER AND UTILITY INCLUDING PHASING, TEMPORARY POWER PROVISIONS, OUTAGE DURATION AND TESTING. THE INTENT OF THIS WORK IS TO MINIMIZE THE DISRUPTION TO THE SECONDARY FEEDS OF THE TRANSFORMER TO THE EXISTING SWITCHBOARD BY LOCATING THE PAD'S SECONDARY WINDOW OPENING IN A LOCATION THAT REQUIRES MINIMAL REWORK. LOCATION OF TRANSFORMER AND PAD SHOWN ARE TO PROVIDE APPROPRIATE CLEARANCES FROM MAIN DOOR AND BUILDING. COORDINATE WITH UTILITY FOR APPROVAL ON FINAL LOCATION PRIOR TO PAD INSTALLATION.
- E2 EC TO PROVIDE CONCRETE EQUIPMENT PAD SIZED PER UTILITY AND CODE REQUIREMENTS. EC TO ENSURE CONCRETE PAD IS INSTALLED ON STABLE AND LEVEL GRADE, MAINTAINS REQUIRED CLEARANCES, AND TO PROVIDE AND INSTALL BOLLARDS TO PROTECT FROM VEHICLE IMPACT. EC TO PROVIDE OIL CONTAINMENT MOAT AS REQUIRED BY UTILITY. PROVIDE GROUNDING AND BONDING AS REQUIRED BY UTILITY AND NEC. EC TO INSTALL PVC CONDUIT STUB UPS ALIGNED WITH TRANSFORMER CABINET LAYOUT. SEE DETAIL 41E-501 FOR PAD REQUIREMENTS.
- E3 PROVIDE AND INSTALL 1 1/2" CONDUIT FROM SECTION BOARD TO NEW TRANSFORMER WITH 3-#1/0 AL 15KV CONDUCTORS. EXISTING CONDUIT MAY NOT NEED TO BE REPLACED IN ITS ENTIRETY, CONTRACTOR TO FIELD VERIFY CONDITION OF EXISTING CONDUIT AND INTERCEPT AND EXTEND IF ABLE.
- E4 PROVIDE AN ADDRESSABLE MONITOR MODULE TO INTERFACE WITH THE KITCHEN HOOD FIRE SUPPRESSION SYSTEM. UPON ACTIVATION OF THE SUPPRESSION SYSTEM, THE MONITOR MODULE SHALL INITIATE A GENERAL FIRE ALARM CONDITION THROUGH THE FIRE ALARM CONTROL PANEL (FACP). MODULE SHALL BE INSTALLED IN ACCORDANCE WITH NFPA 72 AND MANUFACTURER REQUIREMENTS. COORDINATE WIRING AND TERMINATION REQUIREMENTS WITH THE KITCHEN HOOD SUPPRESSION CONTRACTOR.
- E5 EXISTING RECEPTACLES MOUNTED UNDER HOOD SHALL BE RE-INSTALLED ONCE NEW HOOD IS INSTALLED.
- E6 PROVIDE NEW CONDUIT AND CONDUCTORS TO NEW EXHAUST FANS. SEE MOTOR AND EQUIPMENT SCHEDULE FOR CONDUIT AND CONDUCTOR SIZING. EXISTING HOOD CIRCUITING COULD NOT BE IDENTIFIED BY PANELBOARD SCHEDULE. ELECTRICAL CONTRACTOR SHALL IDENTIFY CIRCUITS FEEDING EXHAUST FANS PRIOR TO DEMOLITION.
- E7 ELECTRICAL CONTRACTOR TO WIRE CONTROL PANEL TO SHUNT TRIP COIL TO SHUT OFF EQUIPMENT UNDER HOOD IN FIRE CONDITION. ELECTRICAL CONTRACTOR TO WIRE CONTROL PANEL TO N.C. CONTACTS OF GAS SOLENOID TO SHUT OFF GAS IN FIRE CONDITION. ELECTRICAL CONTRACTOR TO WIRE CONTROL PANEL TO SUPPLY FANS/MAKE-UP AIR FANS TO SHUT OFF IN FIRE CONDITION. ELECTRICAL CONTRACTOR TO WIRE CONTROL PANEL TO EXHAUST FANS, HOOD LIGHTS, AND TEMPERATURE SENSOR. EXHAUST FANS TO BE WIRED TO UNIT INTERLOCK SO THAT EXHAUST FANS ENERGIZE AUTOMATICALLY WHEN COOKING APPLIANCES ARE IN USE.
- E8 ELECTRICAL CONTRACTOR TO FURNISH AND INSTALL DUCT SMOKE DETECTOR ON THE RETURN AND SUPPLY SIDE OF THE DOAS UNITS AND SUPPLY SIDE OF EACH MAU UNIT. CONNECT NEW DUCT SMOKE DETECTOR TO THE EXISTING FIRE ALARM CONTROL PANEL LOCATED IN ROOM W060 IN THE HIGH SCHOOL.
- E9 ELECTRICAL CONTRACTOR TO FURNISH AND INSTALL DUCT SMOKE DETECTOR TEST RESET SWITCH. CONTRACTOR TO INSTALL (1) DUCT SMOKE DETECTOR TEST RESET SWITCH PER DOAS/MAU UNIT. SEE DETAILS ON SHEETS E-503 AND E-504 FOR POWER, CONTROL AND FIRE ALARM WIRING.
- E10 INSTALL NEW SURFACE-MOUNTED PANEL IN LOCATION SHOWN IN ACCORDANCE WITH NEC AND AHJ REQUIREMENTS. PROVIDE GROUNDING AND BONDING. RECONNECT EXISTING FEEDERS AND BRANCH CIRCUITS AND IDENTIFY ALL CIRCUITS WITH TYPE-WRITTEN DIRECTORIES AND TORQUE ALL CONNECTIONS TO MANUFACTURER'S SPECIFICATIONS. MAINTAIN REQUIRED WORKING CLEARANCES AND HEIGHTS. PROVIDE WIRE GUTTER AND JUNCTION BOXES AS REQUIRED TO EXTEND EXISTING CIRCUITS TO NEW PANEL.
- E11 INSTALL NEW SURFACE-MOUNTED DISTRIBUTION BOARD IN LOCATION SHOWN IN ACCORDANCE WITH NEC AND AHJ REQUIREMENTS. PROVIDE GROUNDING AND BONDING. PROVIDE THREE (3) SETS OF 4-# 300 & 1-# 1/0 CU IN THREE (3) 3" CONDUITS FROM SWITCHBOARD TO NEW DISTRIBUTION BOARD. RECONNECT EXISTING BRANCH CIRCUITS AND IDENTIFY ALL CIRCUITS WITH TYPE-WRITTEN DIRECTORIES. TORQUE ALL CONNECTIONS TO MANUFACTURER'S SPECIFICATIONS. MAINTAIN REQUIRED WORKING CLEARANCES AND HEIGHTS. PROVIDE WIRE GUTTER AND JUNCTION BOXES AS REQUIRED TO EXTEND EXISTING CIRCUITS TO NEW PANEL.

ELECTRICAL DEMO KEYED NOTES - MASTER

- D1 REMOVE AND RE-INSTALL CEILING MOUNTED DEVICES IN THIS AREA. NOTE THAT NOT ALL DEVICES REQUIRING RE-INSTALLATION MAY BE SHOWN. CONTRACTOR TO VERIFY CEILING MOUNTED DEVICES PRIOR TO BIDDING. RE-INSTALL DEVICES AS CLOSE TO ORIGINAL LOCATION AS POSSIBLE.
- D2 EXISTING CEILING AND CEILING MOUNTED DEVICE TO REMAIN. DEMO EXISTING LIGHTING IN THIS ROOM. NEW LIGHTING FIXTURES TO CONNECT TO EXISTING CIRCUITING AND CONTROLS.
- D3 EXISTING STAGE LIGHTING AND ASSOCIATED WIRING TO BE REMOVED AND RE-INSTALLED ONCE CEILING WORK IS COMPLETED.
- D4 EXISTING PAD MOUNTED TRANSFORMER IN DETERIORATED CONDITION AND SHALL BE COMPLETELY REMOVED INCLUDING ALL ASSOCIATED WIRING AND GROUNDING COMPONENTS. THE EXISTING CONCRETE PAD IS UNDERSIZED AND DOES NOT MEET CURRENT UTILITY OR CODE REQUIREMENTS. CONTRACTOR SHALL DEMOLISH AND DISPOSE OF THE EXISTING CONCRETE PAD IN ITS ENTIRETY. EC TO MAINTAIN ALL SAFETY MEASURES AND PROVIDE TEMPORARY PROTECTION, BARRICADES AND REQUIRED NOTICES DURING TRANSFORMER REMOVAL AND PAD REPLACEMENT. EC TO COORDINATE WITH OWNER PRIOR TO ANY DEMOLITION OR TERMINATION OF SERVICE TO BUILDING.
- D5 MECHANICAL EQUIPMENT TO BE DEMOED (DIV 15). DIV 16 TO REMOVE ALL ASSOCIATED WIRING, CONDUIT, BOXES AND DISCONNECTS BACK TO SOURCE. IF UNIT IS BEING REPLACED, AND EXISTING CONDUIT IS IN GOOD CONDITION AND SIZED APPROPRIATELY, EXISTING CONDUIT MAY BE RE-USED FOR NEW CONDUCTORS TO PROPOSED EQUIPMENT.
- D6 REMOVE AND RE-INSTALL EXISTING PROJECTOR AND ASSOCIATED RECEPTACLE.
- D7 DEMO EXISTING SPEAKER. SEE ELECTRICAL PLANS FOR NEW SPEAKER TO BE PROVIDED.
- D8 DEMO EXISTING PANEL. DE-ENERGIZE ALL FEEDERS AND BRANCH CIRCUITS SERVING THE EXISTING FLUSH-MOUNTED PANEL PRIOR TO WORK. COORDINATE OUTAGES WITH OWNER. IDENTIFY, TAG, AND DOCUMENT ALL EXISTING CIRCUITS PRIOR TO DISCONNECTION FOR RECONNECTION TO NEW SURFACE-MOUNTED PANEL. REMOVE EXISTING PANEL, BREAKERS, TRIM, GROUNDING/BONDING, AND ASSOCIATED CONDUITS. REMOVE ABANDONED CONDUCTORS IN COMPLIANCE WITH NEC. MAINTAIN GROUNDING AND BONDING CONTINUITY AND PROTECT ADJACENT SYSTEMS DURING DEMOLITION. PROVIDE TEMPORARY POWER AS REQUIRED. PATCH AND RESTORE WALL SURFACES TO MATCH EXISTING CONDITIONS.

COPPER FEEDER & BRANCH CIRCUIT SCHEDULE

RATING (SEE NOTE A)	PHASE CONDUCTORS & NEUTRAL	EQUIPMENT GROUNDING CONDUCTOR	CONDUIT SIZE FOR 4W	CONDUIT SIZE FOR 2W OR 3W
15	12	12	3/4"	3/4"
20	12	12	3/4"	3/4"
25	10	10	3/4"	3/4"
30	10	10	3/4"	3/4"
35	8	10	1	3/4"
40	8	10	1	3/4"
45	8	10	1	3/4"
50	8	10	1	3/4"
60	6	10	1	1
70	4	8	1 1/4"	1
80	4	8	1 1/4"	1
90	3	8	1 1/4"	1 1/4"
100	3	8	1 1/4"	1 1/4"
110	2	6	1 1/2"	1 1/4"
125	1	6	2"	1 1/2"
150	1/0	6	2"	1 1/2"
175	2/0	6	2"	2"
200	3/0	6	2 1/2"	2"
225	4/0	4	2 1/2"	2 1/2"
250	250 KCMIL	4	3"	2 1/2"
275	300 KCMIL	4	3"	3"
300	350 KCMIL	4	3"	3"
325	400 KCMIL	3	3 1/2"	3 1/2"
350	500 KCMIL	3	3 1/2"	3 1/2"
400	(2) 3/0	(2) 3	(2) 2 1/2"	(2) 2"

- COPPER FEEDER & BRANCH CIRCUIT SCHEDULE NOTES:
- UNLESS SPECIFICALLY NOTED OTHERWISE, THIS SCHEDULE APPLIES TO ALL ONE-LINE DIAGRAMS, PANEL SCHEDULES, AND EQUIPMENT CONNECTIONS SCHEDULES. A FEEDER OR BRANCH CIRCUIT RATING SHALL BE EQUAL TO THE SPECIFIED RATING OF ITS CORRESPONDING OCPD (OVERCURRENT PROTECTION DEVICE), UNLESS SPECIFICALLY NOTED OTHERWISE. RATINGS FOR EQUIPMENT CONNECTIONS SCHEDULES ARE NOTED IN THE "FEEDER RATING" COLUMN. THE TERM "RATING" IS NOT NECESSARILY SYNONYMOUS WITH "CURRENT-CARRYING CAPACITY" AND IS INTENDED SOLELY TO IDENTIFY PARTICULAR FEEDER SPECIFICATIONS.
 - VALUES IN PARENTHESES INDICATE THE QUANTITY OF PARALLEL SETS IN SEPARATE CONDUITS.
 - IF A FEEDER OR BRANCH CIRCUIT RATING EXCEEDS THAT OF IT CORRESPONDING OCPD, THEN ITS EQUIPMENT GROUNDING CONDUCTOR MUST BE INCREASED PROPORTIONALLY CROSS-SECTIONAL AREA TO THAT OF THE PHASE CONDUCTORS. THEREFORE, THE EQUIPMENT GROUNDING CONDUCTOR SIZE INDICATED IN THIS SCHEDULE SHALL APPLY ONLY IF IT IS NOT SPECIFICALLY NOTED OTHERWISE ON THE PLANS, ONE-LINE DIAGRAMS, OR EQUIPMENT CONNECTIONS SCHEDULES.
 - A FEEDER RATING CAN BE SPECIFIED LESS THAN ITS ASSOCIATED OCPD WHEN IT SERVES A MOTOR LOAD WITH DEDICATED OVERLOAD PROTECTION AND ITS BREAKER IS "OVERSIZED" TO ALLOW FOR INCREASED STARTING CAPACITY (IN RUSH CURRENT).
 - WIRE SIZES ARE BASED ON N.E.C. TABLE 310.15(B)(16) FOR COPPER THHN/THWN. 75-DEG C. CONDUIT SIZES ARE BASED ON TABLES IN N.E.C. "ANNEX C" THAT ARE APPLICABLE FOR RACEWAY TYPES SPECIFIED UNDER SECTION 2605.33 "RACEWAY AND BOXES FOR ELECTRICAL SYSTEMS".

LIGHTING SCHEDULE													
TAG	SYMBOL	MANUFACTURER	MODEL NUMBER	DESCRIPTION	MOUNTING	TOTAL LUMENS	CCT	CRI	VOLTAGE	WATTS	EMERGENCY COMPONENT	NOTES	APPROVED EQUALS
HB1	■	KEYSTONE	KT-HBLEDD215PS-2C-OSC-8C-SD-VDIM-P/WG	HIGH BAY	CEILING 22'	30500 lm	40 K	80	120 V	215 W		1	
L1	—	KEYSTONE	KT-MSLED54-8-835-VDIM-P/LSM	8' LINEAR	CEILING	7100 lm	35 K	80	120 V	54 W		2	
S1	■	HE WILLIMAS	NLV-L-L7/840-O-WHT-DRV-UNV	GYM WALL LIGHT	WALL 9'	700 lm	40 K	80	120 V	15 W			
T1	■	KEYSTONE	KT-BPLED50PS-24-8CSA-VDIM	2X4 LED FLAT PANEL	CEILING	5600 lm	35 K	80	120 V	50 W			
T2	■	KEYSTONE	KT-BPLED35PS-14C-8CSA-VDIM/G2	1X4 LED FLAT PANEL	CEILING	4000 lm	35 K	80	120 V	35 W			


NOTES:
1. PROVIDE WITH KT-HBLEDD-CABLE-1B-KIT CABLE MOUNT IT
2. PROVIDE WITH KT-MSLED-VH-KIT V-HOOK AND CHAIN KIT & ALL REQUIRED BRACKETS

SENSOR SCHEDULE						
TAG	DESCRIPTION	COVERAGE TYPE	MOUNTING	DETECTION TECHNOLOGY	MODEL #	MANUFACTURER
DL	CEILING MOUNT PHOTO SENSOR	N/A	CEILING	PHOTOCELL	LMLS-500	WATTSTOPPER
OS1	OCCUPANCY SENSOR	STANDARD	CEILING	PDT	LMDC-100	WATTSTOPPER
OS2	OCCUPANCY SENSOR - HIGH MOUNT	HIGH MOUNT	CEILING	PIR	NCM-6-30M	ACUITY
RC1	DUAL RELAY ROOM CONTROLLER	N/A	CEILING/WALL	N/A	LMRC-212	WATTSTOPPER
RC2	DUAL RELAY ROOM CONTROLLER	N/A	CEILING/WALL	N/A	LMRC-101	WATTSTOPPER

SWITCH SCHEDULE			
TAG	DESCRIPTION	BASIS OF DESIGN	MANUFACTURER
1	ON/OFF	LMSW-210	WATTSTOPPER
2	ON/OFF WITH DIMMING	LMSW-211	WATTSTOPPER
3	ON/OFF (TWO ZONES)	LMSW-220	WATTSTOPPER
4	OCCUPANCY SENSOR WITH DIMMING	CS-50	WATTSTOPPER

LIGHTING CONTROL SEQUENCE OF OPERATION								
OPERATION SEQUENCE	ROOM TYPE	TIME DELAY	LIGHTING SEQUENCE				RECEPTACLE SEQUENCE	DESCRIPTION
			POWER ON	POWER OFF	DAY LIGHT CONTROLS	DAYLIGHT SET POINT (FC)		
1	WOOD SHOP/KITCHEN	N/A	MANUAL SWITCH	MANUAL SWITCH	N/A		N/A	MANUAL ON MANUAL OFF
2	CORRIDOR	N/A	OCCUPANCY SENSOR	OCCUPANCY SENSOR	N/A		N/A	AUTO-ON BY OCCUPANCY SENSOR. AUTO-OFF BY OCCUPANCY SENSOR.
3	CLASSROOM	20 MIN.	MANUAL SWITCH	MANUAL SWITCH/OCCUPANCY SENSOR	N/A		N/A	LIGHTING IS CONTROLLED VIA VACANCY SENSING, FIXTURES ARE SPLIT INTO TWO ZONES AND FULLY DIMMABLE FROM THE WALL SWITCHES.
4	GYMNASIUM	20 MIN.	OCCUPANCY SENSOR	MANUAL SWITCH/OCCUPANCY SENSOR	N/A		N/A	LIGHTS CONTROLLED THROUGH EXISTING N LIGHT RELAY PANELS. PROVIDE NEW OCCUPANCY SENSORS. AUTO-ON VIA OCCUPANCY SENSOR OR SWITCH, AUTO-OFF VIA OCCUPANCY SENSOR OR SWITCH.
5	LOCKER ROOM	20 MIN.	OCCUPANCY SENSOR	MANUAL SWITCH/OCCUPANCY SENSOR	N/A		N/A	AUTO ON BY OCCUPANCY SENSOR, AUTO OFF BY OCCUPANCY SENSOR
6	CAFETERIA W/ DAYLIGHTING	20 MIN.	OCCUPANCY SENSOR	MANUAL SWITCH/OCCUPANCY SENSOR	PHOTOSENSOR TO AUTOMATICALLY DIM FIXTURES TO LIGHT LEVEL SET POINT INDICATED	45	N/A	LIGHTING IS CONTROLLED VIA VACANCY SENSING. PROVIDE WALL SWITCHES FOR MANUAL CONTROL OF FIXTURES. FIXTURES ARE SPLIT INTO TWO ZONES AND CONTROLLED VIA TWO-BUTTON SWITCHES, EACH BUTTON CONTROLLING A ZONE, NEAR EACH ENTRANCE TO THE ROOM. DAYLIGHTING FIXTURES SERVING THE DESIGNATED PORTION OF THE CAFETERIA SHALL BE CONTROLLED BY A DAYLIGHTING SENSOR WITH 0-10V DIMMING.
7	AUDITORIUM	N/A	MANUAL SWITCH	MANUAL SWITCH	N/A		N/A	AUDITORIUM LIGHTING IS CONTROLLED BY TWO EXISTING LUTRON GRAFIK EYE INTERFACES WITH DIMMERS LOCATED AT THE STAGE AND IN THE SOUND BOOTH. PROVIDE NEW CONTROL WIRING TO DIVIDE THE HOUSE LIGHTING INTO TWO ZONES. REFER TO SHEET E-1108 FOR ZONES.
8	STORAGE/SM RESTROOM	20 MIN.	MANUAL SWITCH/OCCUPANCY SENSOR	MANUAL SWITCH/OCCUPANCY SENSOR	N/A	N/A	N/A	LIGHTING IS CONTROLLED BY VACANCY SENSING. AUTO OFF BY OCCUPANCY SENSOR OR MANUAL OFF BY WALL SWITCH.
9	ADMIN	20 MIN.	MANUAL SWITCH	MANUAL SWITCH/OCCUPANCY SENSOR	N/A	45		LIGHTING IS CONTROLLED BY VACANCY SENSING, FIXTURES ARE FULLY DIMMABLE FROM THE WALL SWITCH

ELECTRICAL CONTRACTOR SHALL PROVIDE NEW CONTROL WIRING FOR ROOMS WITH LV LIGHTING CONTROLS. REFER TO MANUFACTURER'S INSTALLATION MANUAL FOR WIRING REQUIRED.

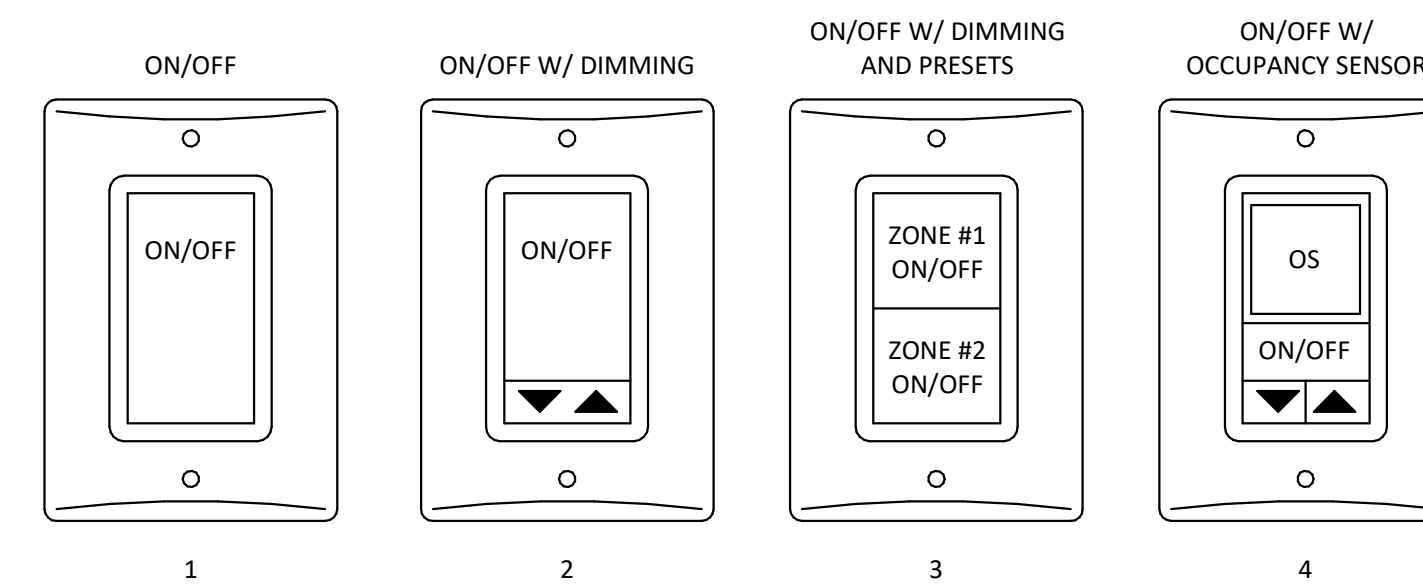

LIGHT SWITCH ID DETAIL 1
NTS E-602

ISSUED FOR

BIDDING

DATE 02/20/2026

DESCRIPTION DATE

ADDENDUM 01 03-02-2026

DRAWN BY SMF

CHECKED BY KDM

PROJECT NO. 9166-10000

SHEET NAME

LIGHTING SCHEDULES

Switchboard: SWBD

Location: MECHANICAL M119
Supply: PAD MOUNT
Mounting: SURFACE
Enclosure: NEMA 1

Voltage: 208 V, 3Ø, 4W
Bus Rating: 2000 A
Neutral: 100%
Feed-Thru Lugs: No
Features & Modifications:

Mains Type: MCCB
Mains Rating: 2000 A
Mains FN/Note: -
SCCR: 35 kA

Ckt	Description	Frame	Trip (A)	Poles	FN/Note	Phase A...	Phase B...	Phase C...	FN/Note	Poles	Trip (A)	Frame	Description	Ckt
1						0	0						HUB ROOM PANEL	2
3	SHOP PANEL	400 A	400	3	E					E	3	200	200 A	4
5								0	0					6
7														8
9	PANEL HB	400 A	400	3	E					E	3	60	125 A	10
11														12
13	GREEN ROOM PANEL	400 A	200	3	E	0	73038			NB	3	800	800 A	14
15								0	73038					16
17														18
19	KITCHEN NORMAL	200 A	200	3	E					E	3	60	125 A	20
21														22
23														24
25	PANEL HA	200 A	200	3	E	0	22924			NB	3	225	225 A	26
27								0	24393					28
29														30
31														32
33	PANEL HI	200 A	200	3	E									34
35														36
37														38
39	PANEL HD	200 A	200	3	E									40
41														42
43														44
45	PANEL HG	200 A	200	3	E									46
47														48
49														50
51	L10	225 A	225	3	E					E	3	225	250 A	52
53														54
55														56
57	TRANSFER SWITCH	400 A	400	3	E									58
59														60
61														62
63										E	3	200	250 A	64
65														66
67														68
69										E	3	200	250 A	70
71														72
73														74
75										E	3	100	150 A	76
77														78
79														80
81										E	3	200	250 A	82
83														84

Connected Load: 96 kVA
Connected Current: 804 A

Factor: 100.00%
Demand: 285345 VA

Panel Totals
Connected Load: 286 kVA
Connected Current: 793 A
Demand Load: 286 kVA
Demand Current: 793 A

Load Classification	Connected	Factor	Demand
Other	285345 VA	100.00%	285345 VA
Receptacle - General	540 VA	100.00%	540 VA

Notes:

Panelboard: HJ

Location: STORAGE 213
Supply: SWBD
Mounting: Surface
Enclosure: NEMA 1

Voltage: 208 V, 3Ø, 4W
Bus Rating: 225 A
Neutral: 100%
Feed-Thru Lugs: No
Features & Modifications:

Mains Type: MCCB
Mains Rating: 225 A
Mains FN/Note: -
SCCR: 10 kA

Ckt	Description	Frame	Trip (A)	Poles	FN/Note	Phase A...	Phase B...	Phase C...	FN/Note	Poles	Trip (A)	Description	Ckt
1	CU-1 / BB-1 / UV-#	70	2			4939	3865			2	50	CU-2 / UV-#	2
3						4939	3865						4
5	ADMIN EXTERIOR WP RECPT	20	1			4035	3804			2	50	CU-3 / UV-#	6
7													8
9	DOAS-6	50	3			4035	328			1	20	DOAS RECPT & UV LTS	10
11													12
13	EF-1	15	1			36	6245			3	70	DH-3	14
15	CU-4 / BB-2 / UV-#	70	2			4992	6245						16
17													18
19													20
21													22
23													24
25													26
27													28
29													30
31													32
33													34
35													36
37													38
39													40
41													42

Connected Load: 23 kVA
Connected Current: 196 A

Factor: 100.00%
Demand: 66231 VA

Panel Totals
Connected Load: 67 kVA
Connected Current: 185 A
Demand Load: 67 kVA
Demand Current: 185 A

Load Classification	Connected	Factor	Demand
Other	66231 VA	100.00%	66231 VA
Receptacle - General	540 VA	100.00%	540 VA

Notes:

Panelboard: L11 (KITCHEN GENERATOR)

Location: DRY STORAGE M107E
Supply: Surface
Mounting: Surface
Enclosure: NEMA 1

Voltage: 208 V, 3Ø, 4W
Bus Rating: 225 A
Neutral: 100%
Feed-Thru Lugs: No
Features & Modifications:

Mains Type: MCCB
Mains Rating: 225 A
Mains FN/Note: -
SCCR: 10 kA

Ckt	Description	Frame	Trip (A)	Poles	FN/Note	Phase A...	Phase B...	Phase C...	FN/Note	Poles	Trip (A)	Description	Ckt	
1						0	0						2	
3	BOOSTER HEATER	90	3	E						E	3	70	DISHWASHER	4
5								0	0					6
7														8
9	FE-1	20	2	NB,L		1425	3206			E	3	50	FC-2	10
11														12
13	FE-2	20	2	NB,L		1425	0			E	2	25	DRYER	14
15								1717	0					16
17	CC-1	25	3	NB						E	2	25	PARKING LOT POLES SOUTH	18
19								1717	0					20
21	FREEZER LIGHTS	20	1	E						E	1	20	COOLER LIGHTS	22
23	FREEZER CONTROLS & DOOR HEATER	20	1	E						E,L	1	20	CE-1	24
25										E	1	20	COOLER CONTROL & DOOR HEATER	26
27										E	1	20	CONTROLS	28
29										R	1	20	WASHER	30

Connected Load: 8 kVA
Connected Current: 67 A

Factor: 100.00%
Demand: 22198 VA

Panel Totals
Connected Load: 22 kVA
Connected Current: 62 A
Demand Load: 22 kVA
Demand Current: 62 A

Load Classification	Connected	Factor	Demand
Other	22198 VA	100.00%	22198 VA

Notes:

Panelboard: K-1

Location: DRY STORAGE M107E
Supply: Surface
Mounting: Surface
Enclosure: NEMA 1

Voltage: 208 V, 3Ø, 4W
Bus Rating: 225 A
Neutral: 100%
Feed-Thru Lugs: No
Features & Modifications:

Mains Type: MCCB
Mains Rating: 225 A
Mains FN/Note: -
SCCR: 10 kA

Ckt	Description	Frame	Trip (A)	Poles	FN/Note	Phase A...	Phase B...	Phase C...	FN/Note	Poles	Trip (A)	Description	Ckt	
1						0	0						2	
3	EXISTING	15	3	E						E	3	15	MIXER	4
5														6
7														8
9	DOAS-5	70	3	NB		5944	0			E	3	15	EXISTING	10
11														12
13	EXISTING	20	1	N		1044	--			E	1	--	SPACE	14
15	EXISTING	20	1	N			1044	0		E	1	20	WEST WALL RECPTS.	16
17	EXISTING	20	1	E						E	1	20	SPARE	18
19														20
21	EXISTING	20	2	E				0	1044	N	1	20	SPARE KEF-3	22
23	NORTH RECPT CENTER WALL TOP...	20	1	E						E	1	20	EXISTING	24
25	WEST RECPT NORTH WALL BOTTO...	20	1	E						E	3	40	STEAMER	26
27	SOUTH RECPT CENTER WALL	20	1	E						E	1	20	EXISTING	28
29														30
31	EXISTING	20	3	E						E	1	20	NORTH RECPT UNDER HOOD	32
33										E	1	20	EXISTING	34
35	CENTER RECPT EAST WALL	20	1	E						E	1	20	NORTH GFCI	36
37	SOUTH RECPT EAST WALL	20	1	E						E	1	20	NORTH OUTLET HOOD	38
39	NORTH RECPT EAST WALL	20	1	E						E	1	20	EAST REFRIGERATOR	40
41										E	1	20	EXISTING	42
43	SOUTH DISPOSER	15	3	E						E	1	20	NORTH OUTLET UNDER HOOD	44
45										E	1	20	NORTH OUTLET ABOVE HOOD	46
47	DOAS RECPT & LTS	20	1	NB						E	1	20	EXISTING	48
49										E	1	20	EXISTING	50
51	MAU-1	20	2	NB		1040	0			E	1	20	NEW HOOD FAN/LIGHT	52
53	EXISTING	20	1	E						E	1	20	NORTH GFCI	54
55	EAST ROOM CEILING LIGHTS	20	1	E						E	1	20	EXISTING	56
57	NORTH REFRIGERATOR	20	1	E						E	1	20	EXISTING	58
59	SOUTH REFRIGERATOR	20	1	E						E	1	20	EXISTING	60
61	POTATO PEELER	20	1	E						E	1	20	EXISTING	62
63	SOUTH SIDE VENT FAN	20	1	E						E	1	20	KITCHEN LIGHTS	64
65	WEST RECPT MILK COOLER	20	1	E						E	1	20	WEST ROOM FLUORESCENT LIGHTS	66
67	FAN & BATH LIGHTS & RECPT	20	1	E						E	1	20	EAST ROOM CEILING LIGHTS	68
69	EXISTING	20	1	E						E	1	20	EXISTING	70
71	SOUTH WALL EAST RECPT	20	1	E						E	2	20	EXISTING	72
73	HEATER	20	1	E		0	718			NB</				

PROVIDE NEW TYPE-WRITTEN CIRCUIT DIRECTORIES TO INCLUDE NEW LOADS FOR ALL PANELBOARDS

MIDDLE SCHOOL HVAC UPGRADE

1059 3RD AVE NW, WAUKON, IA 52172

ALLAMAKEE CSD

ISSUED FOR
BIDDING

DATE	02/20/2026
DESCRIPTION	DATE
ADDENDUM 01	03-02-2026

DRAWN BY	DMS
CHECKED BY	KDM
PROJECT NO.	9166-10000
SHEET NAME	

ELECTRICAL PANEL SCHEDULES - PHOTOS

NOT FOR CONSTRUCTION




REMOVE EXISTING 30A/3P BREAKER
PROVIDE NEW 70A/3P BREAKER FOR DH-4

HE PANEL 7
NTS E-605



ADD

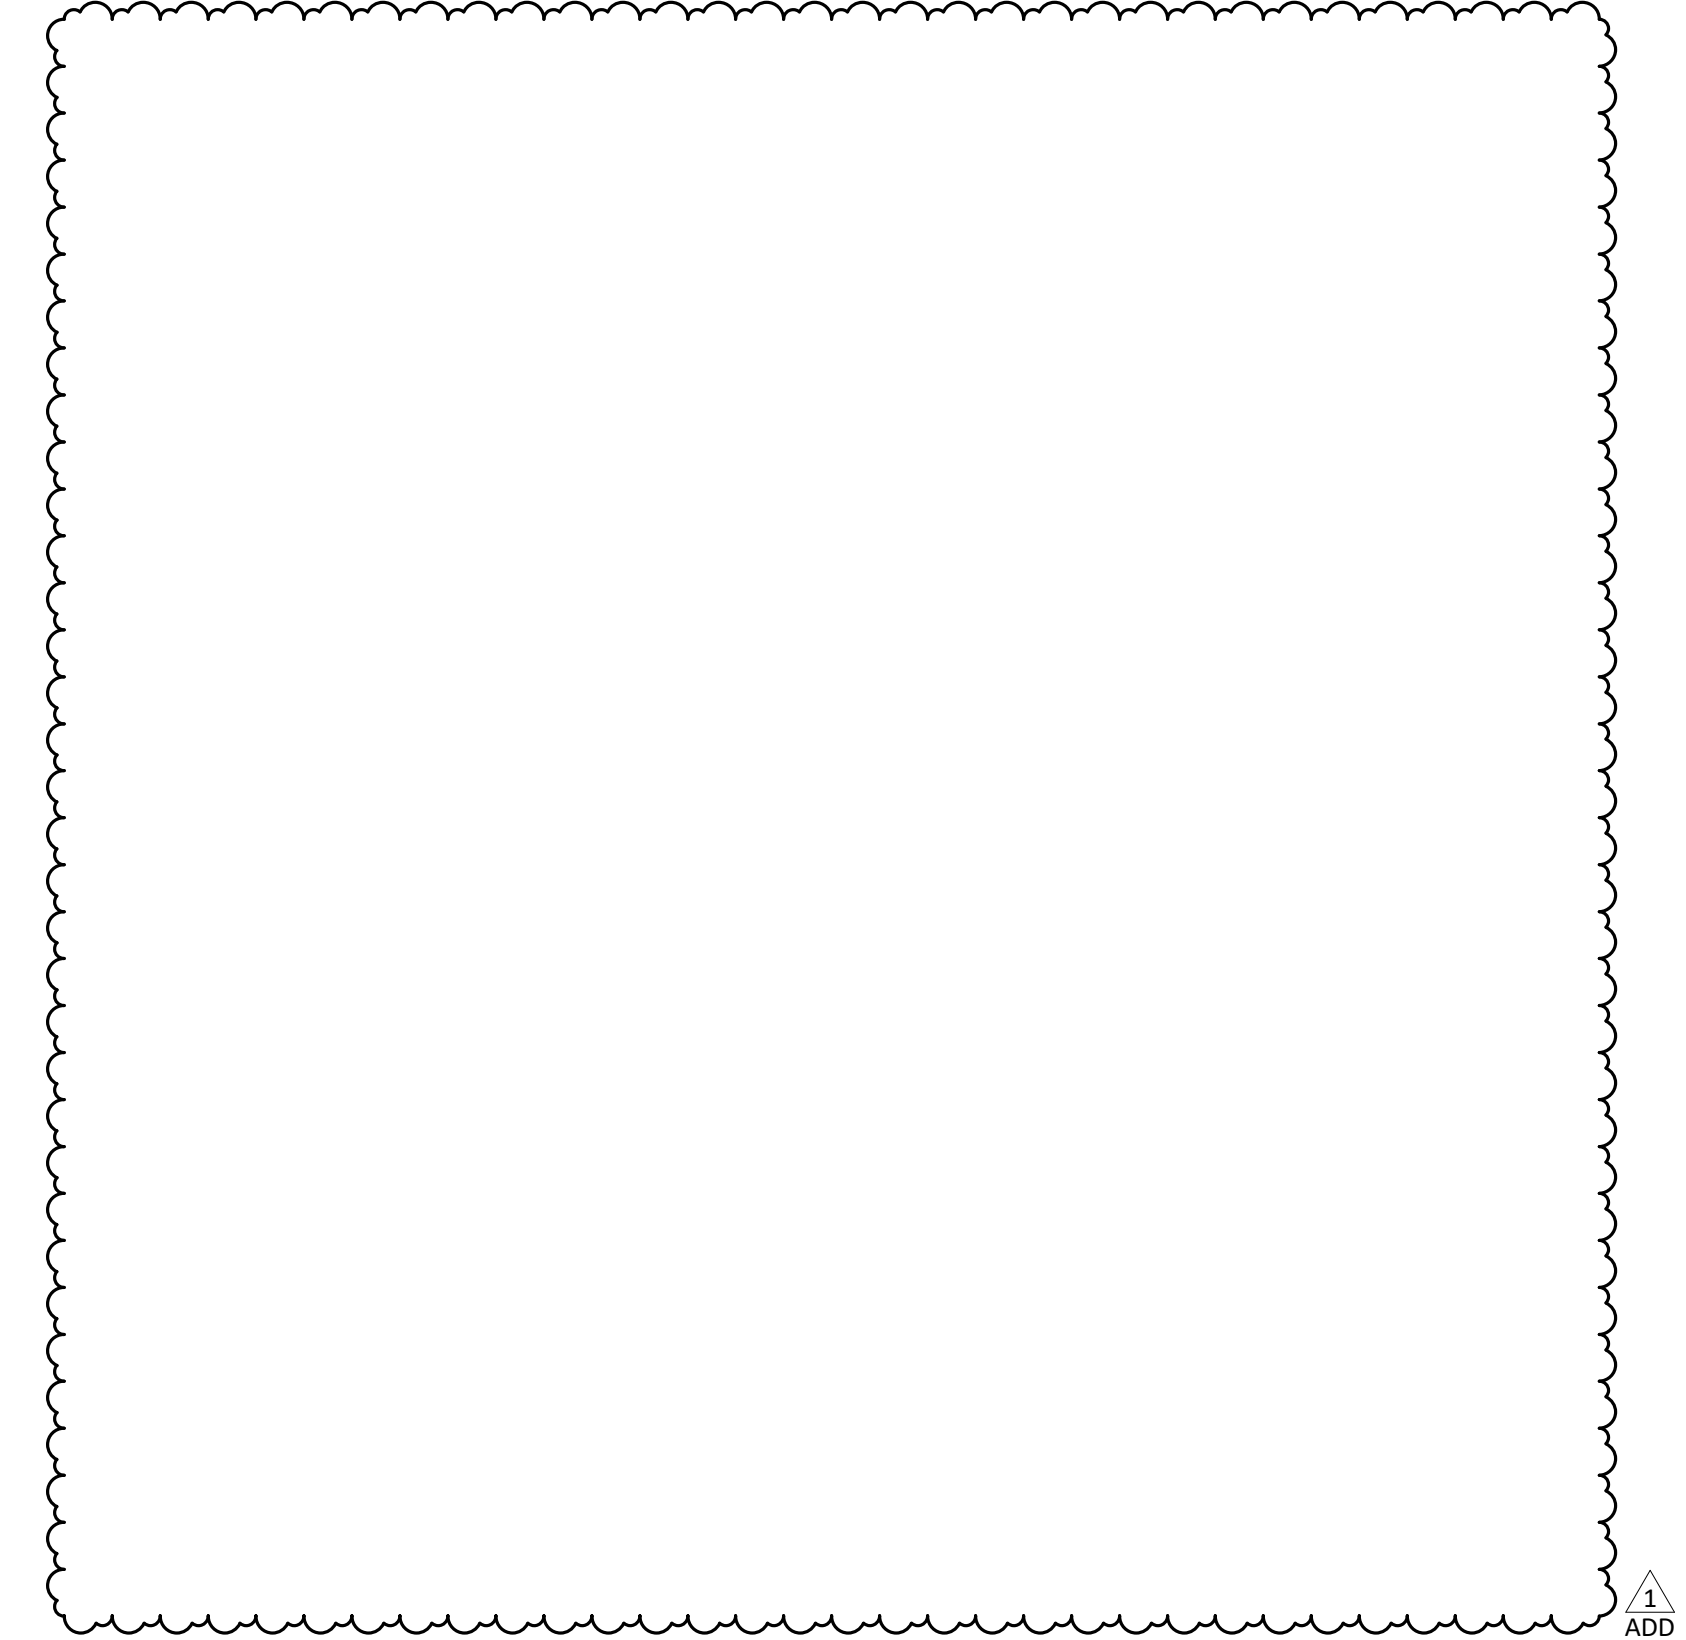

ADD



DOAS-3 LIGHTS AND RECPT

DOAS-4 LIGHTS AND RECPT


REMOVE EXISTING BREAKERS
PROVIDE NEW 70A/3P BREAKER
IN OPEN SPACE TO SERVE DH-3

STAGE PANEL 6
NTS E-605




PROVIDE NEW 15A/1P
BREAKER FOR EF-3

HD PANEL 5
NTS E-605

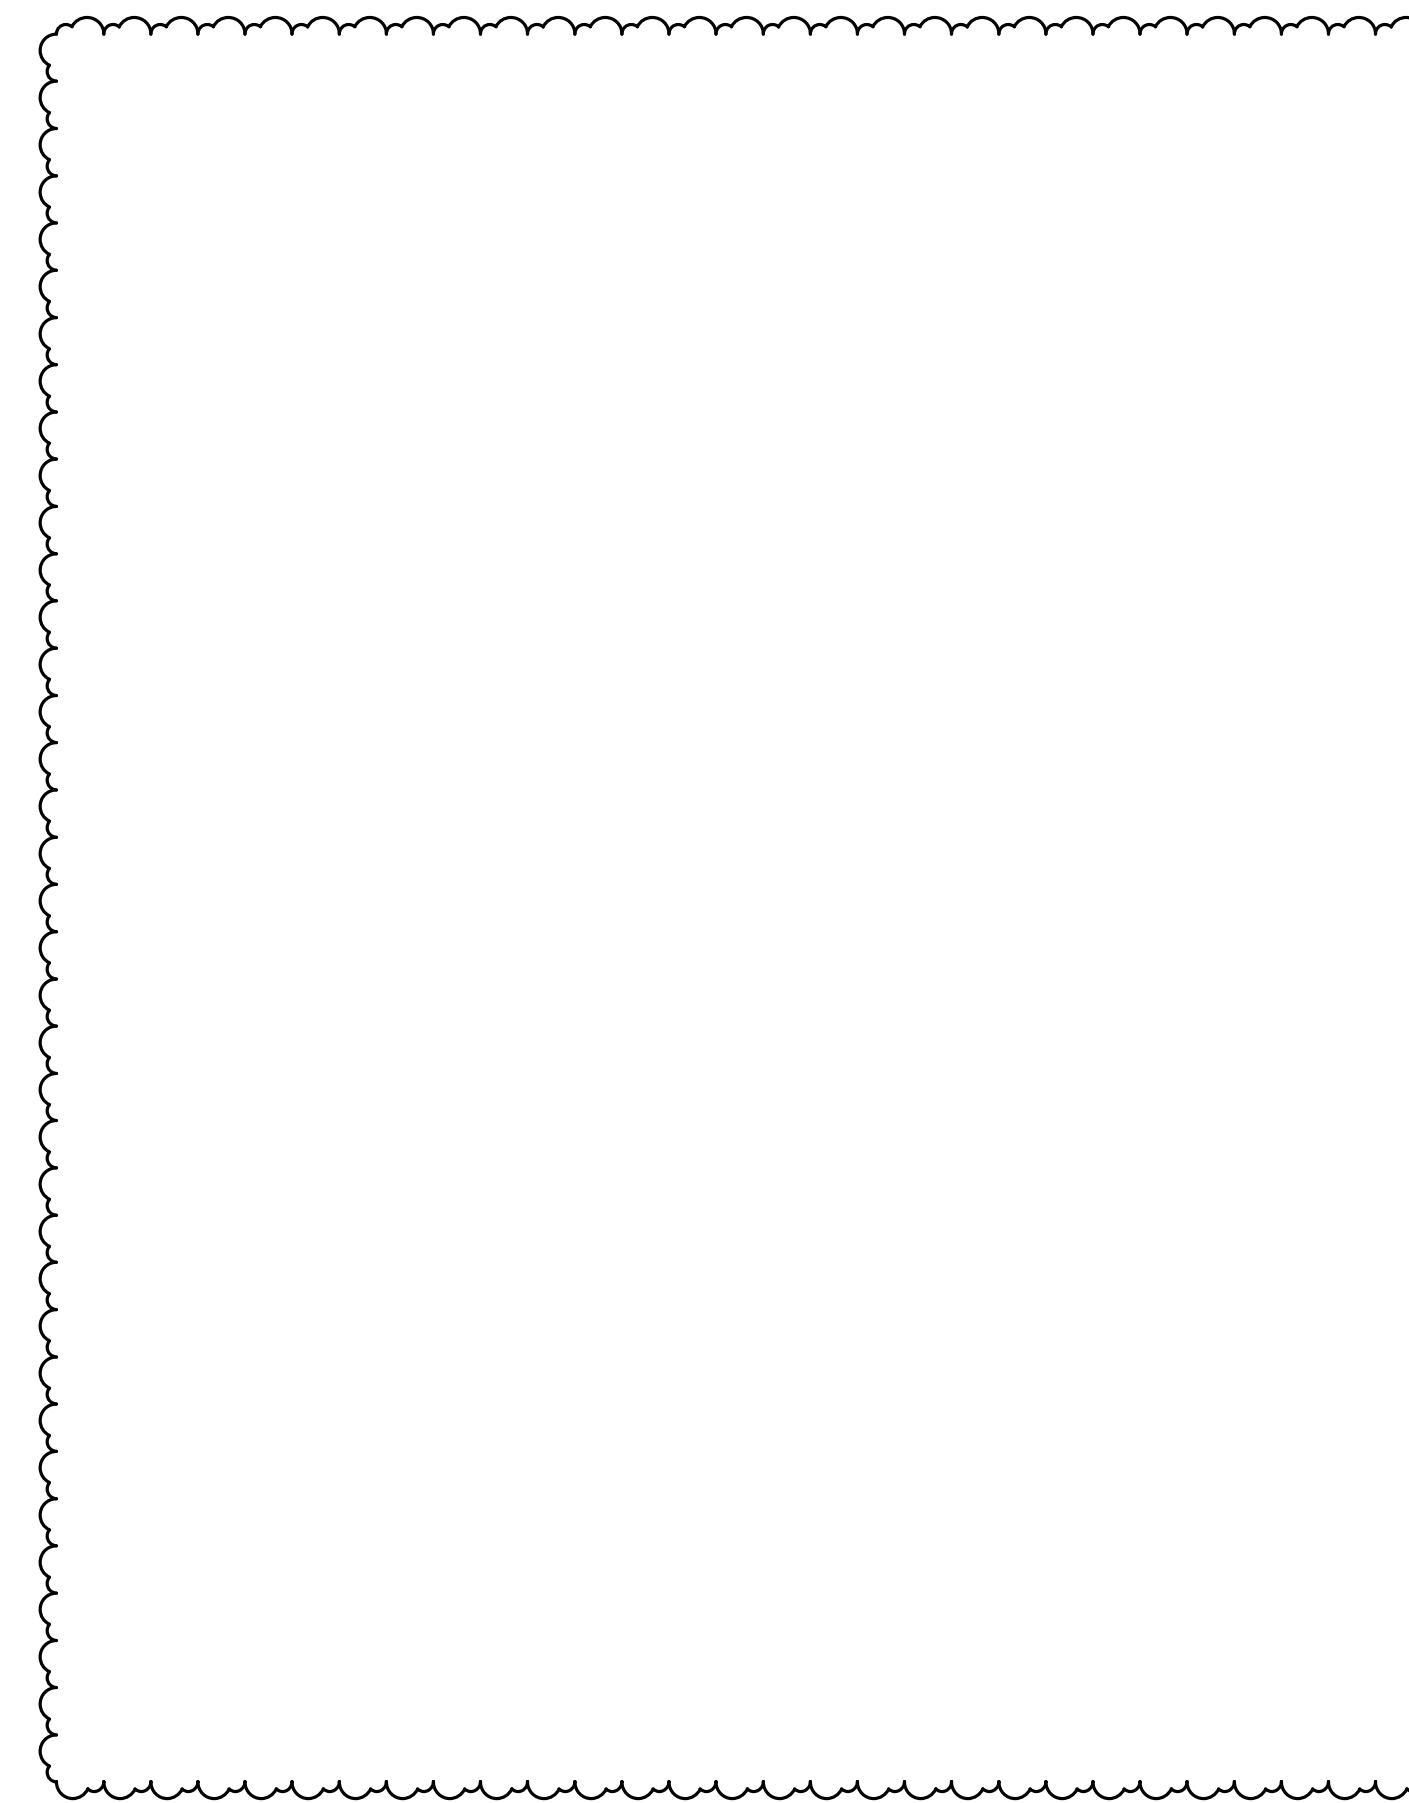

ADD

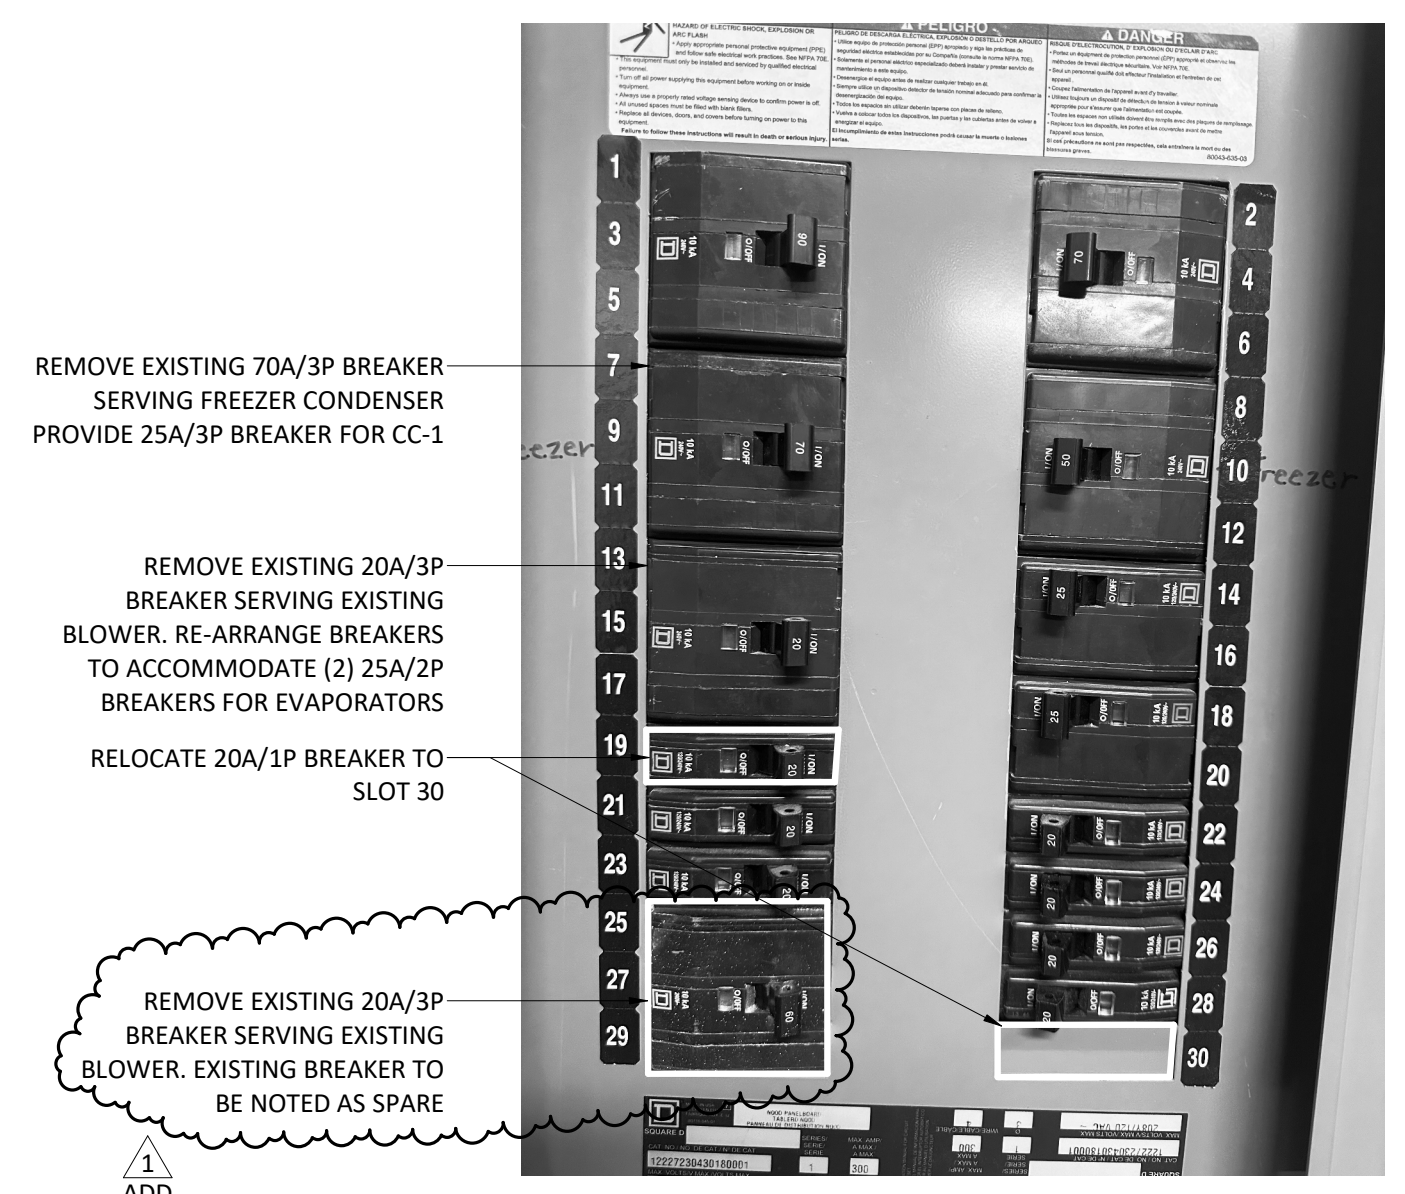

REMOVE EXISTING 70A/3P BREAKER
SERVING FREEZER CONDENSER
PROVIDE 25A/3P BREAKER FOR CC-1

REMOVE EXISTING 20A/3P
BREAKER SERVING EXISTING
BLOWER. RE-ARRANGE BREAKERS
TO ACCOMMODATE (2) 25A/2P
BREAKERS FOR EVAPORATORS

RELOCATE 20A/1P BREAKER TO
SLOT 30

REMOVE EXISTING 20A/3P
BREAKER SERVING EXISTING
BLOWER. EXISTING BREAKER TO
BE NOTED AS SPARE

ADD

HP L11 (KITCHEN GENERATOR) 1
NTS E-605

Axiom Consultants # 9166-10000 - Allamakee CSD - Middle School HVAC Upgrades

The Allamakee Community School District Middle School HVAC Upgrades Project shall consist of providing ductless mini-split heat pump / air conditioning systems, hot water pumps, dedicated outside air units, kitchen air handling units, dining room air handling unit, terminal heating units, control valves, test and balancing, individual room heating and cooling units, ducted air distribution systems, control system upgrades, electrical system upgrades, new ceilings, new lights, incidental fire alarm modifications, incidental plumbing system modifications, incidental painting, flooring, incidental sprinkler protection, walk-in cooler and freezer cooling equipment, new primary electrical transformer, ventilation units for High School and Middle School locker room areas, and replacement windows under the base bid work to in the Waukon Middle School. Also included in the Waukon Middle School base bid work are demolition of specified components and removal, off site storage, and return of movable items to make way for asbestos removal and project construction. Alternate work shall include new windows and exterior wall work at East Elementary School, Middle School humidification systems, and the total remodeling of the Middle School Auditorium and Stage systems, and associated architectural component changes. Alternates for work shall include new heating for the East Elementary School stage, new stage curtains for East Elementary School and Middle School Auditorium stages, replacement windows, and replacement flooring materials at East Elementary School. All work is within the city limits of Waukon, Iowa. All project work shall be substantially complete by November 30, 2026. All contract work must be completed by December 31, 2026.

Plan Holders

Date	Company	Contact	Bid Categories
2/23/26 9:20 am	03/2023 42617 County Road 12, Dakota, MN 55925 Dakota, MN 55925	Landon Jorgenson Managing Member Tel: 5074591896 landon@fpsprinklers.com	Fire Protection
2/20/26 4:25 pm	A&J Associates 206 North Point Ln Dallas Center, IA 50063	Victor Amoroso Tel: 319-333-9955 amorosovic@ajengineers.net	Architect/Engineer
2/20/26 4:27 pm	Air Control Products, Inc 8230 Hickman Road Clive, IA 50325	Linda Albrecht President Tel: 515-271-5994 Fax: 515-274-2641 lindaa@aircntrl.com	HVAC
2/23/26 10:41 am	Allamakee CSD 1059 3rd Ave. NW Waukon, IA 52172	Jay Mathis jmathis@allamakee.k12.ia.us	

Date	Company	Contact	Bid Categories
2/23/26 9:17 am	American Fence Company 15225 Industrial Rd Omaha, NE 68144	Dave Birge Lead Generation Tel: (531) 329-4400 x269 Fax: 402-896-9730 leadgeneration@americafence.com	Fencing
2/20/26 4:23 pm	Axiom Consultants 300 S. Clinton Unit 200 Iowa City, IA 52240	Joe Lomheim Tel: 7124905553 jlomheim@axiom-con.com	Architect/Engineer
2/23/26 12:39 pm	Blackridge Research & consulting 4041 w Hollow Creek Drive Peoria, IL 61615	Venkatesh Siva Tel: 9179937467 venkatesh@blackridgeresearch.com	General/Prime
2/23/26 9:14 am	Blake Electric, Inc. PO BOX 171 Waukon, IA 52172	John Blake Tel: 563-568-3686 john@blakeelectricinc.com	Electrical
2/21/26 10:17 am	Casper Plumbing & Heating 804 Pole Line Rd Decorah, 52101	Randy Voigt Tel: 563-382-0642 Fax: 563-382-0503 rvoigt@casperdecorah.com	General/Prime HVAC Plumbing
2/24/26 8:26 am	Crescent Electric Supply 1225 26th Ave Court SW Cedar Rapids, IA 52404	William Reiter Quotations Tel: 563-583-6411 Fax: 319-866-4536 wjreit@cesco.com	Electrical
2/20/26 4:25 pm	Design Dynamics, Inc. 1500 2nd Ave SE Suite 212 Cedar Rapids, IA 52403	Robert Peck Tel: 319-298-0400 robertp@designdynamics.biz	
2/22/26 2:15 pm	Dodge Data Analytics 2860 S Stage Hwy 161 Ste 160 #501 Grand Prairie, TX	Jayalakshmi L Tel: 4133767032 jayalakshmil@construction.com	Other
2/24/26 5:44 pm	HYDRONIC ENERGY 3307 104TH STREET Des Moines, IA 50322	Rick Kapustka Tel: 5152764935 rick@hydronicenergy.com	Supplier
2/23/26 8:47 am	LaCrosse Builders Exchange 427 Gillette St LaCrosse, 54603	Room Plan Tel: 608-781-1819 Fax: 608-781-1718 planroom@laxbx.com	Planroom

Date	Company	Contact	Bid Categories
2/23/26 2:18 pm	Master Builders of Iowa 221 Park Street Des Moines, IA 50309	Cindy Adams Project Information Specialist Tel: 515-288-7339 Fax: 515-288-8718 mbiplanroom-dsm@mbionline.com	Planroom
2/26/26 2:24 pm	Matt Construction, Inc. 203 Y Avenue Sumner, IA 50674	Megan Matt-Callahan Project Manager Tel: 3194296476 Fax: 563-578-5791 megan.mattconstruction@gmail.com	General/Prime
2/23/26 7:25 am	Minnesota Builders Exchange 1123 Glenwood Minneapolis, MN 55405	Jeff Boelter Tel: 612-381-2620 mbex1123@gmail.com	Planroom
2/23/26 10:42 am	Olympic Builders General Contractors, Inc. 405 North Star Road Holmen, WI 54636	Cindy Broer Office Assistant Tel: 608-526-4622 Fax: 608-526-4690 office@olympicbuildersgc.com	General/Prime
2/25/26 9:27 am	Omaha Builders Exchange 4159 S. 94th St Omaha, NE 68127	Lisa Shockey Tel: 402-991-6906 Fax: 402-884-7055 lisa.shockey@omahaplanroom.com	Planroom
2/23/26 9:43 am	PERRY NOVAK ELECTRIC INC. 2727 LOCUST ROAD DECORAH, IA 52101	Brent Freilinger General Manager Tel: 563-382-2179 Fax: 563-382-9877 brent@pne.us	Electrical
3/2/26 8:18 am	Personified Inc 326 W 17th St Waterloo, IA 50702	Chris Jessen Estimator/Project Coordinator Tel: 319-232-3369 Fax: 319-232-5870 chris@personifiedpmi.com	Insulation Mechanical
2/20/26 4:23 pm	Rapids Reproductions, Inc. 415 Highland Avenue Suite 100 Iowa City, IA 52240	Iowa City Repro Project Reprographer Tel: 319-354-5950 Fax: 319-354-8973 iowacity@rapidsrepro.com	
2/23/26 3:21 pm	Republic Electric Company 737 Charlotte Street Davenport, IA 52803	Michael Beninga Territory Manager Tel: 319-415-7113 beningam@republicco.com	Electrical

Date	Company	Contact	Bid Categories
2/23/26 9:19 am	SEE Electric 2337 Shag Bark Lane Road Decorah, IA 52101	Don Van Duyn Tel: 563-382-6116 Fax: 563-382-4133 info@seeelectric.com	Electrical
2/24/26 10:37 am	Setpoint Mechanical 8951 Thomas Ave Johnston, IA 50131	Isaac Anderson Air Distribution Specialist Tel: 5157837124 isaac@setpointmech.com	HVAC
3/1/26 8:55 pm	Trane 4801 Grand Avenue Davenport, IA 52807	Trane Bids Iowa Tel: 5634684910 tranebidsiowa@trane.com	HVAC
2/24/26 9:37 am	Tricon Construction Group 1230 East 12th St Dubuque, IA 52001	Tricon Estimator Tel: 563-588-9516 Fax: 563-588-9519 tricon@triconcg.com	General/Prime
2/23/26 10:54 am	VHF Sales Inc 2655 SE Enterprise Dr Grimes, IA 50111	Michael Skallerud Engineering and Sales Tel: 515-986-3671 Fax: 515-986-2564 mike@vhfsales.com	HVAC
2/23/26 10:44 am	winona controls 108 bitten st caledonia, MN 55921	Adam Augedahl Tel: 5074500173 adam@winonacontrols.com	HVAC